


C.A. HUGHES & CO.
HUGHES NO. 2 & LILLY NO. 3 MINES
THE
B in LOWER KITTINGING SEAM
WITH ADJACENT MINES AND PROPERTIES
SCALE 1" = 1 MILE
DRAWN TO ORDER

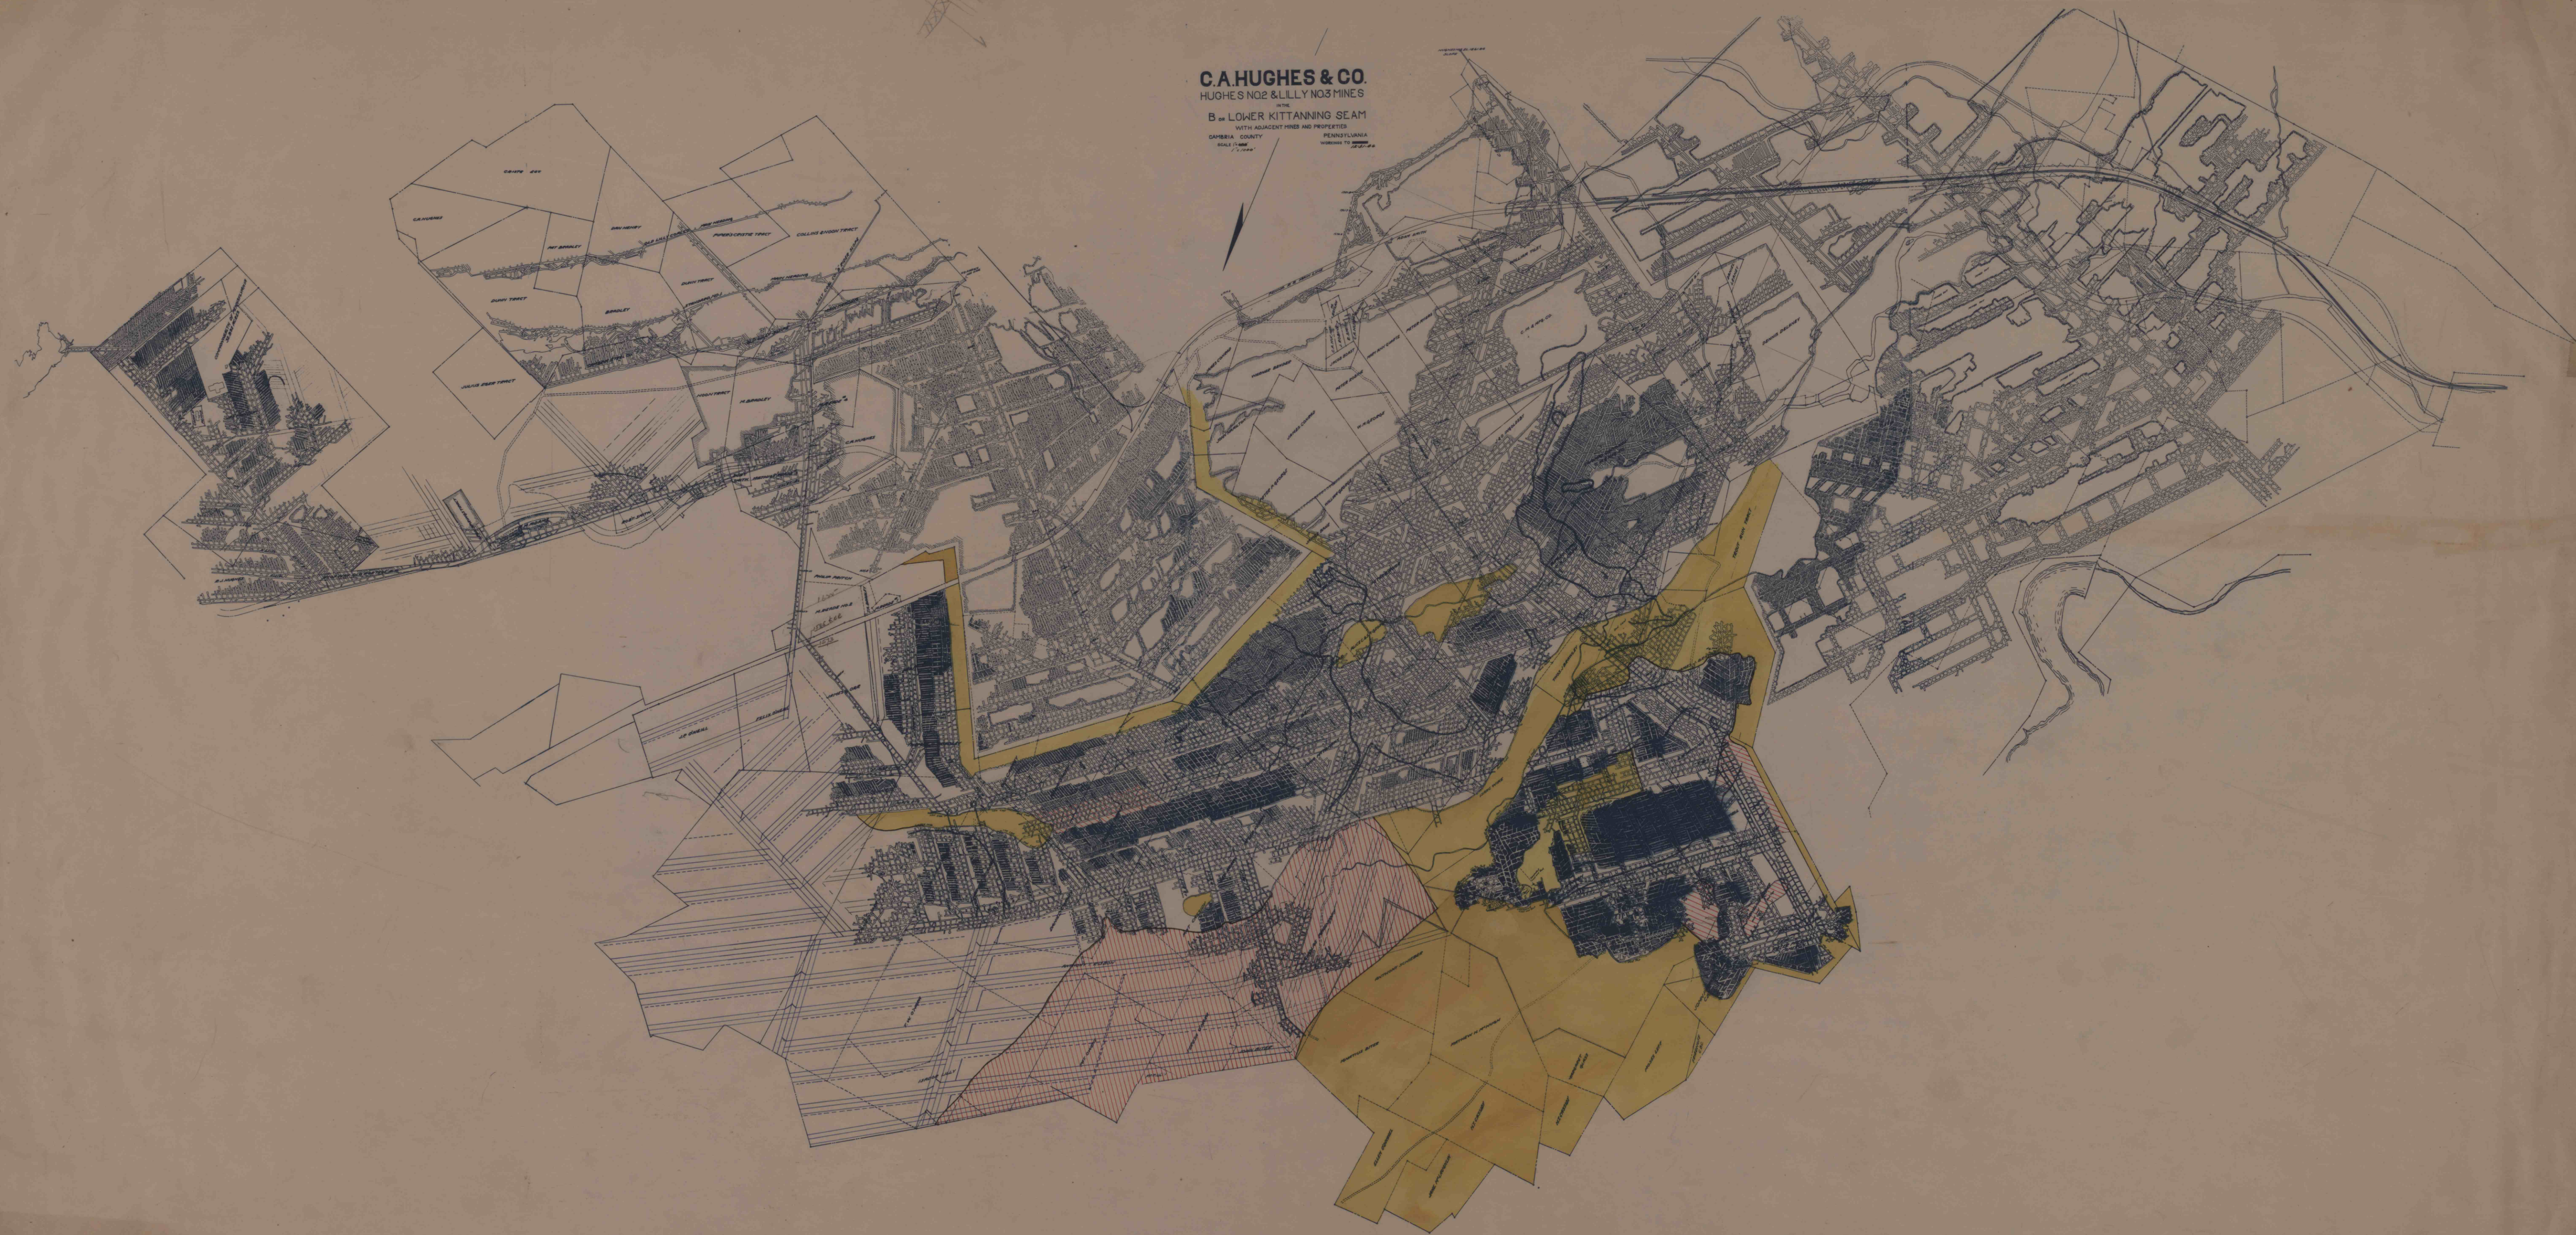

D129