


C.A. HUGHES & CO.
HUGHES NO. 2 & LILLY NO. 3 MINES
B OF LOWER KITTANNING SEAM
WITH ADJACENT MINES AND PROPERTIES
CAMBRIA COUNTY PENNSYLVANIA
SCALE: 1"=1000'

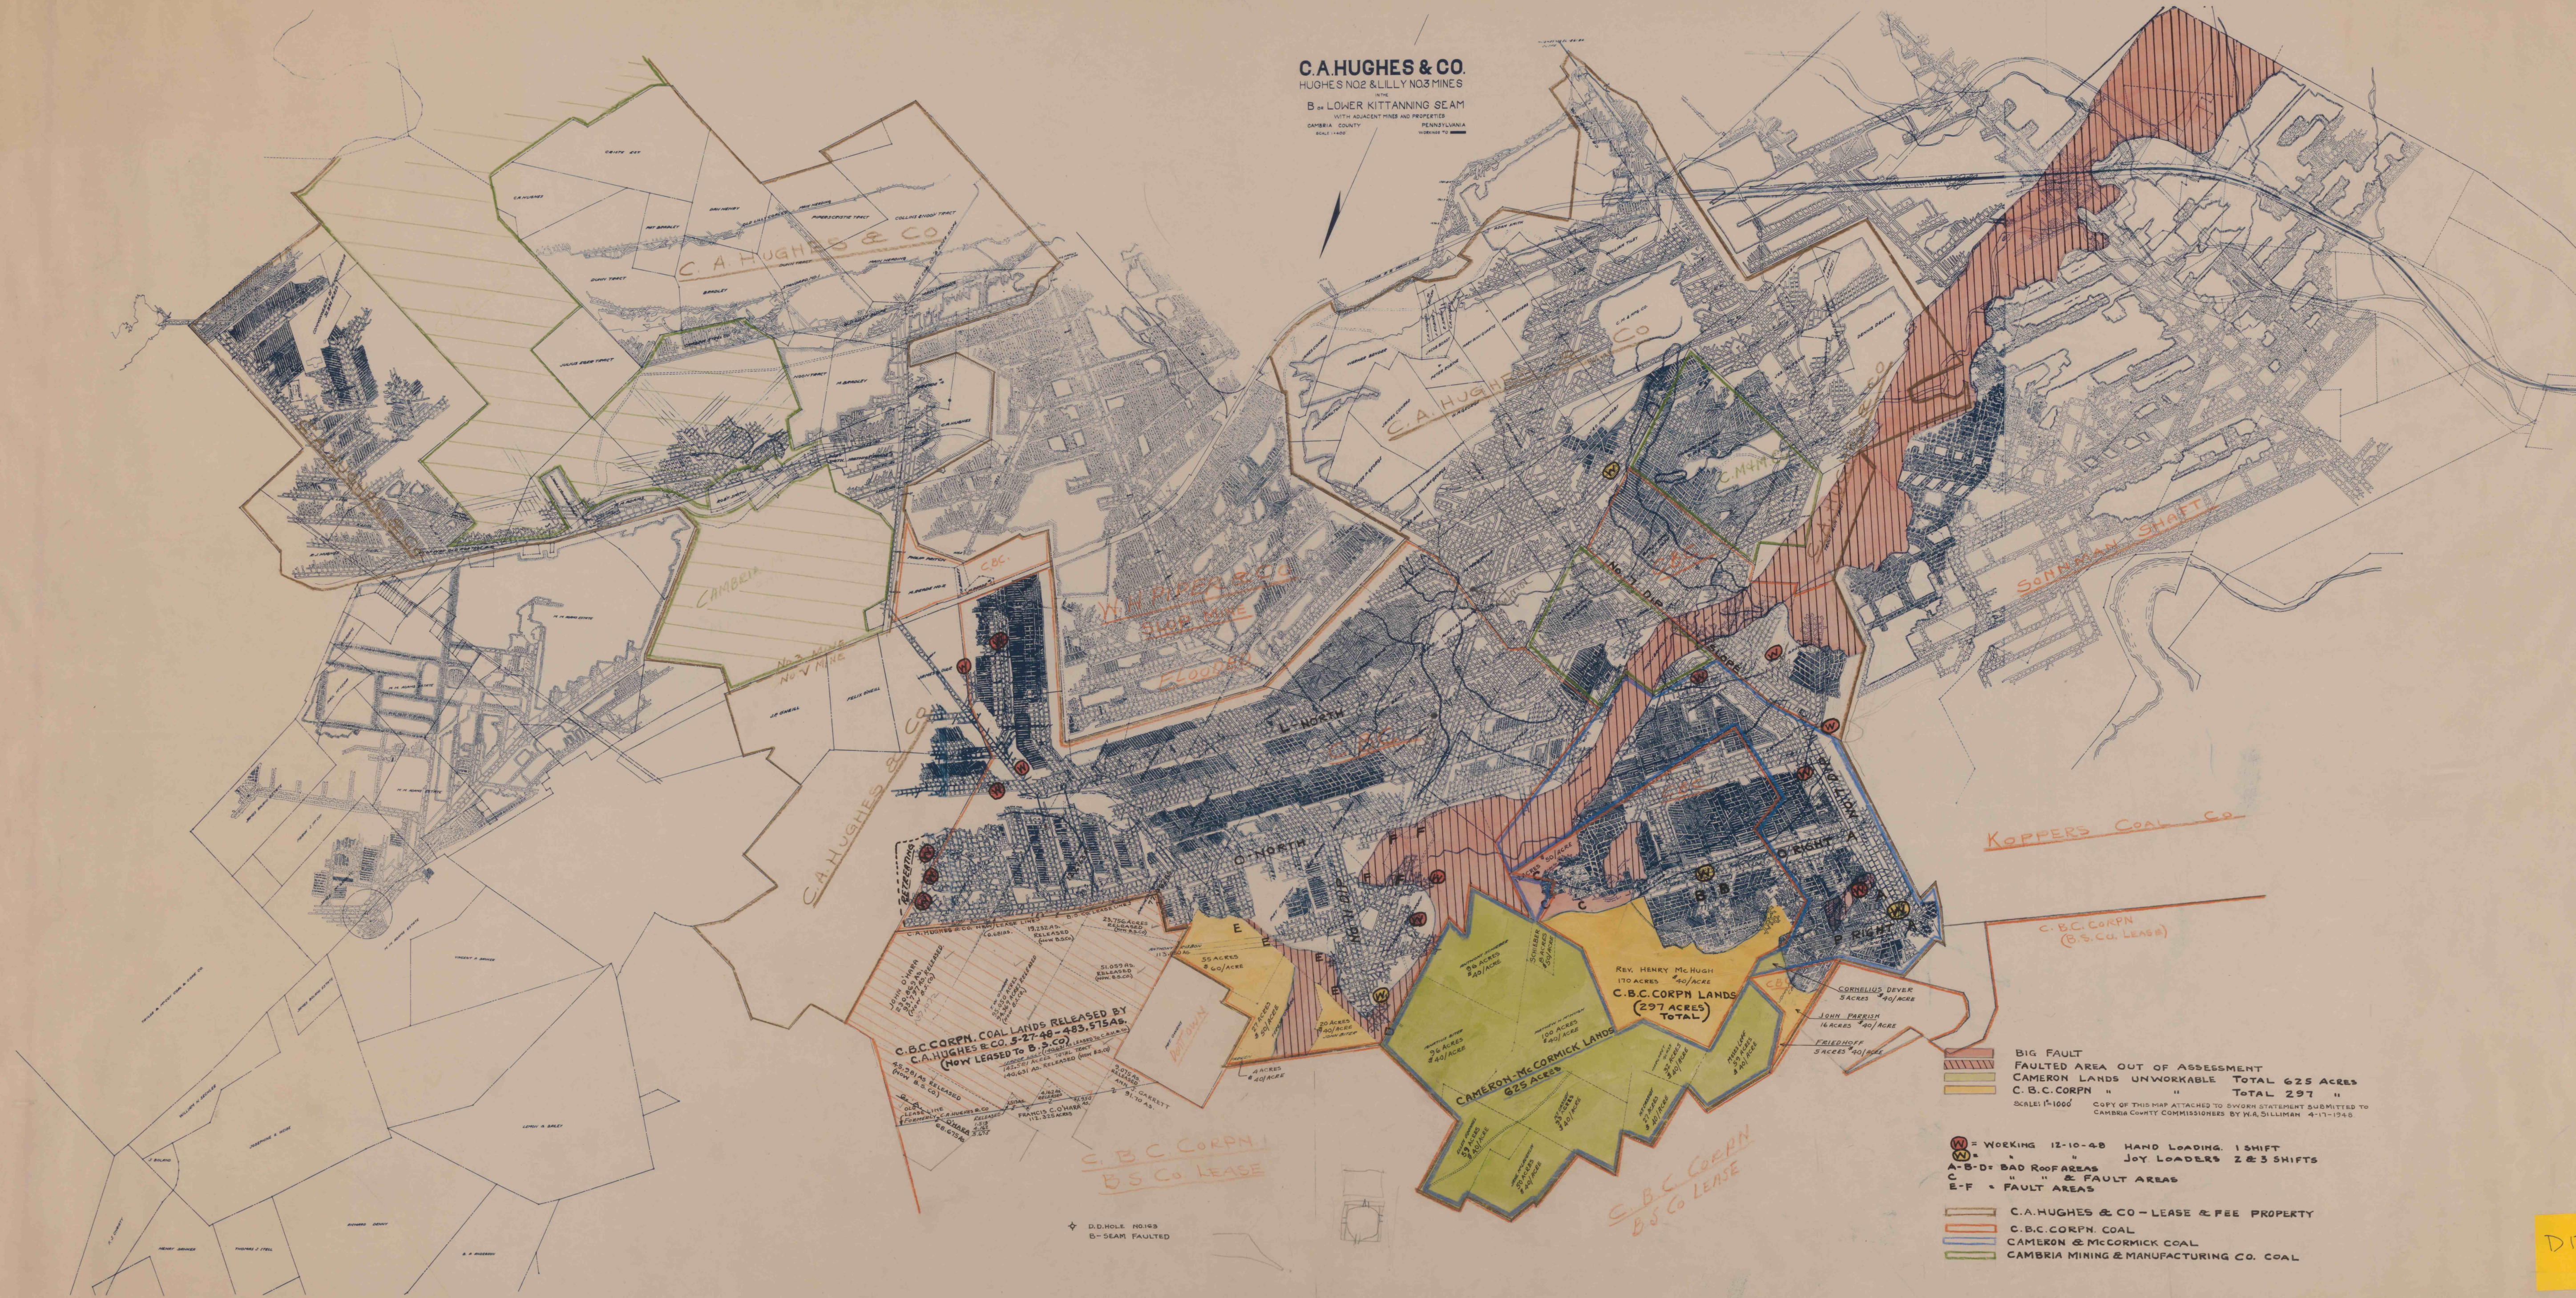

- LEGEND**
- W = WORKING 12-10-48 HAND LOADING, 1 SHIFT
 - N = JOY LOADERS 2 & 3 SHIFTS
 - A-B-D = BAD ROOF AREAS
 - C = " " & FAULT AREAS
 - E-F = FAULT AREAS
 - C.A. HUGHES & CO. - LEASE & FEE PROPERTY
 - C.B.C. CORPN. COAL
 - CAMBRIA MINING & MANUFACTURING CO. COAL
- FAULTED AREA OUT OF ASSESSMENT**
CAMBRIA LANDS UNWORKABLE TOTAL 625 ACRES
C.B.C. CORPN. " " TOTAL 297 "
- SCALE: 1"=1000' COPY OF THIS MAP ATTACHED TO SWORN STATEMENT SUBMITTED TO CAMBRIA COUNTY COMMISSIONERS BY W.A. SILLIMAN 4-17-1948