EBENSBURG NO 1
1" = 1000'

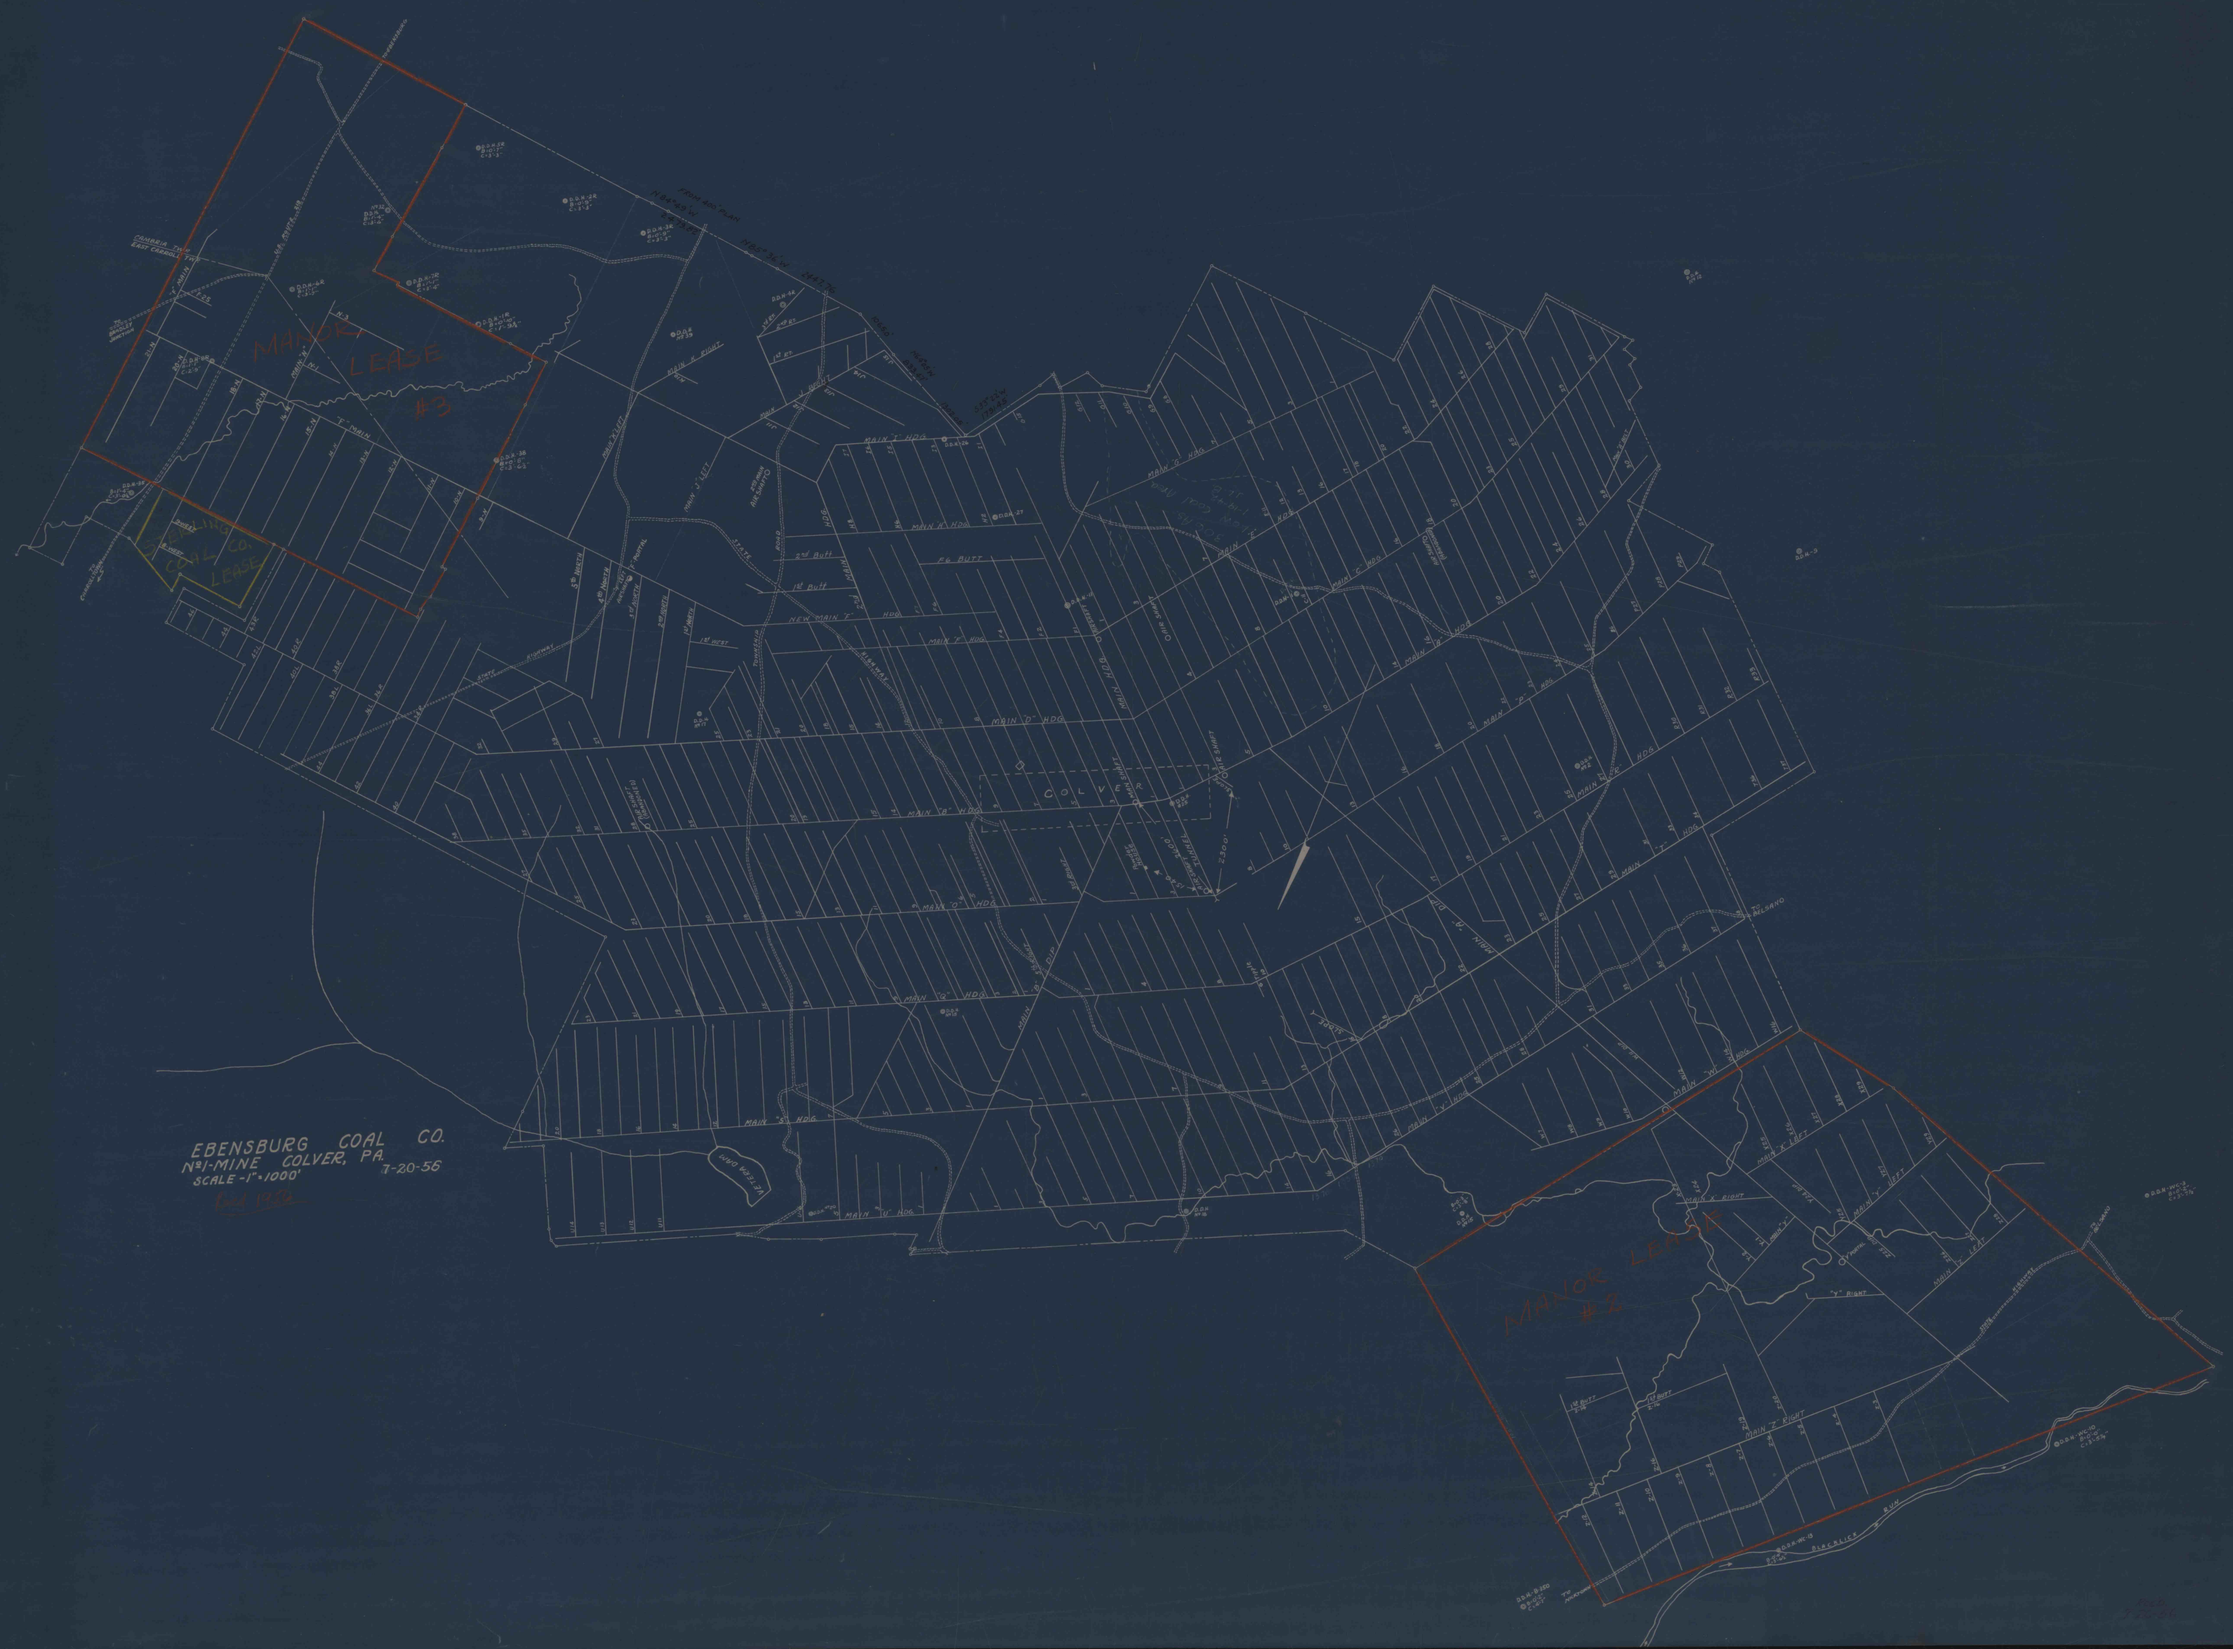

1" = 1000'
EBENSBURG
E-128