


BETHLEHEM MINES CORP
REVLOC MINE
POSTED TO 1-1-26

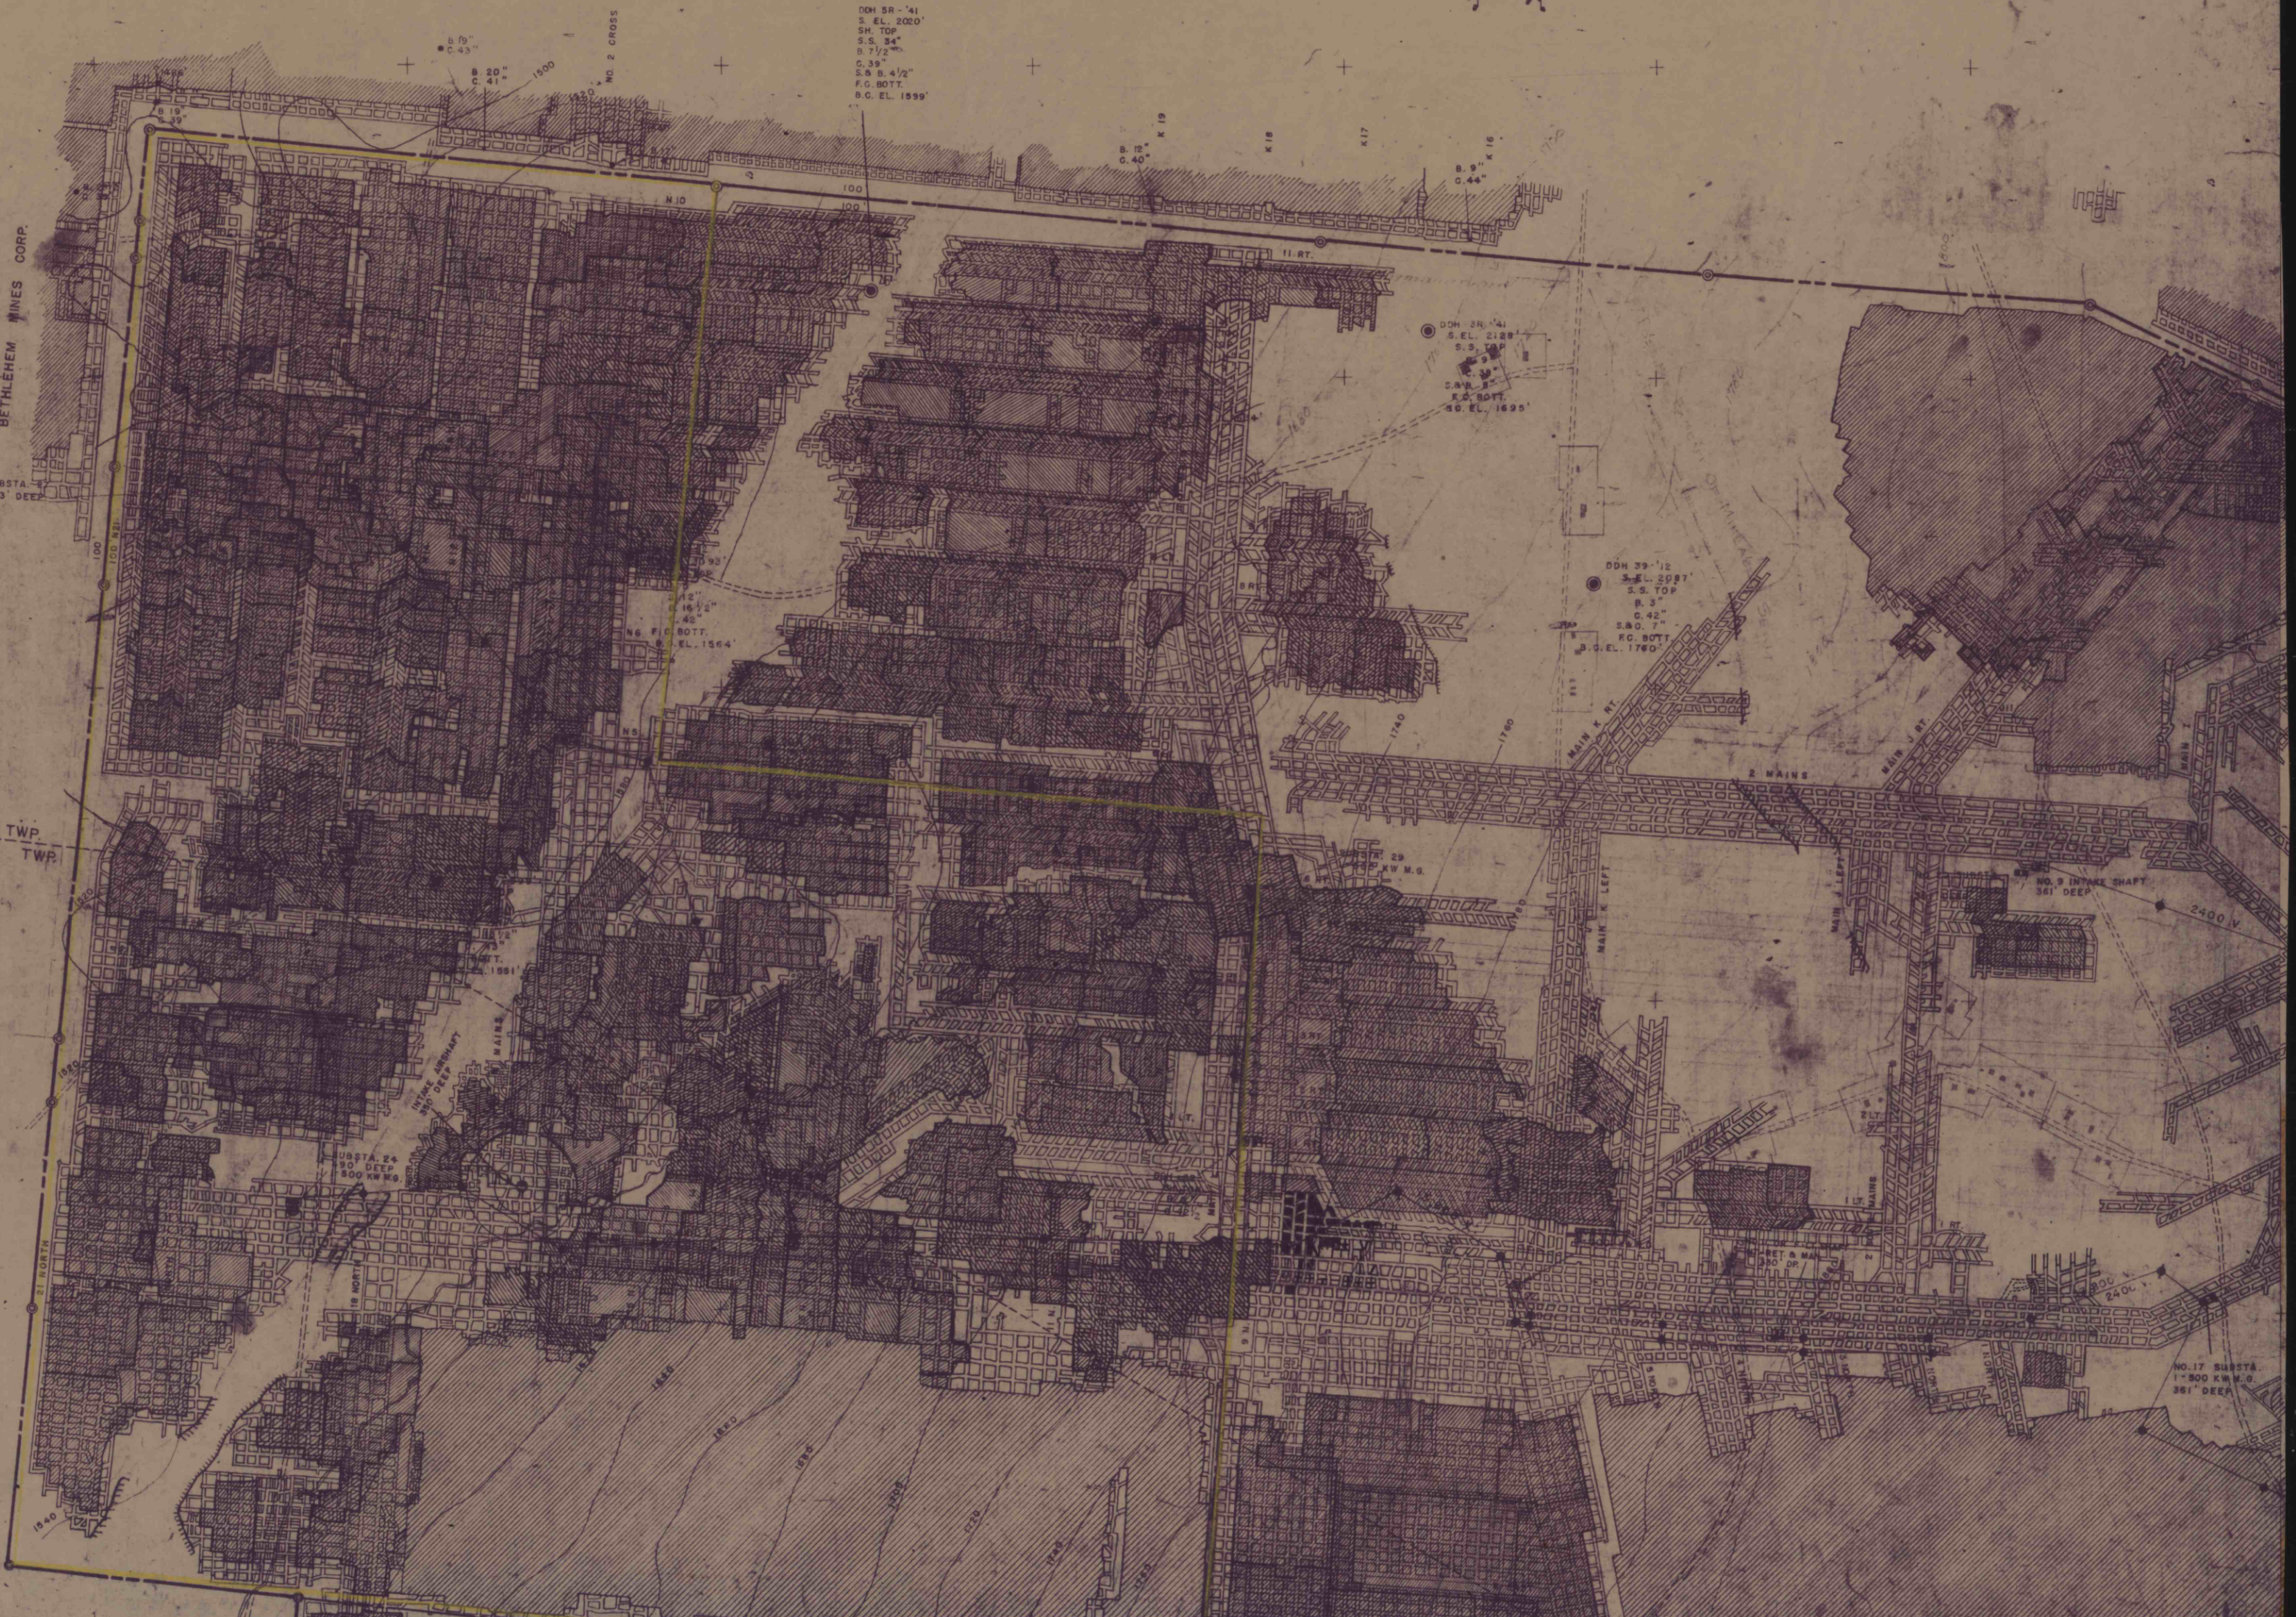

CAMBRIA TWP.
EAST GARROLL TWP.

STERLING CO. LEASE NO. 1

STERLING COAL CO.

STERLING COAL CO.