


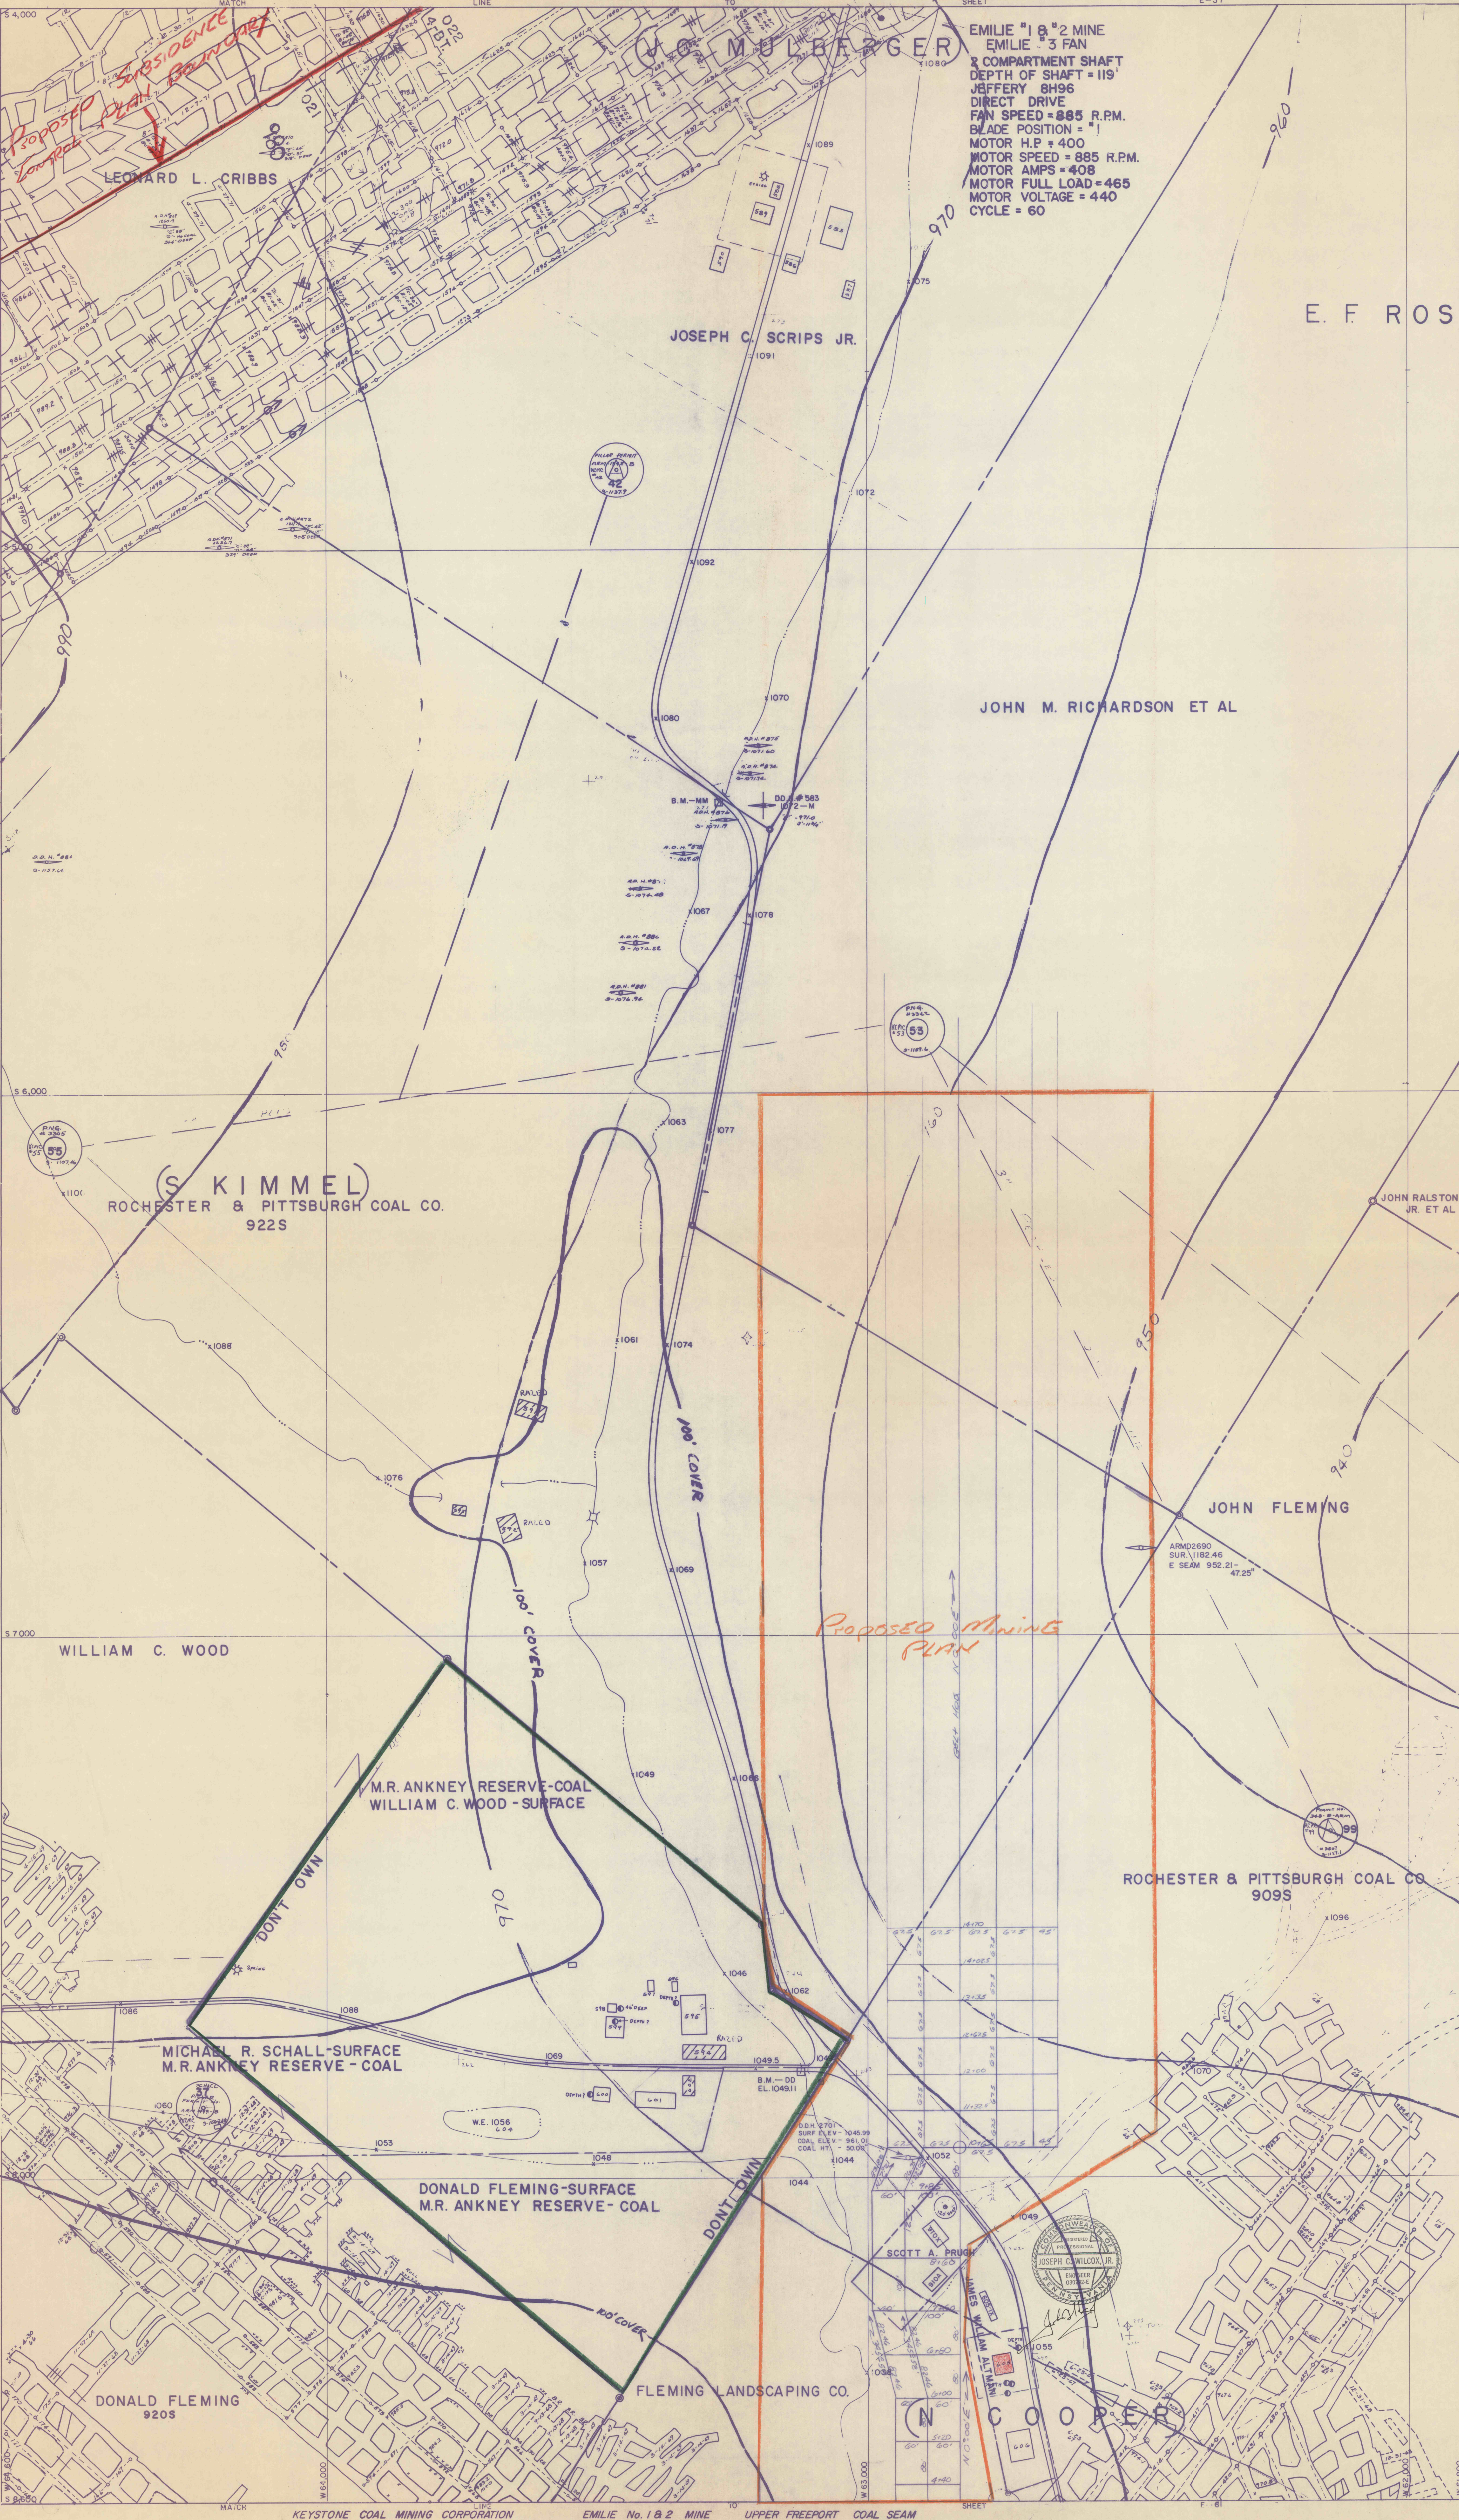

EMILIE #1 & 2 MINE
EMILIE #3 FAN
2 COMPARTMENT SHAFT
DEPTH OF SHAFT = 119'
JEFFERY 8H96
DIRECT DRIVE
FAN SPEED = 885 R.P.M.
BLADE POSITION = "1"
MOTOR H.P. = 400
MOTOR SPEED = 885 R.P.M.
MOTOR AMPS = 408
MOTOR FULL LOAD = 465
MOTOR VOLTAGE = 440
CYCLE = 60

LEONARD L. CRIBBS

JOSEPH C. SCRIPS JR.

E. F. ROS

JOHN M. RICHARDSON ET AL

(S. KIMMEL)
ROCHESTER & PITTSBURGH COAL CO.
922S

JOHN RALSTON JR. ET AL

JOHN FLEMING

WILLIAM C. WOOD

M.R. ANKNEY RESERVE-COAL
WILLIAM C. WOOD - SURFACE

ROCHESTER & PITTSBURGH COAL CO
909S

MICHAEL R. SCHALL-SURFACE
M.R. ANKNEY RESERVE-COAL

DONALD FLEMING-SURFACE
M.R. ANKNEY RESERVE-COAL

DONALD FLEMING
920S

FLEMING LANDSCAPING CO.

SCOTT A. PRUGH
JOSEPH C. WILCOX JR.
ENGINEER
STATE OF PENNSYLVANIA

C. COOPER