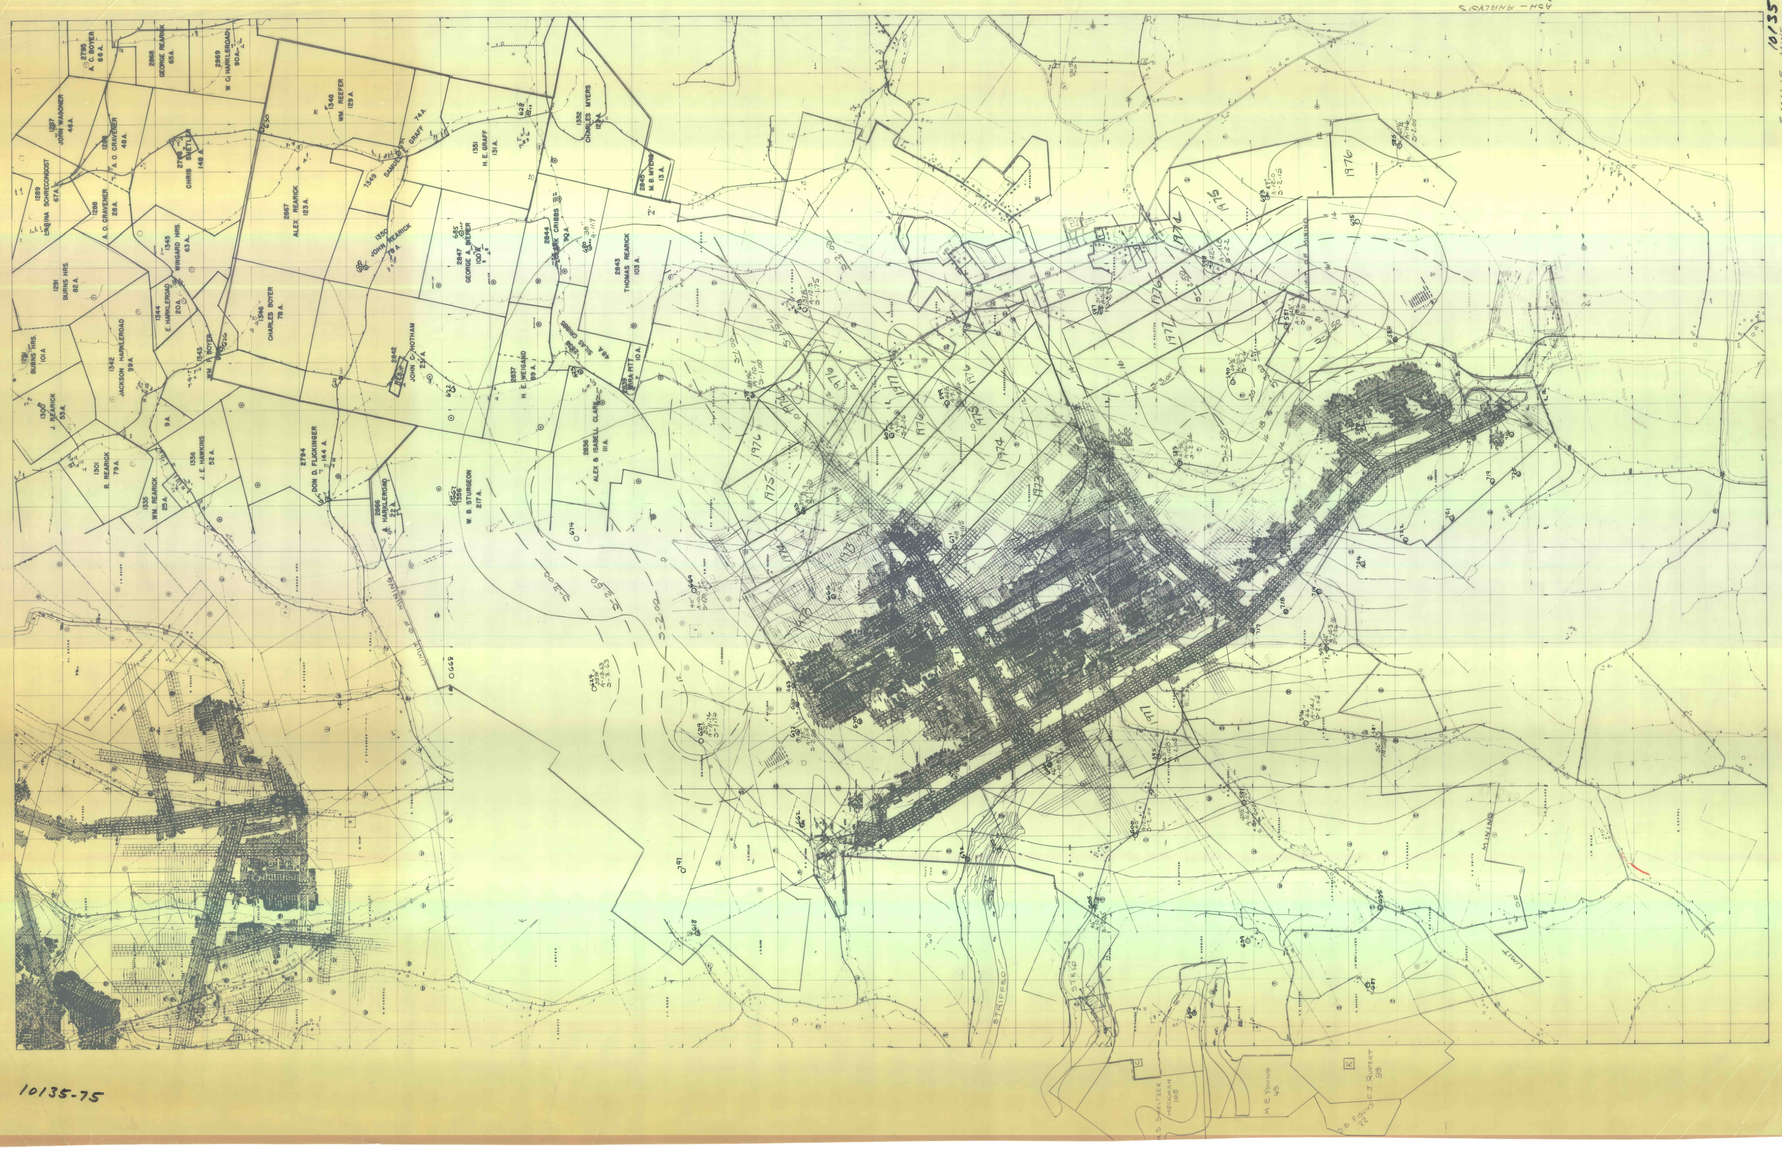
10135-75
E MILLE NINE
ASH - RAILWAYS
7-1-72
1976
1975
1974
1973
1972
1971
STANFORD
LINTY
W. B. STURGEON
217 A.
ALEX. & ISABELL CLARK
JOHN D. FLICKINGER
144 A.
JOHN WADDINGER
44 A.
A. C. BOYER
66 A.
GEORGE REARICK
65 A.
W. G. HARKLEROAD
CHARLES BOYER
79 A.
ALEX. REARICK
123 A.
WM. REEFER
103 A.
H. E. GRAFF
131 A.
CHARLES MYERS
GEORGE A. BREWER
THOMAS REARICK
103 A.
JOHN WOODHAM
53 A.
H. E. WIGGARD
99 A.
JACKSON HARKLEROAD
59 A.
WM. REARICK
79 A.
J. E. HAWKINS
52 A.
A. O. GRAVENER
CHRIS. SNYDER
148 A.
WINGARD WRS.
63 A.
BURNS WRS.
82 A.
BURNS WRS.
10 A.
J. REARICK
53 A.
R. REARICK
79 A.
WM. REARICK
86 A.
JOHN REARICK
29 A.
SAMUEL GRAFF
74 A.
H. E. YOUNG
45
C. J. RUPERT
33

10135-75