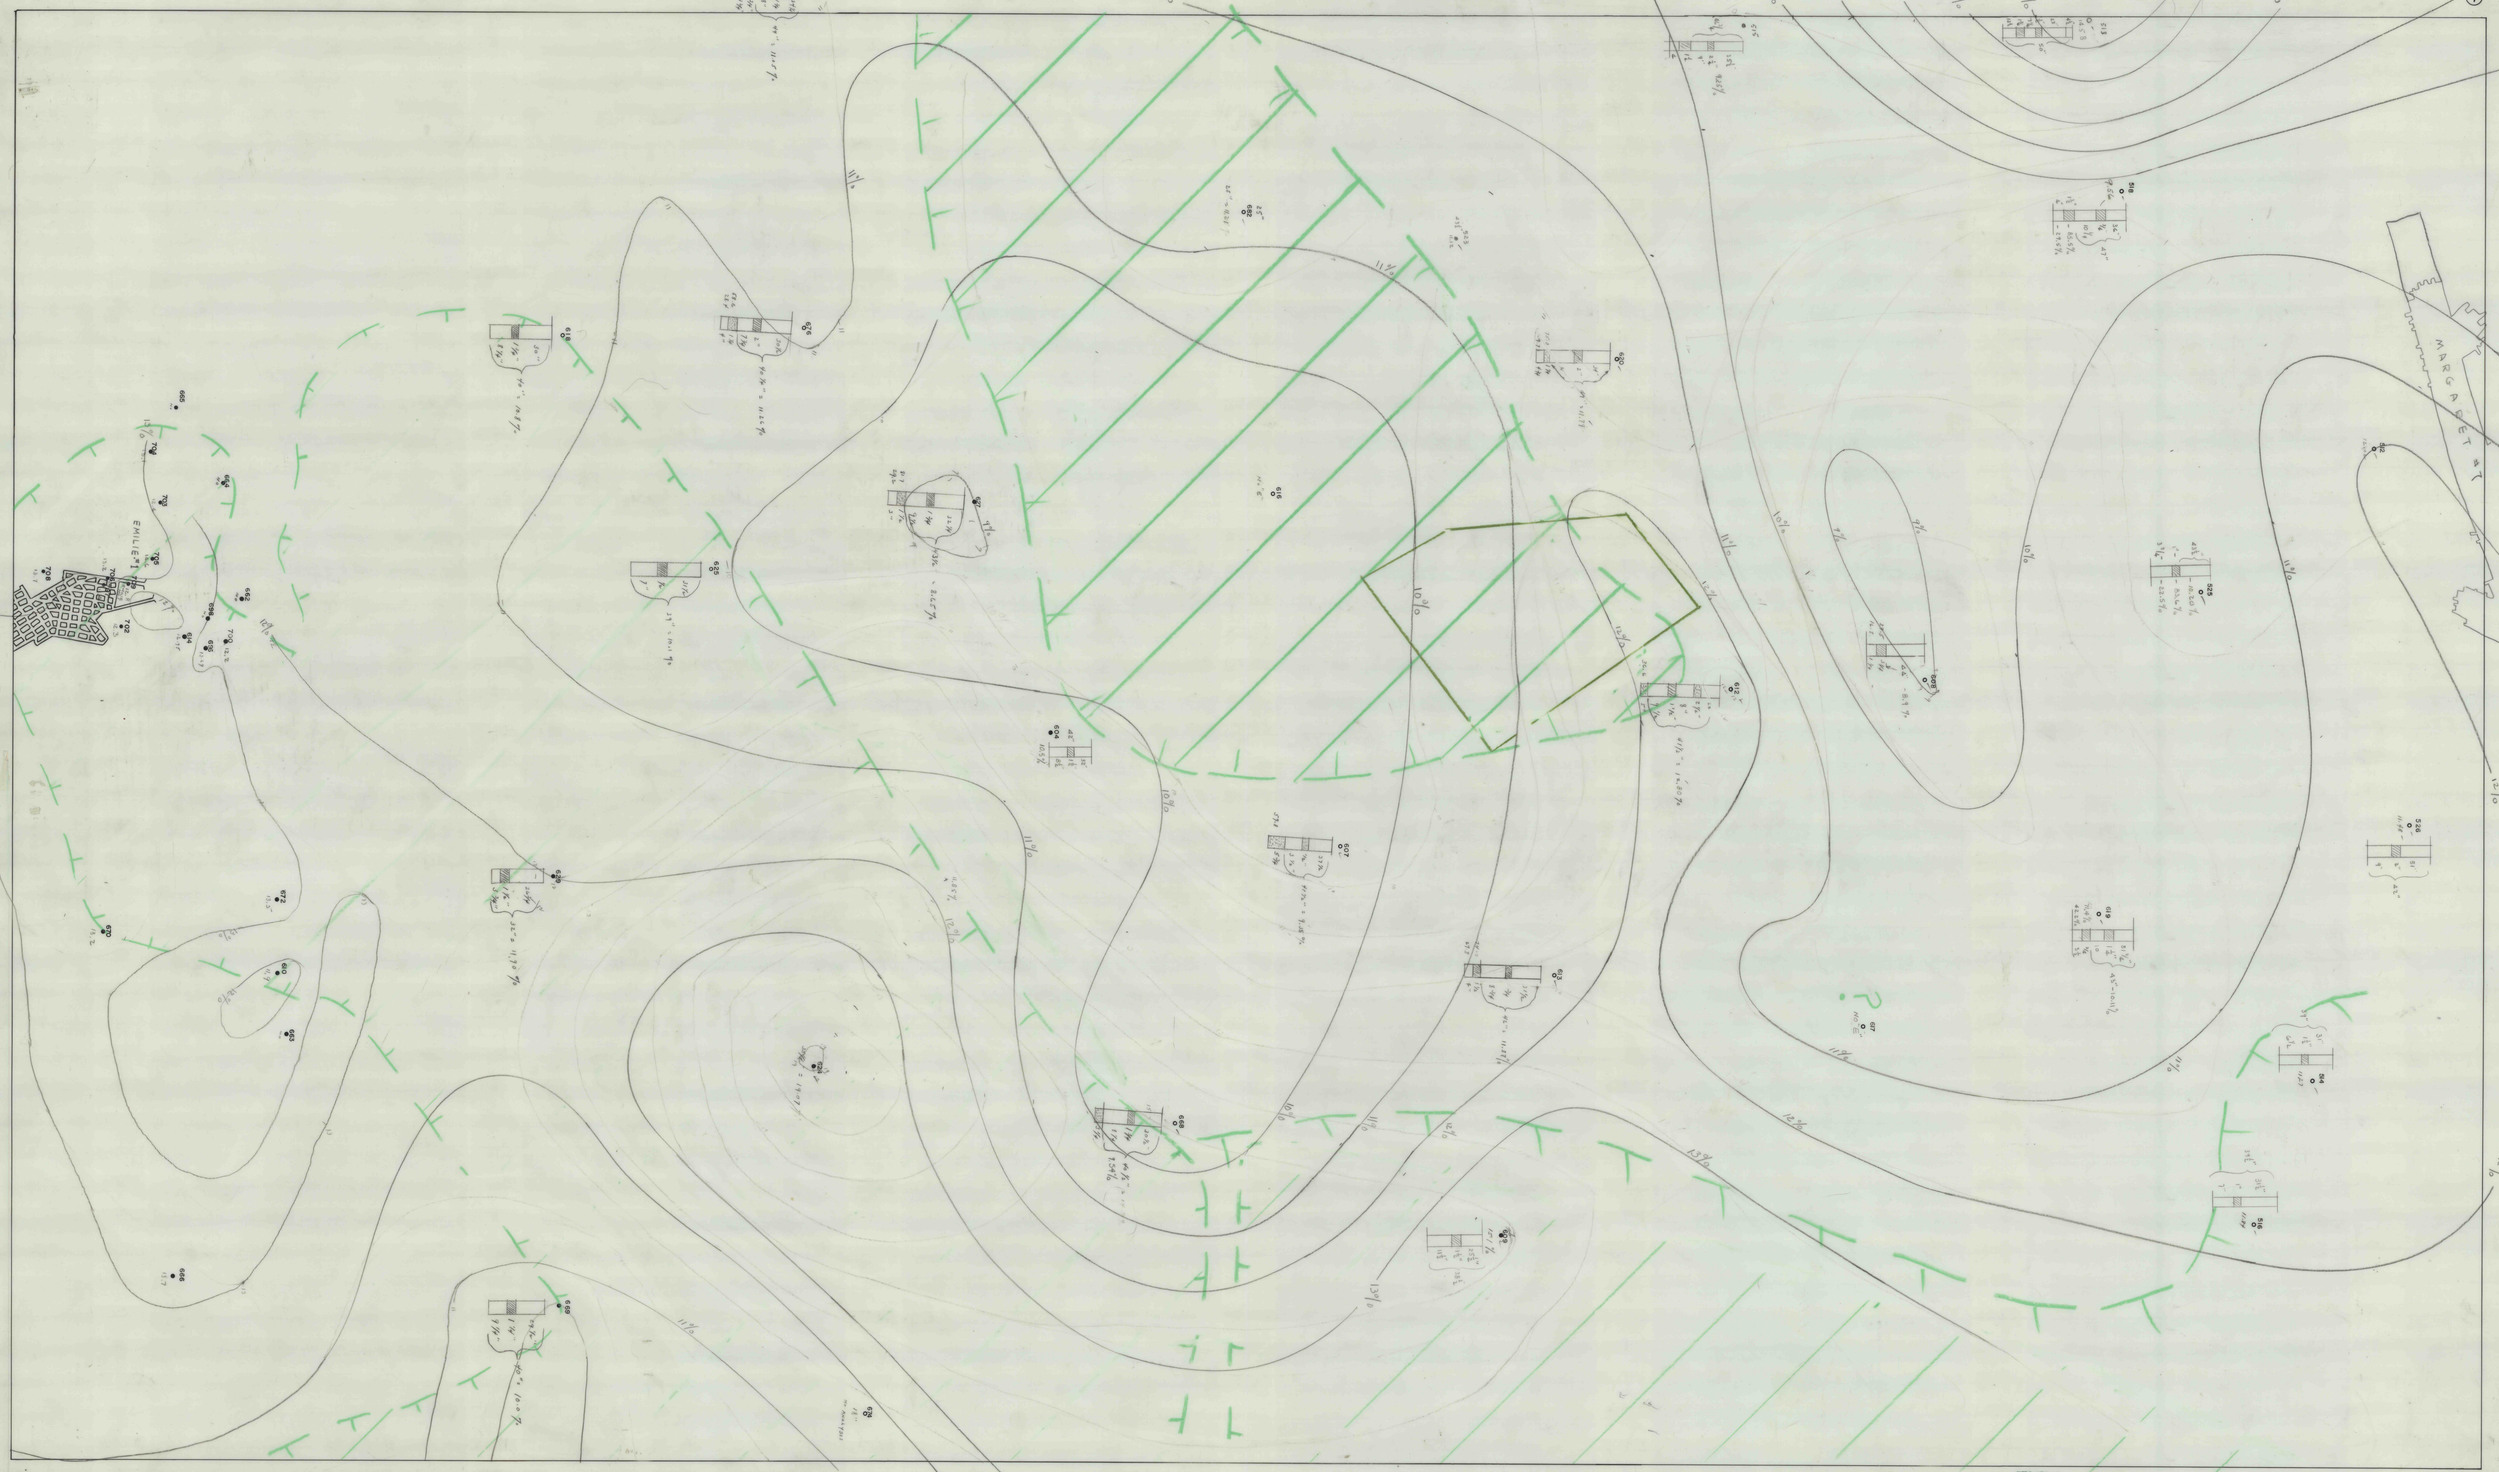

400' ~~IDAHO~~ EMILIE - COAL ANALYSIS CONTOURS - OVERLAY
"E" - SEAM

11092-75

400' IDAHO-COAL ANALYSIS CONTOURS- OVERLAY
"E"- SEAM
11092-75