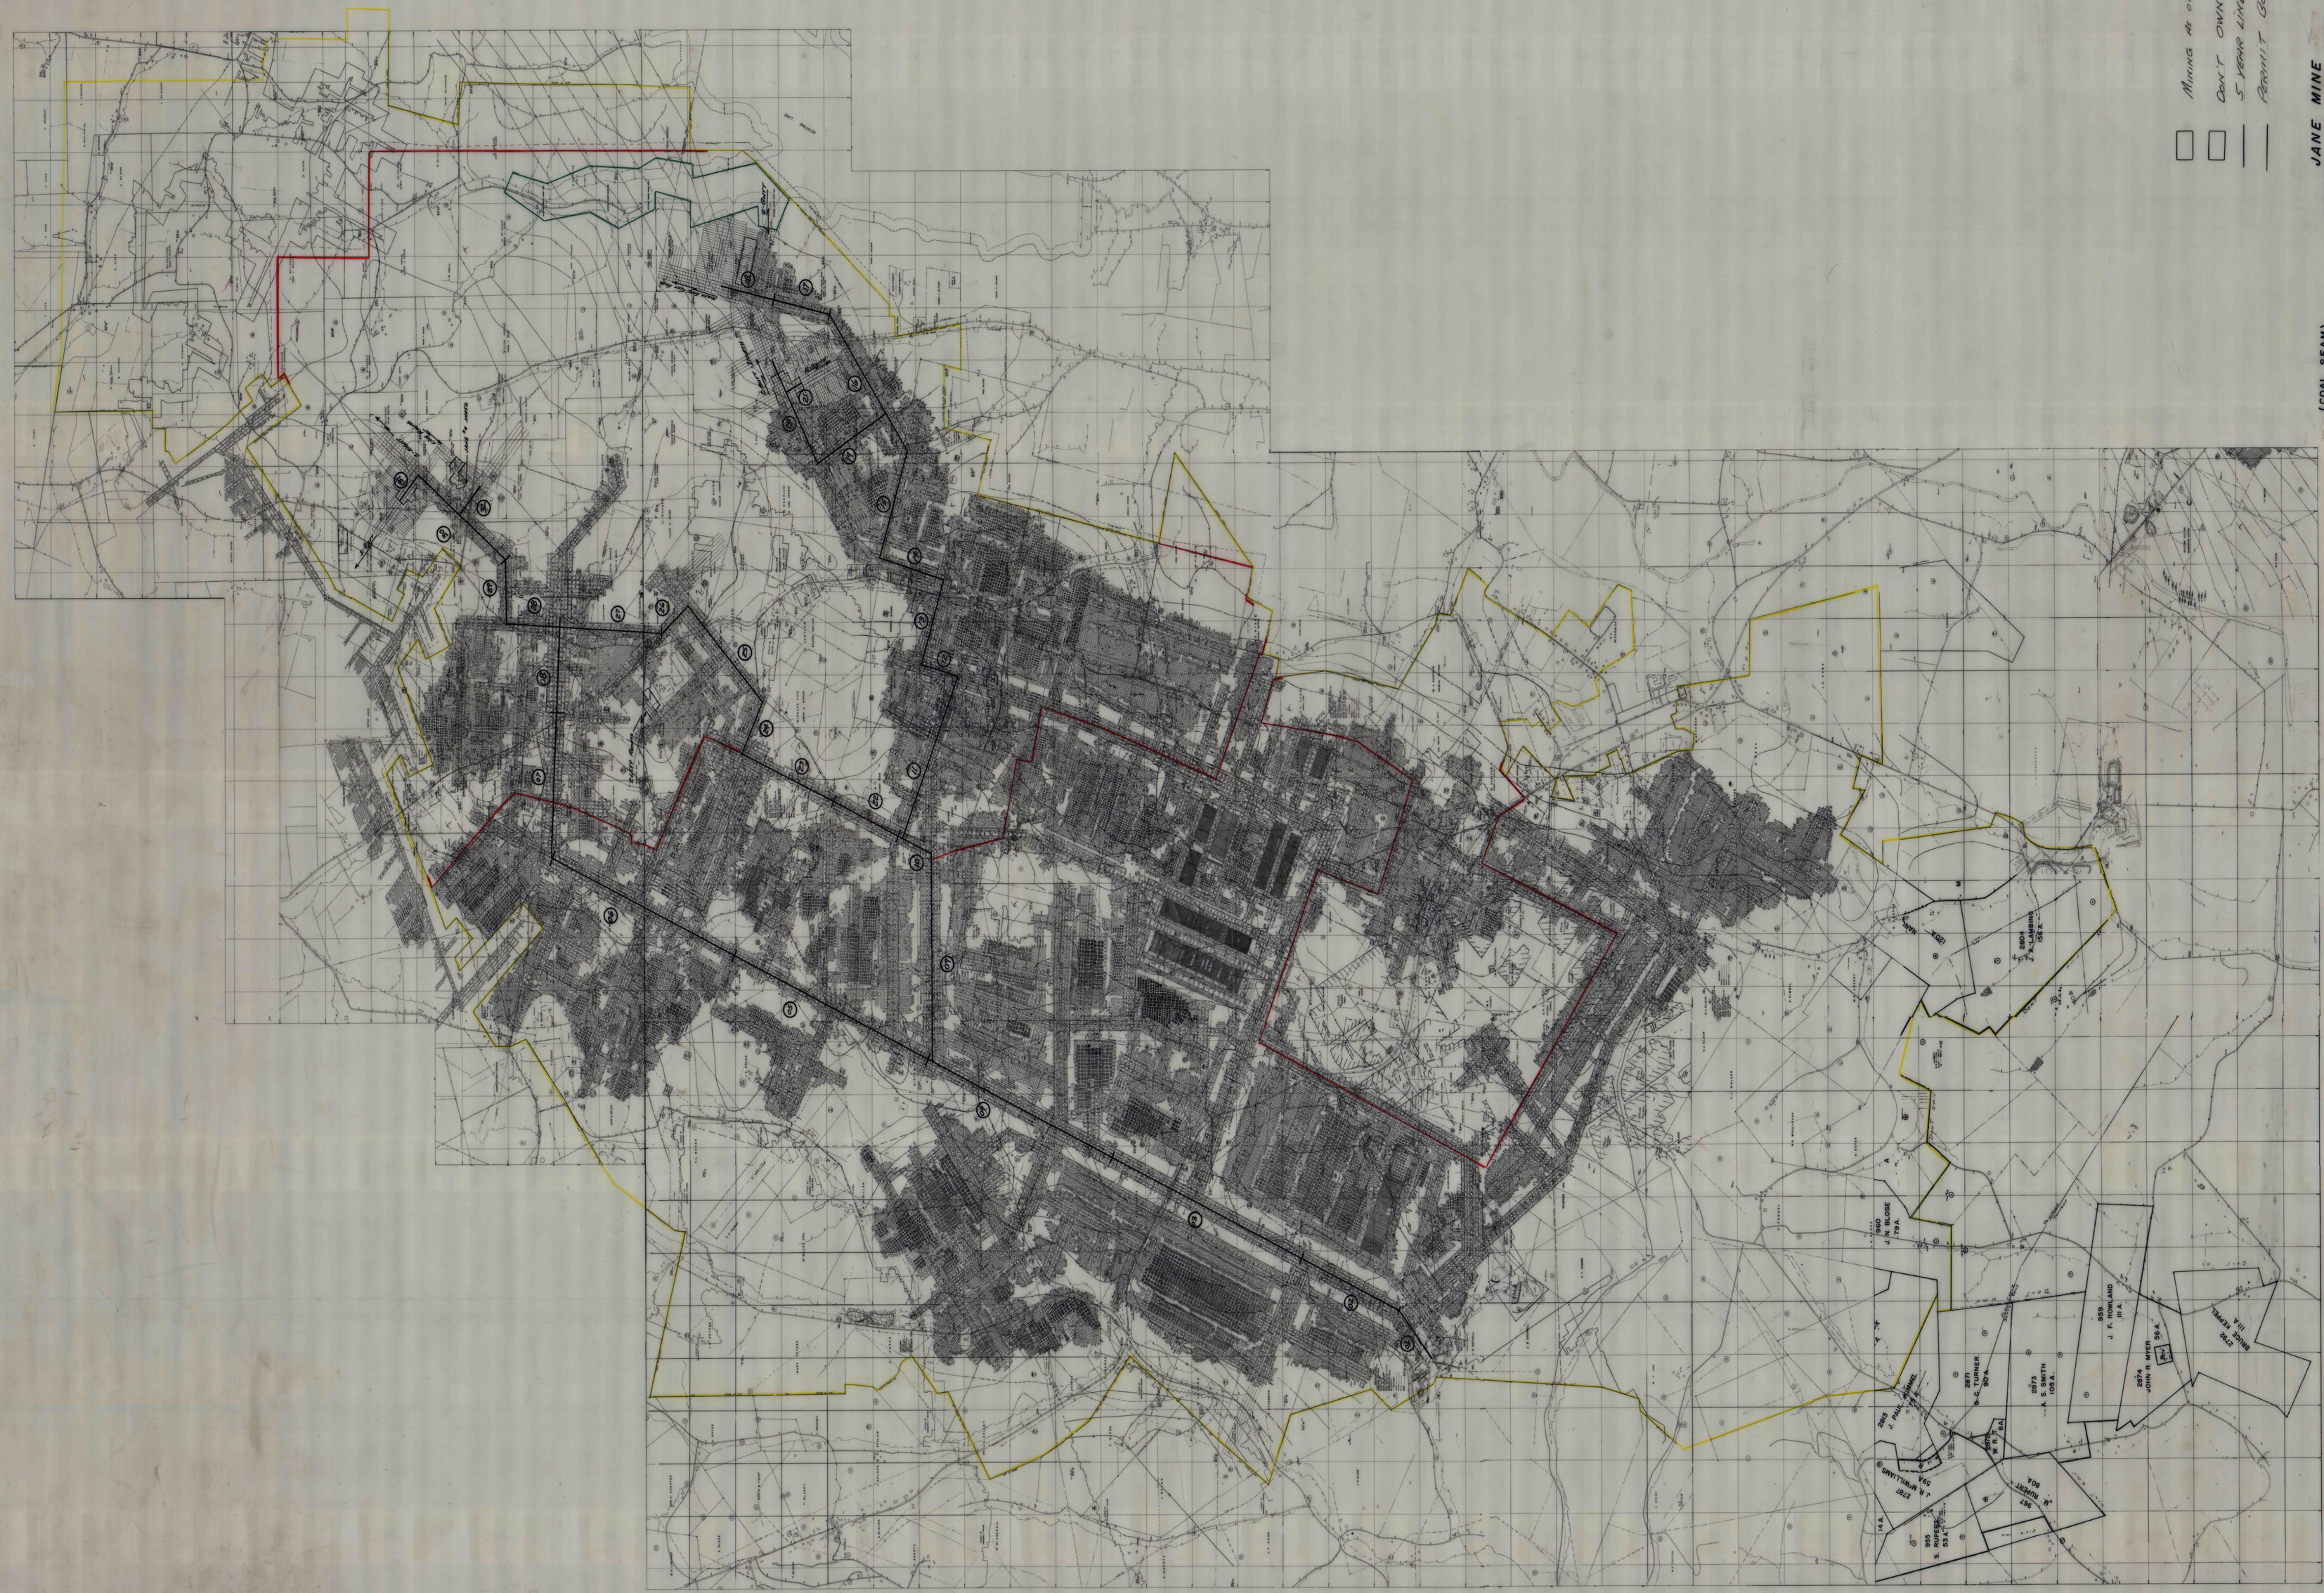
SCALE : 1" = 1000' POSTING DATE 7-31-1989
N
MINING AS OF 10-19-89
OWN'T OWN.
5 YEAR LINE
PERMIT BOUNDARY
JANE MINE
KEYSTONE COAL MINING CORP.
PLUMCREEK & COWANSHANNOCK TWP. ARMSTRONG CO.
(COAL SEAM)
LOWER FREEPORT
2804
J. E. BLAIR
62.8A.
1940
J. W. BLOSE
79.A.
959
J. P. ROWLAND
114.A.
2574
JOHN H. MYER
56.A.
2573
A. S. SMITH
105.A.
2571
R. C. TURNER
20.A.
2572
W. F.
5.A.
2573
J. BURGERT
80.A.
2573
C. H. WILLIAMS
59.A.
2573
S. BURGERT
53.A.
14.A.
2572
THOMAS A. STEVER
20.A.