


map 1007 1889

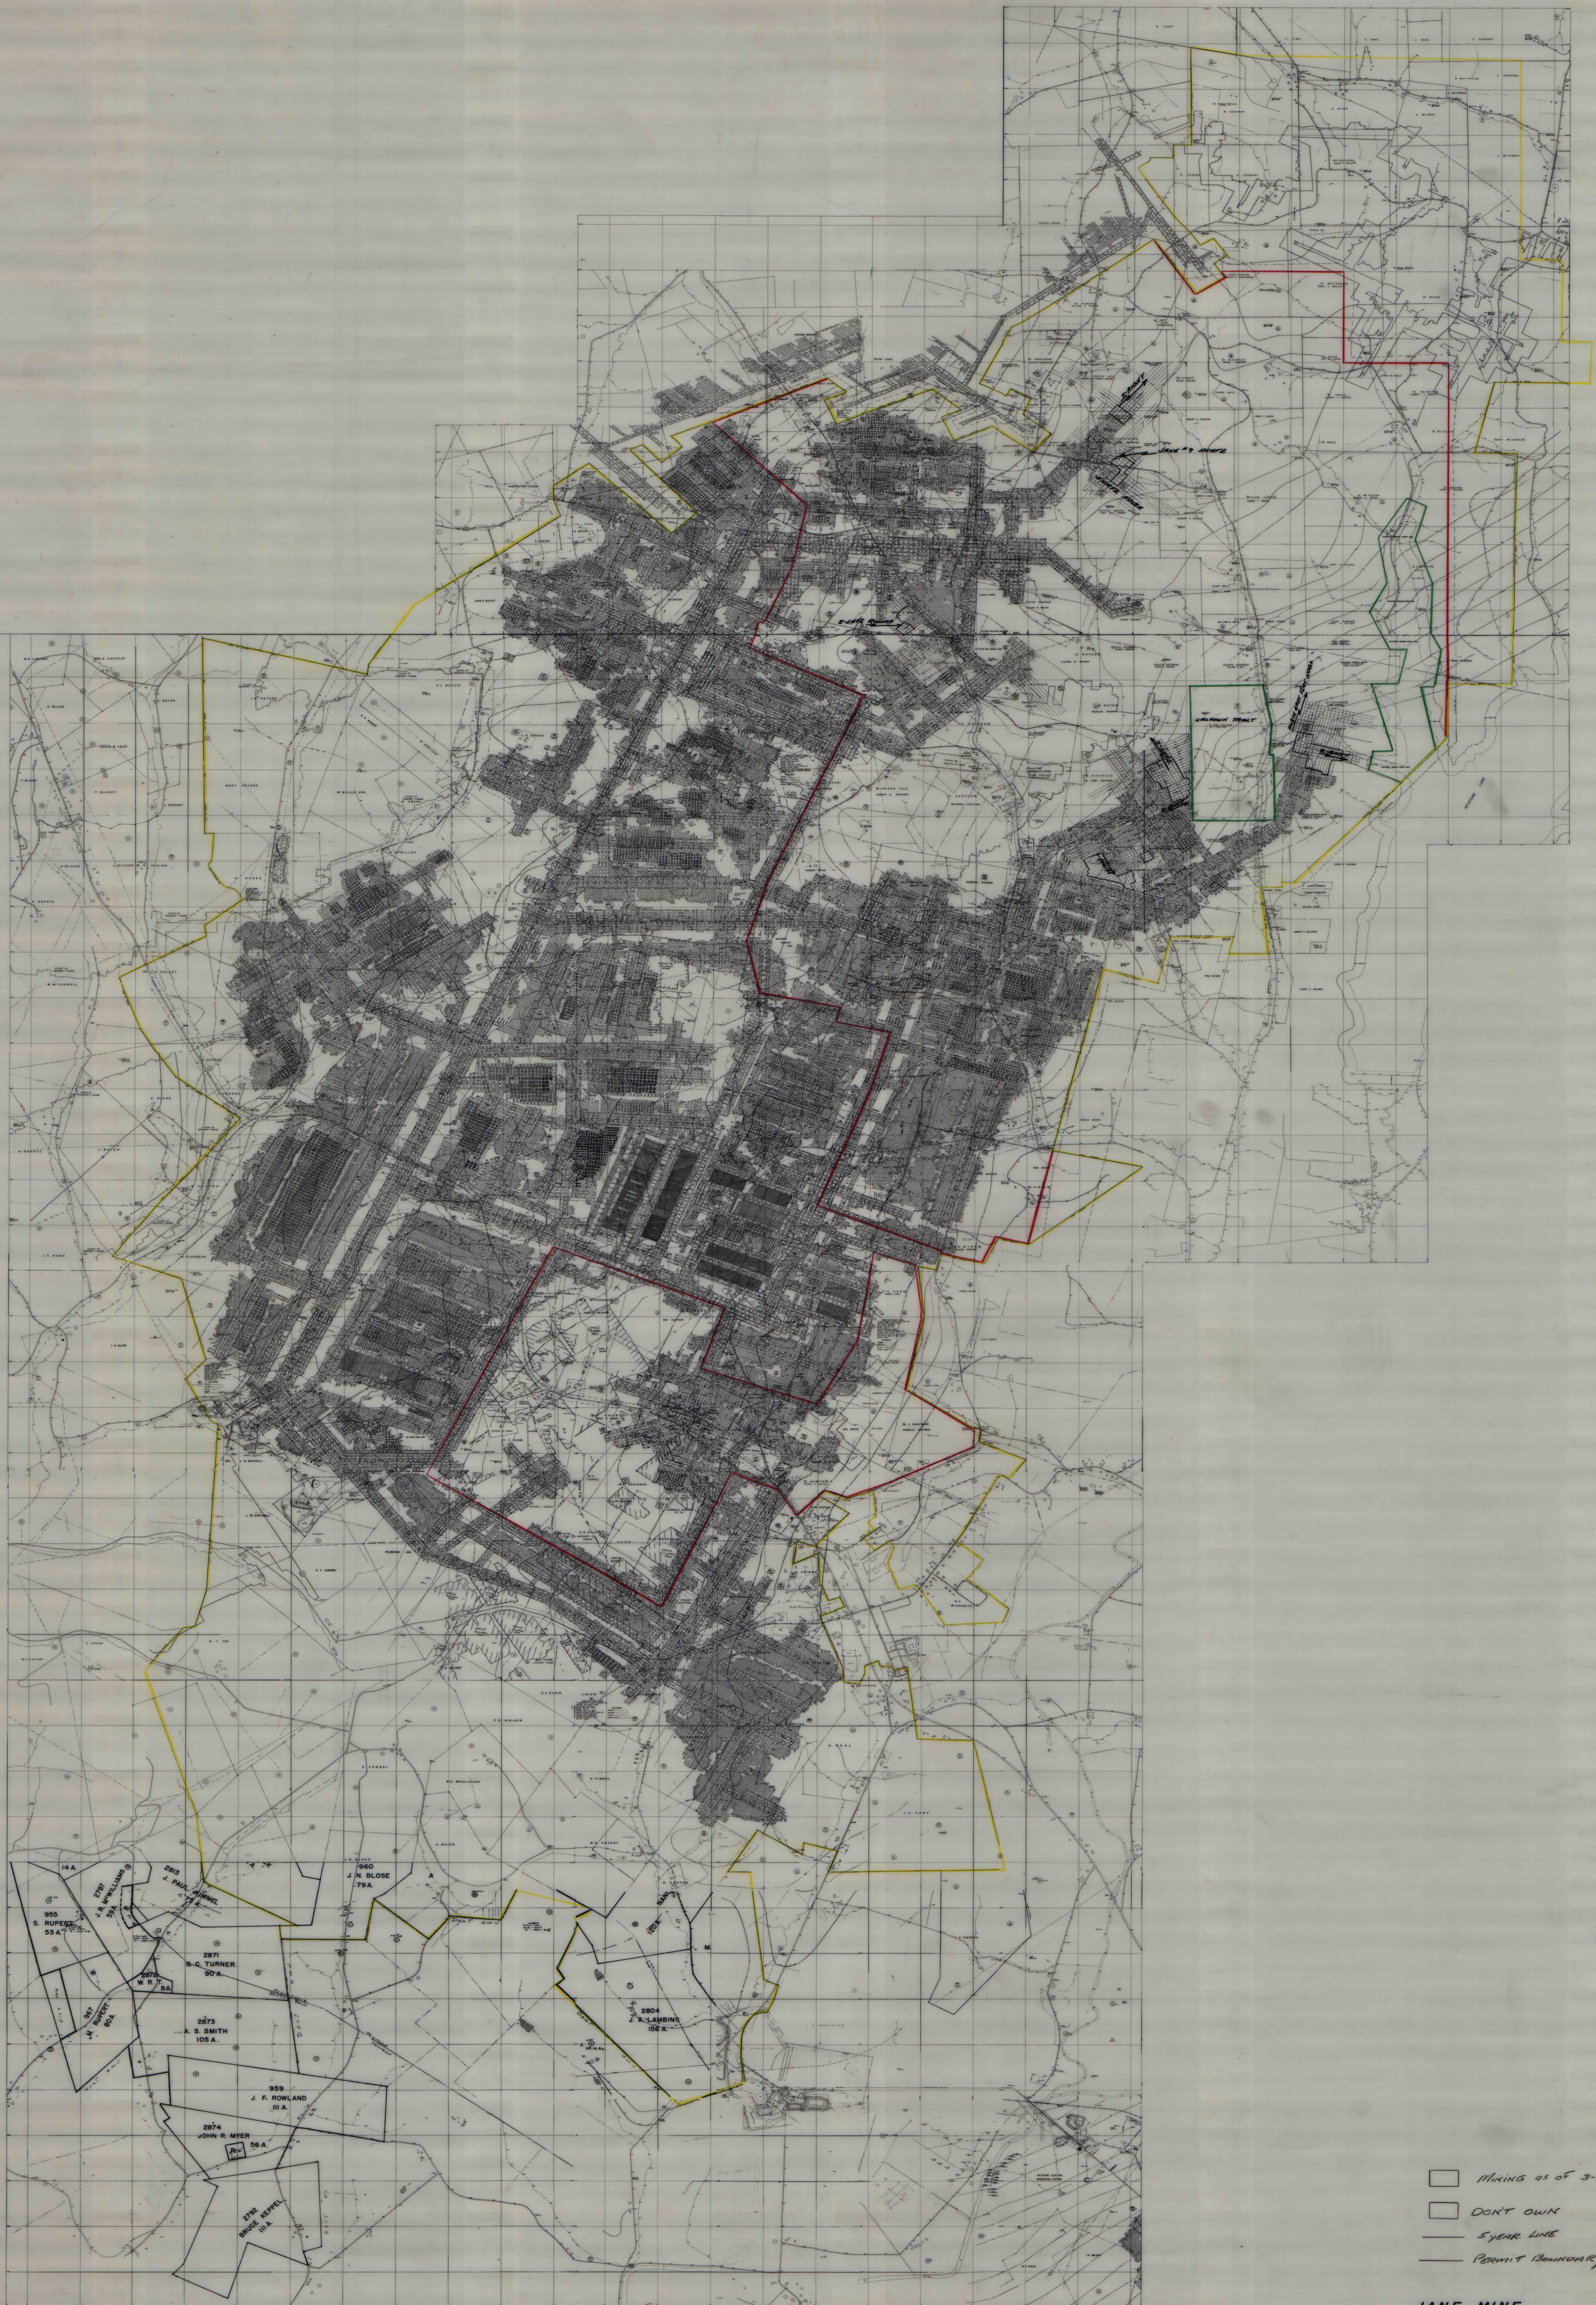

- MINING as of 3-14-1989
- DON'T OWN
- 5 YEAR LINE
- PERMIT BOUNDARY

N
POSTING DATE 1-21-1989
SCALE: 1" = 1000'

(COAL SEAM)
LOWER FREEPORT
JANE MINE
KEYSTONE COAL MINING CORP.
PLUMCREEK & COWANSHANNOCK TWP. ARMSTRONG CO.