


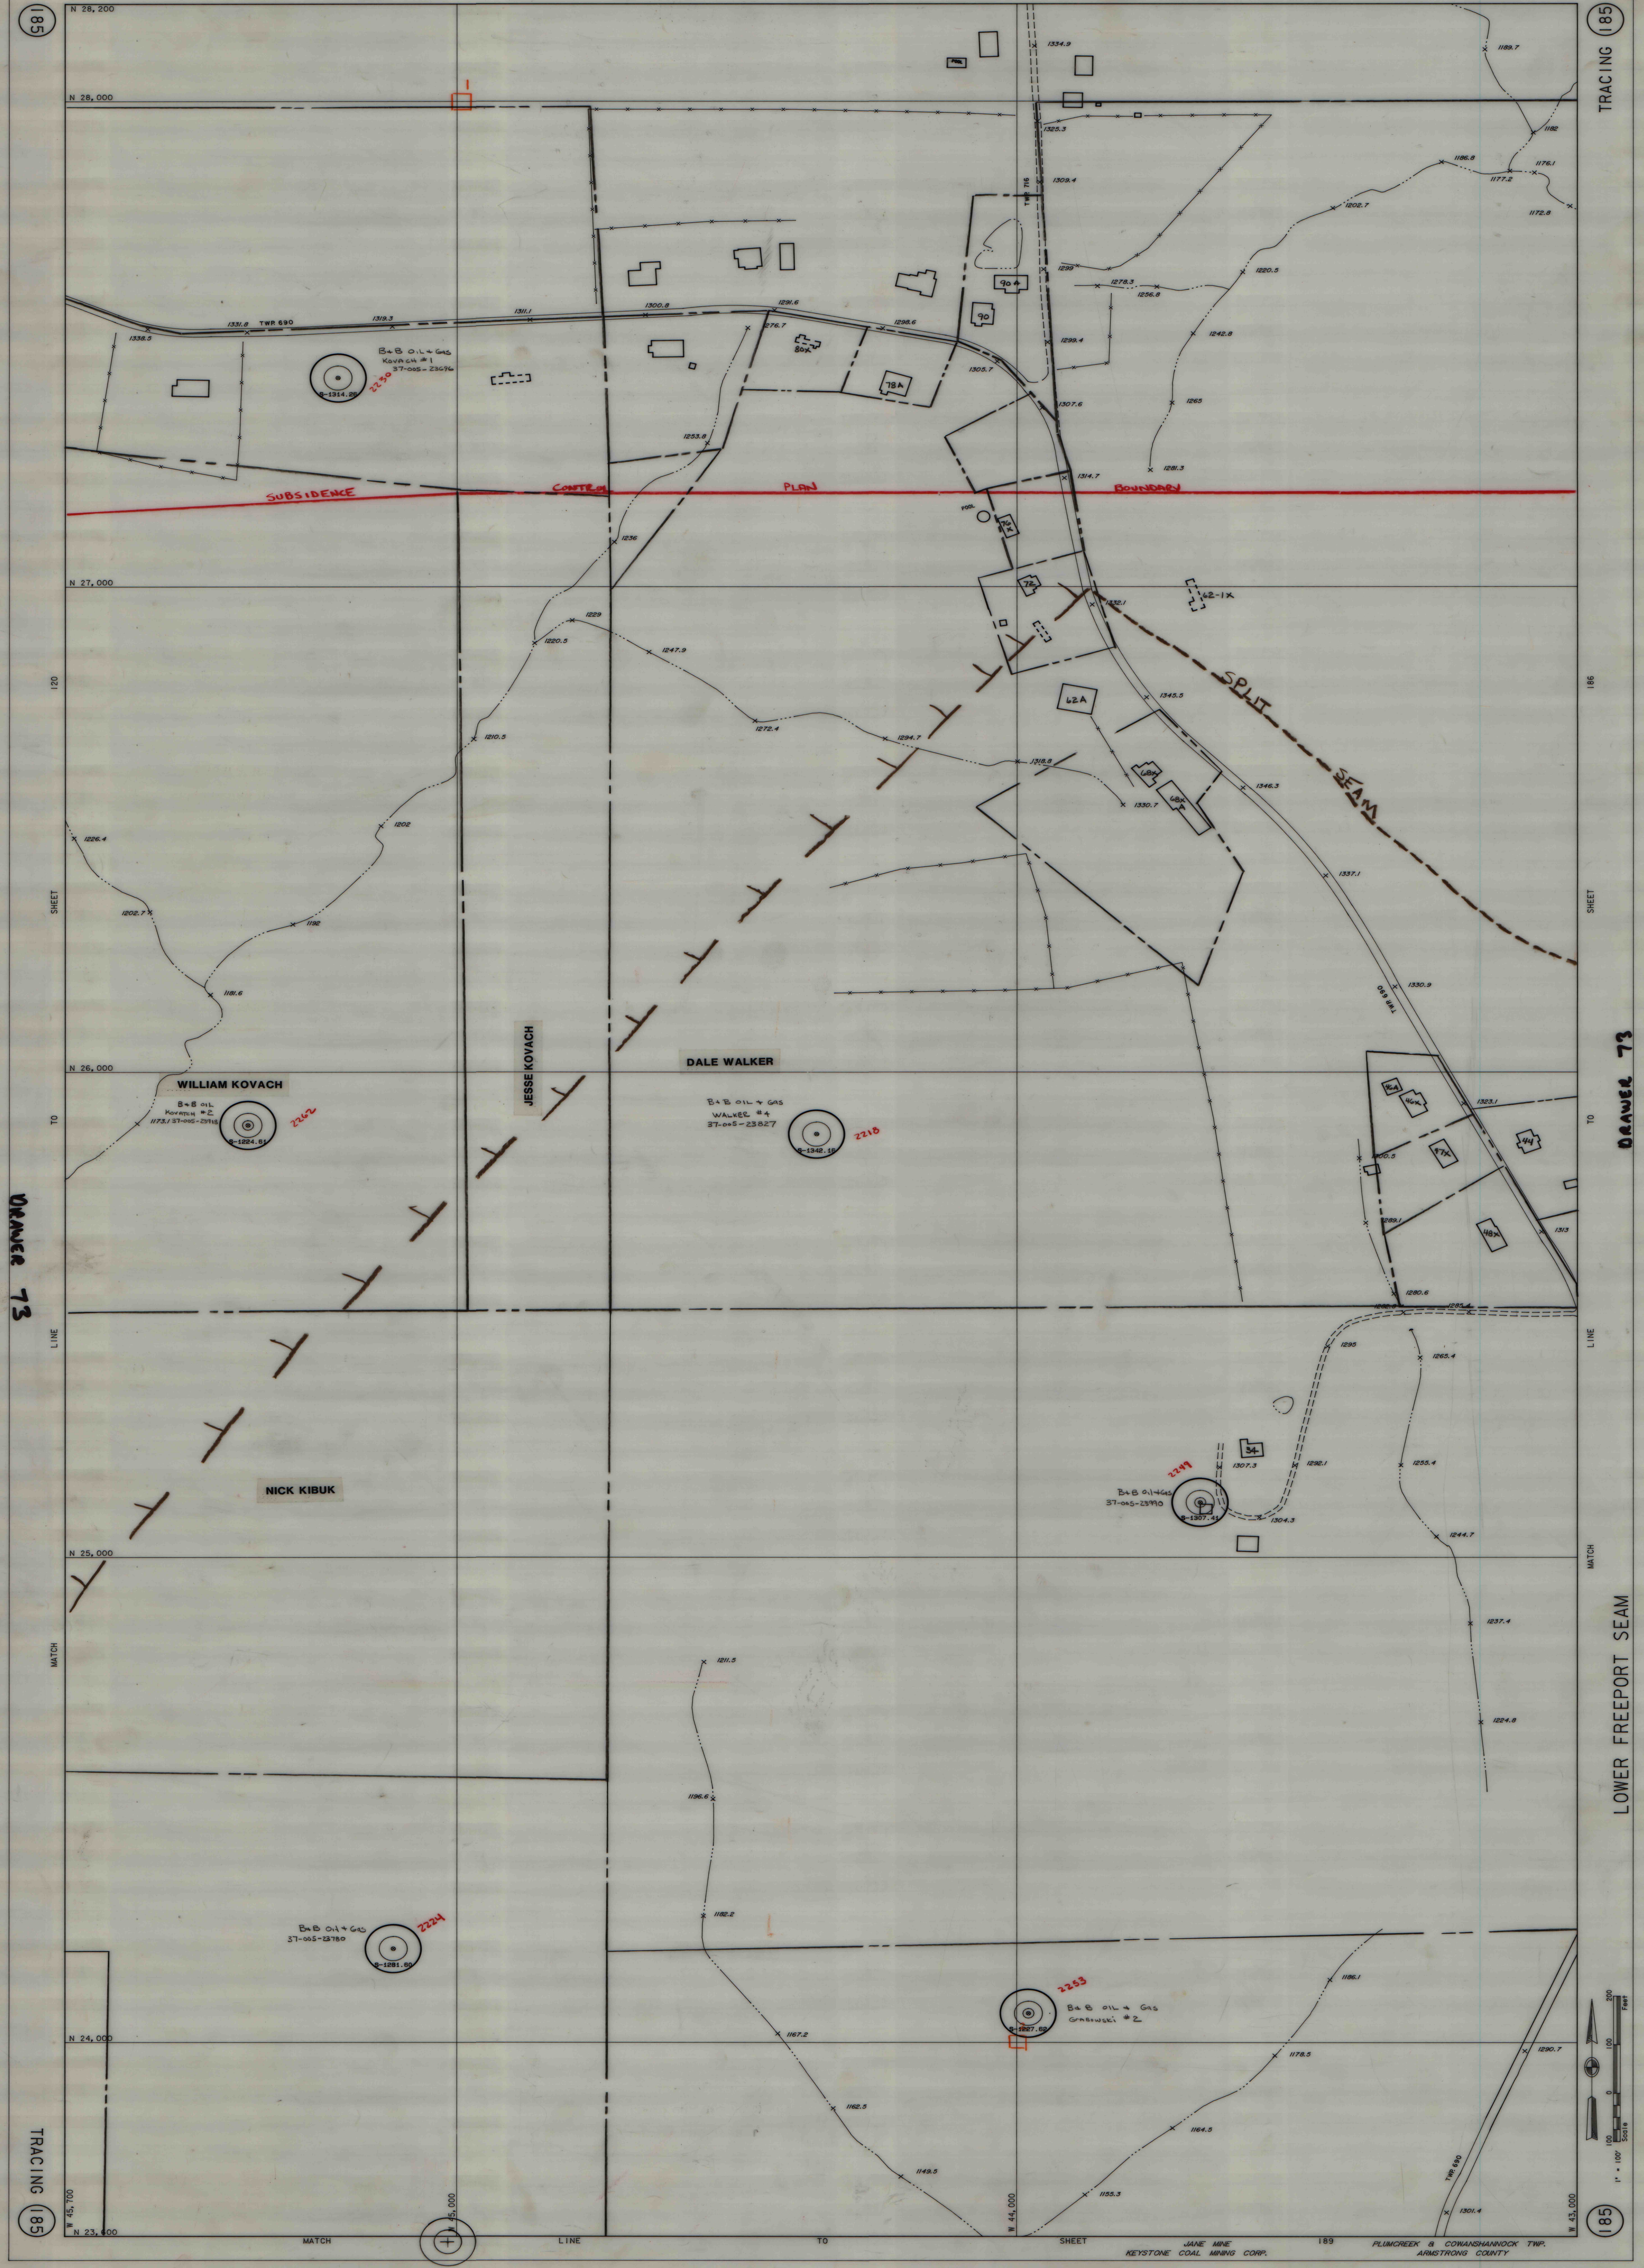

DRAWER 73

DRAWER 73

LOWER FREEPORT SEAM