


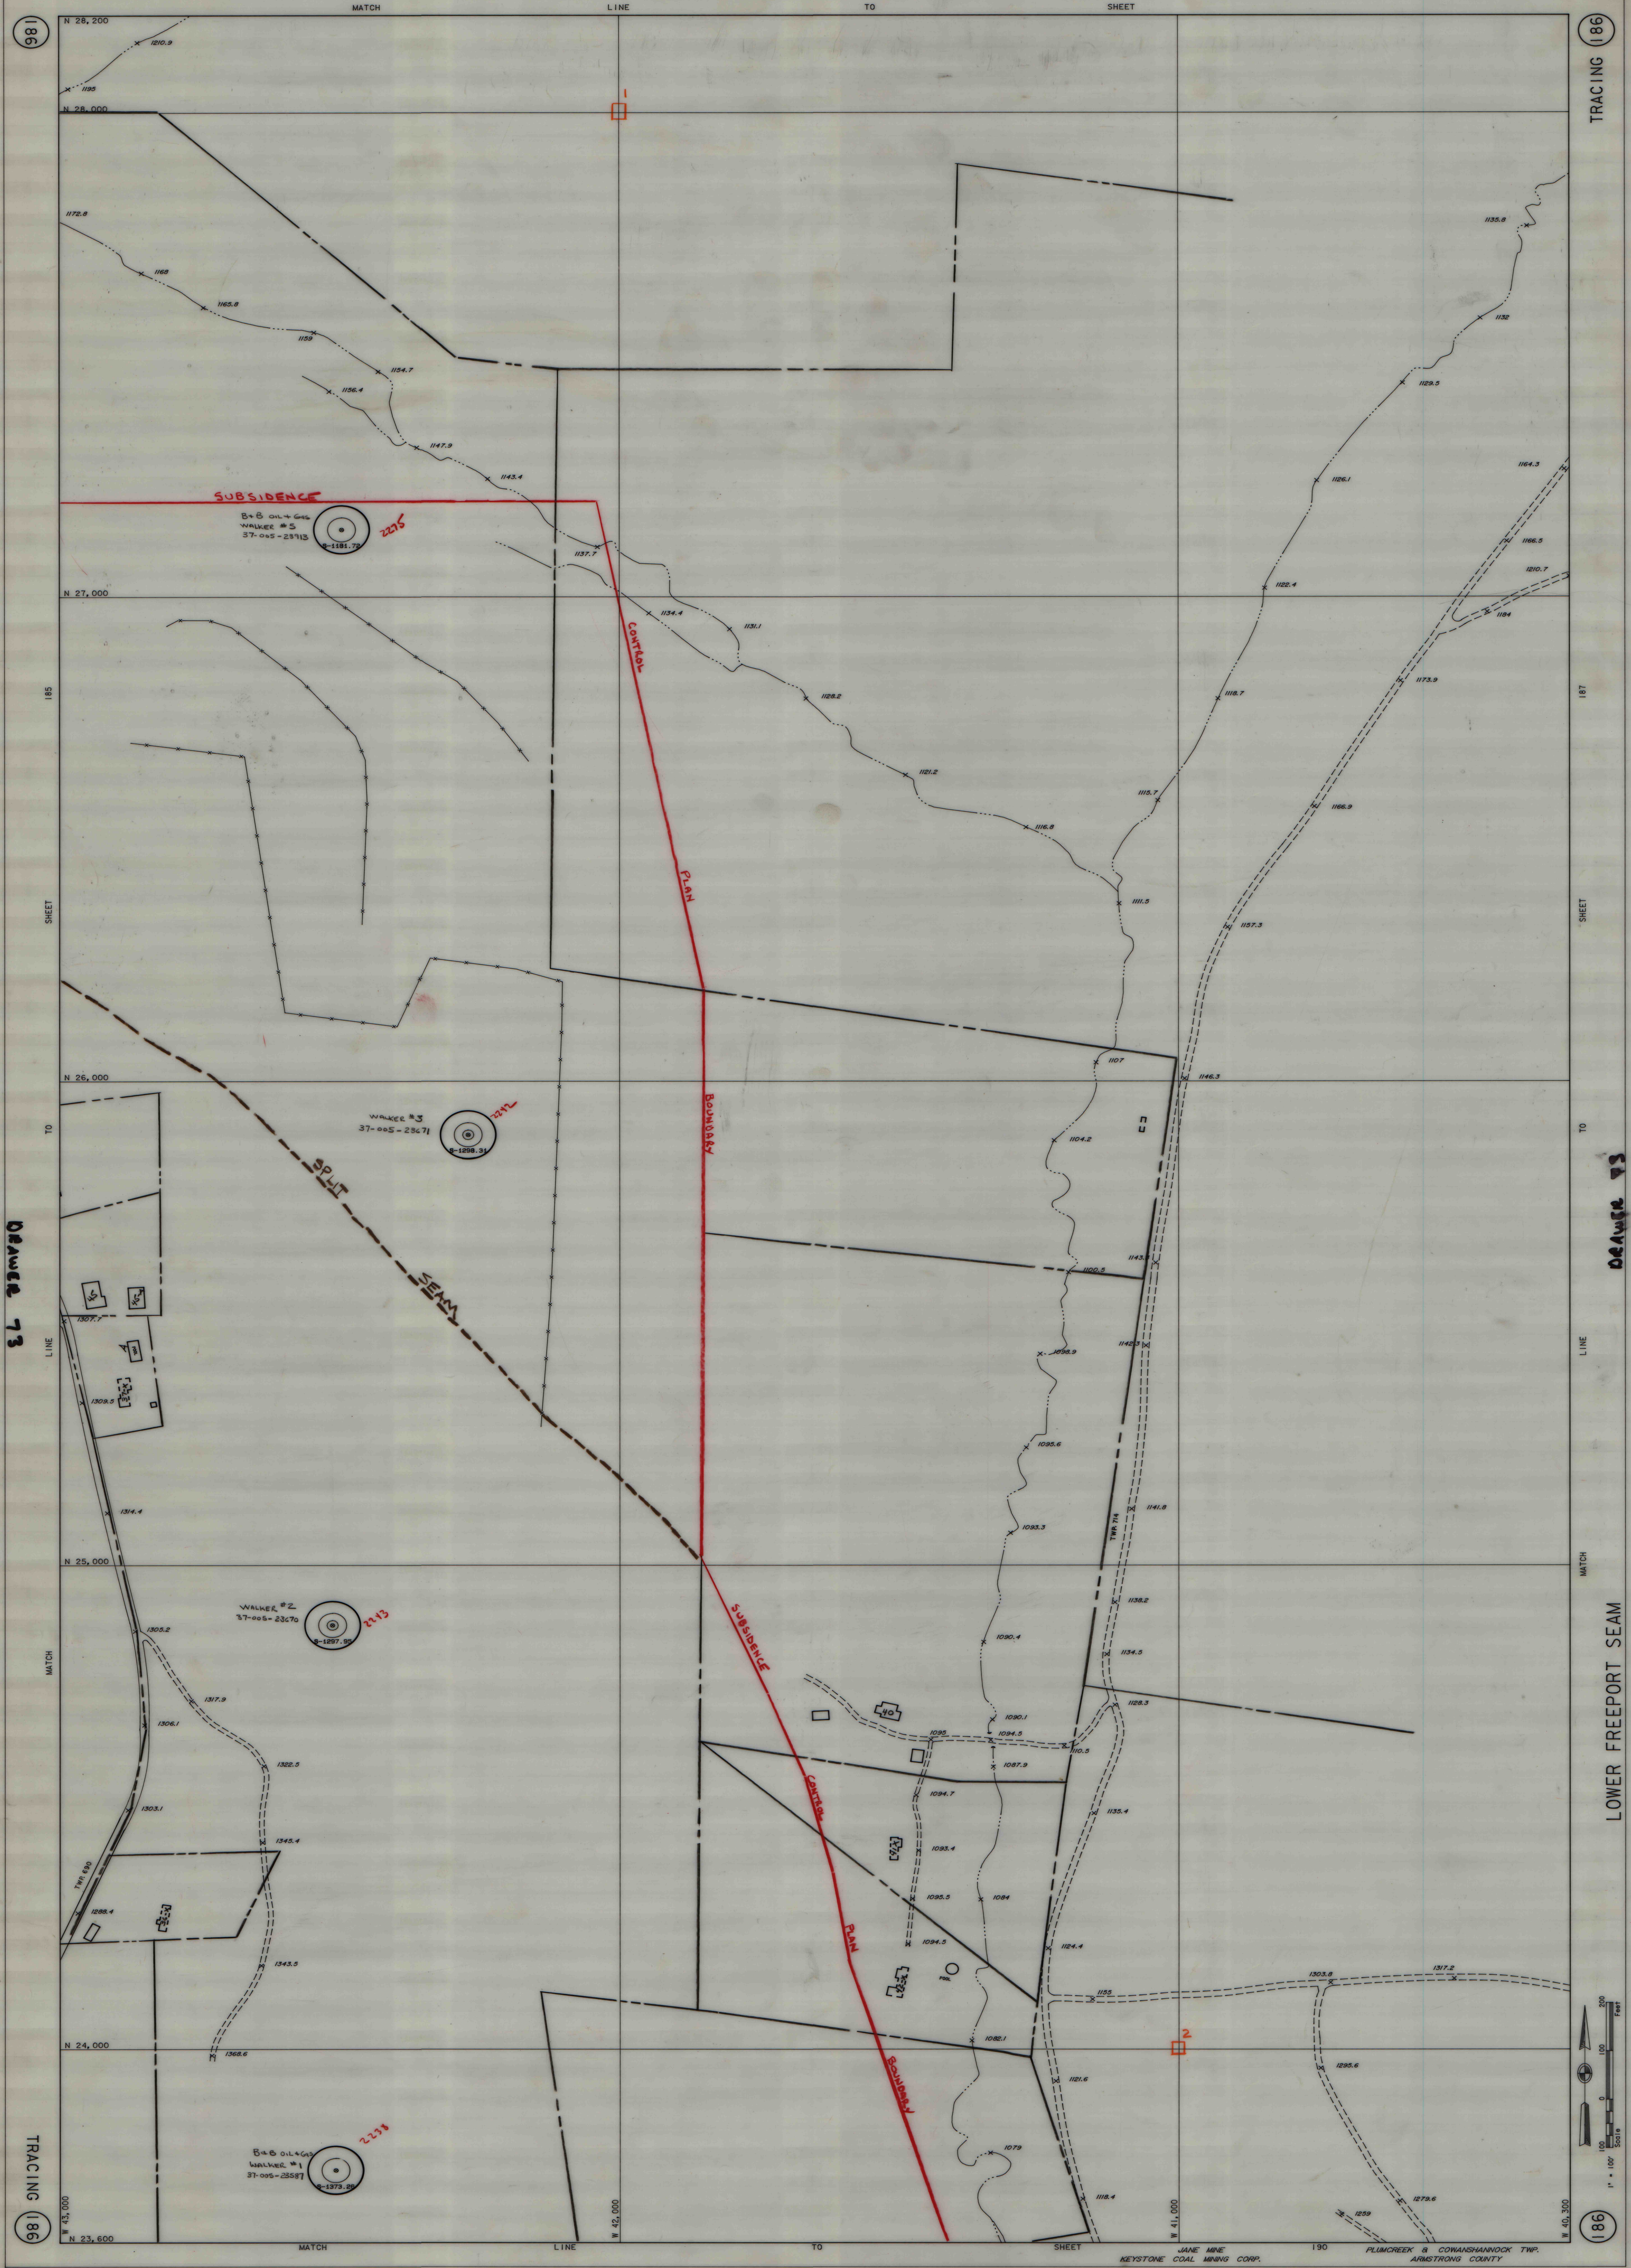

186

TRACING 186



TRACING 186

186

LOWER FREEPORT SEAM

