


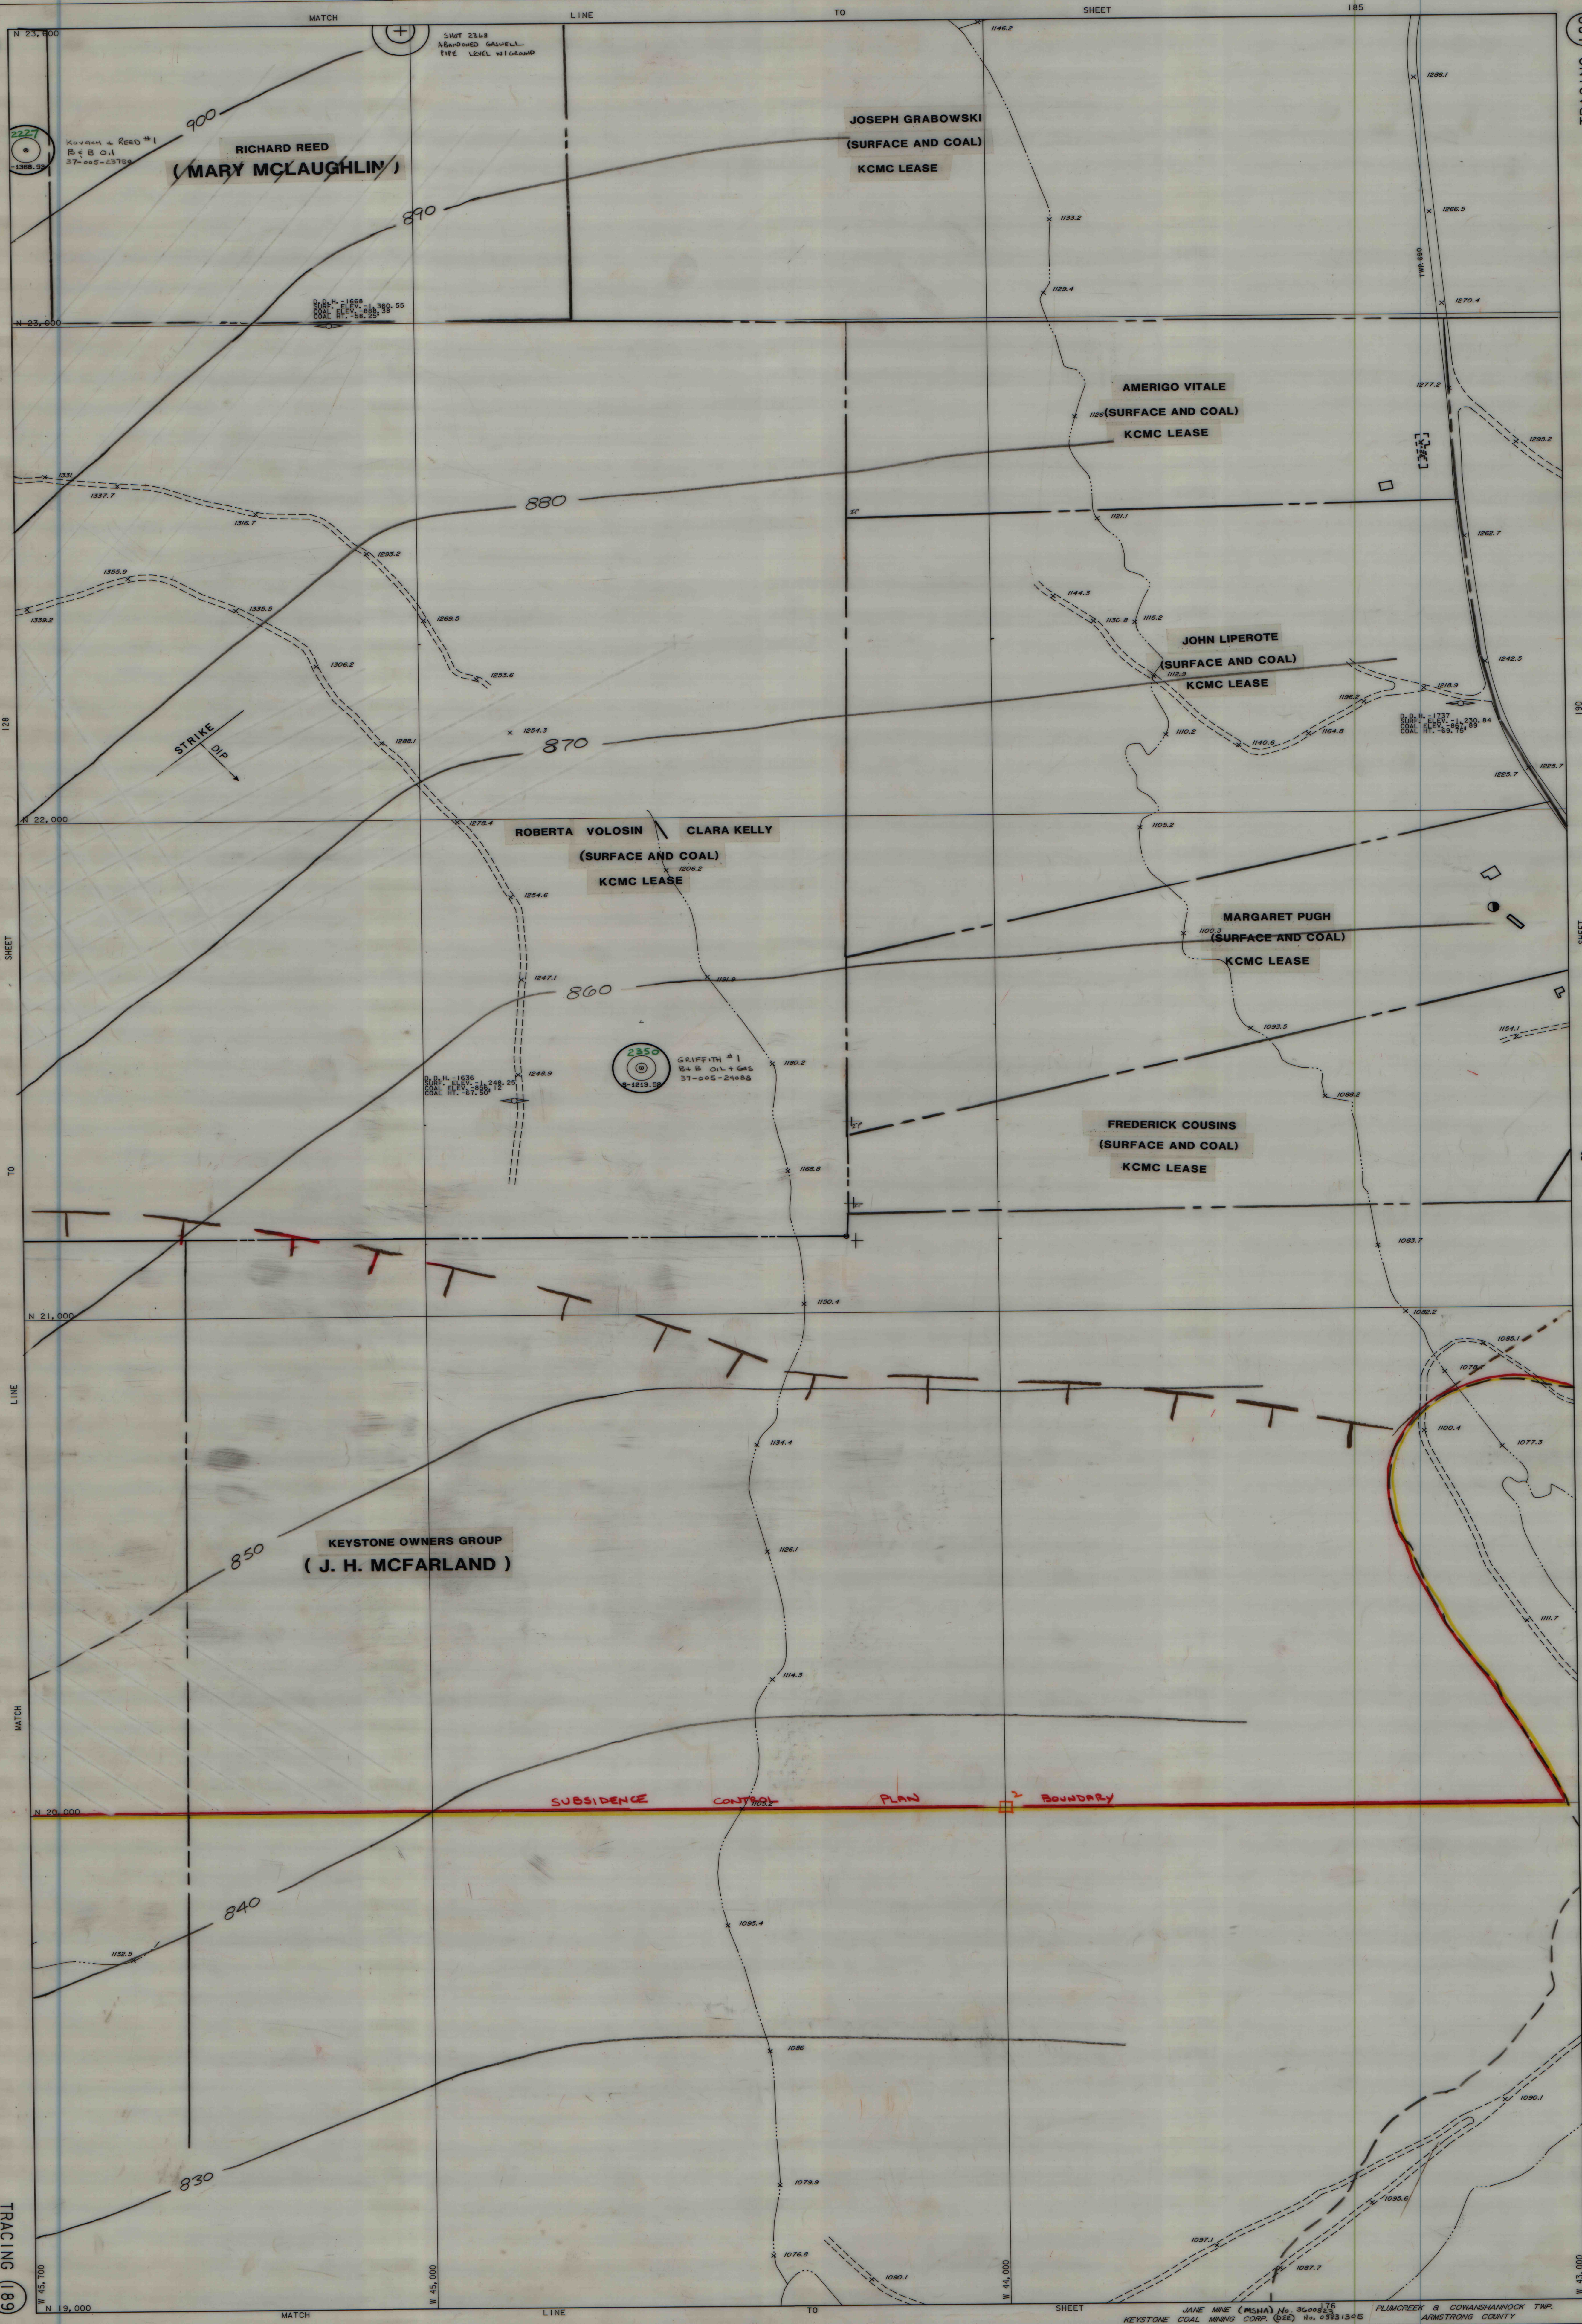

JANE MINE (MSHA) No. 369885  
KEYSTONE COAL MINING CORP. (S&D) No. 53831305  
PLUMCREEK & COWANSHANNOCK TWP.  
ARMSTRONG COUNTY

