


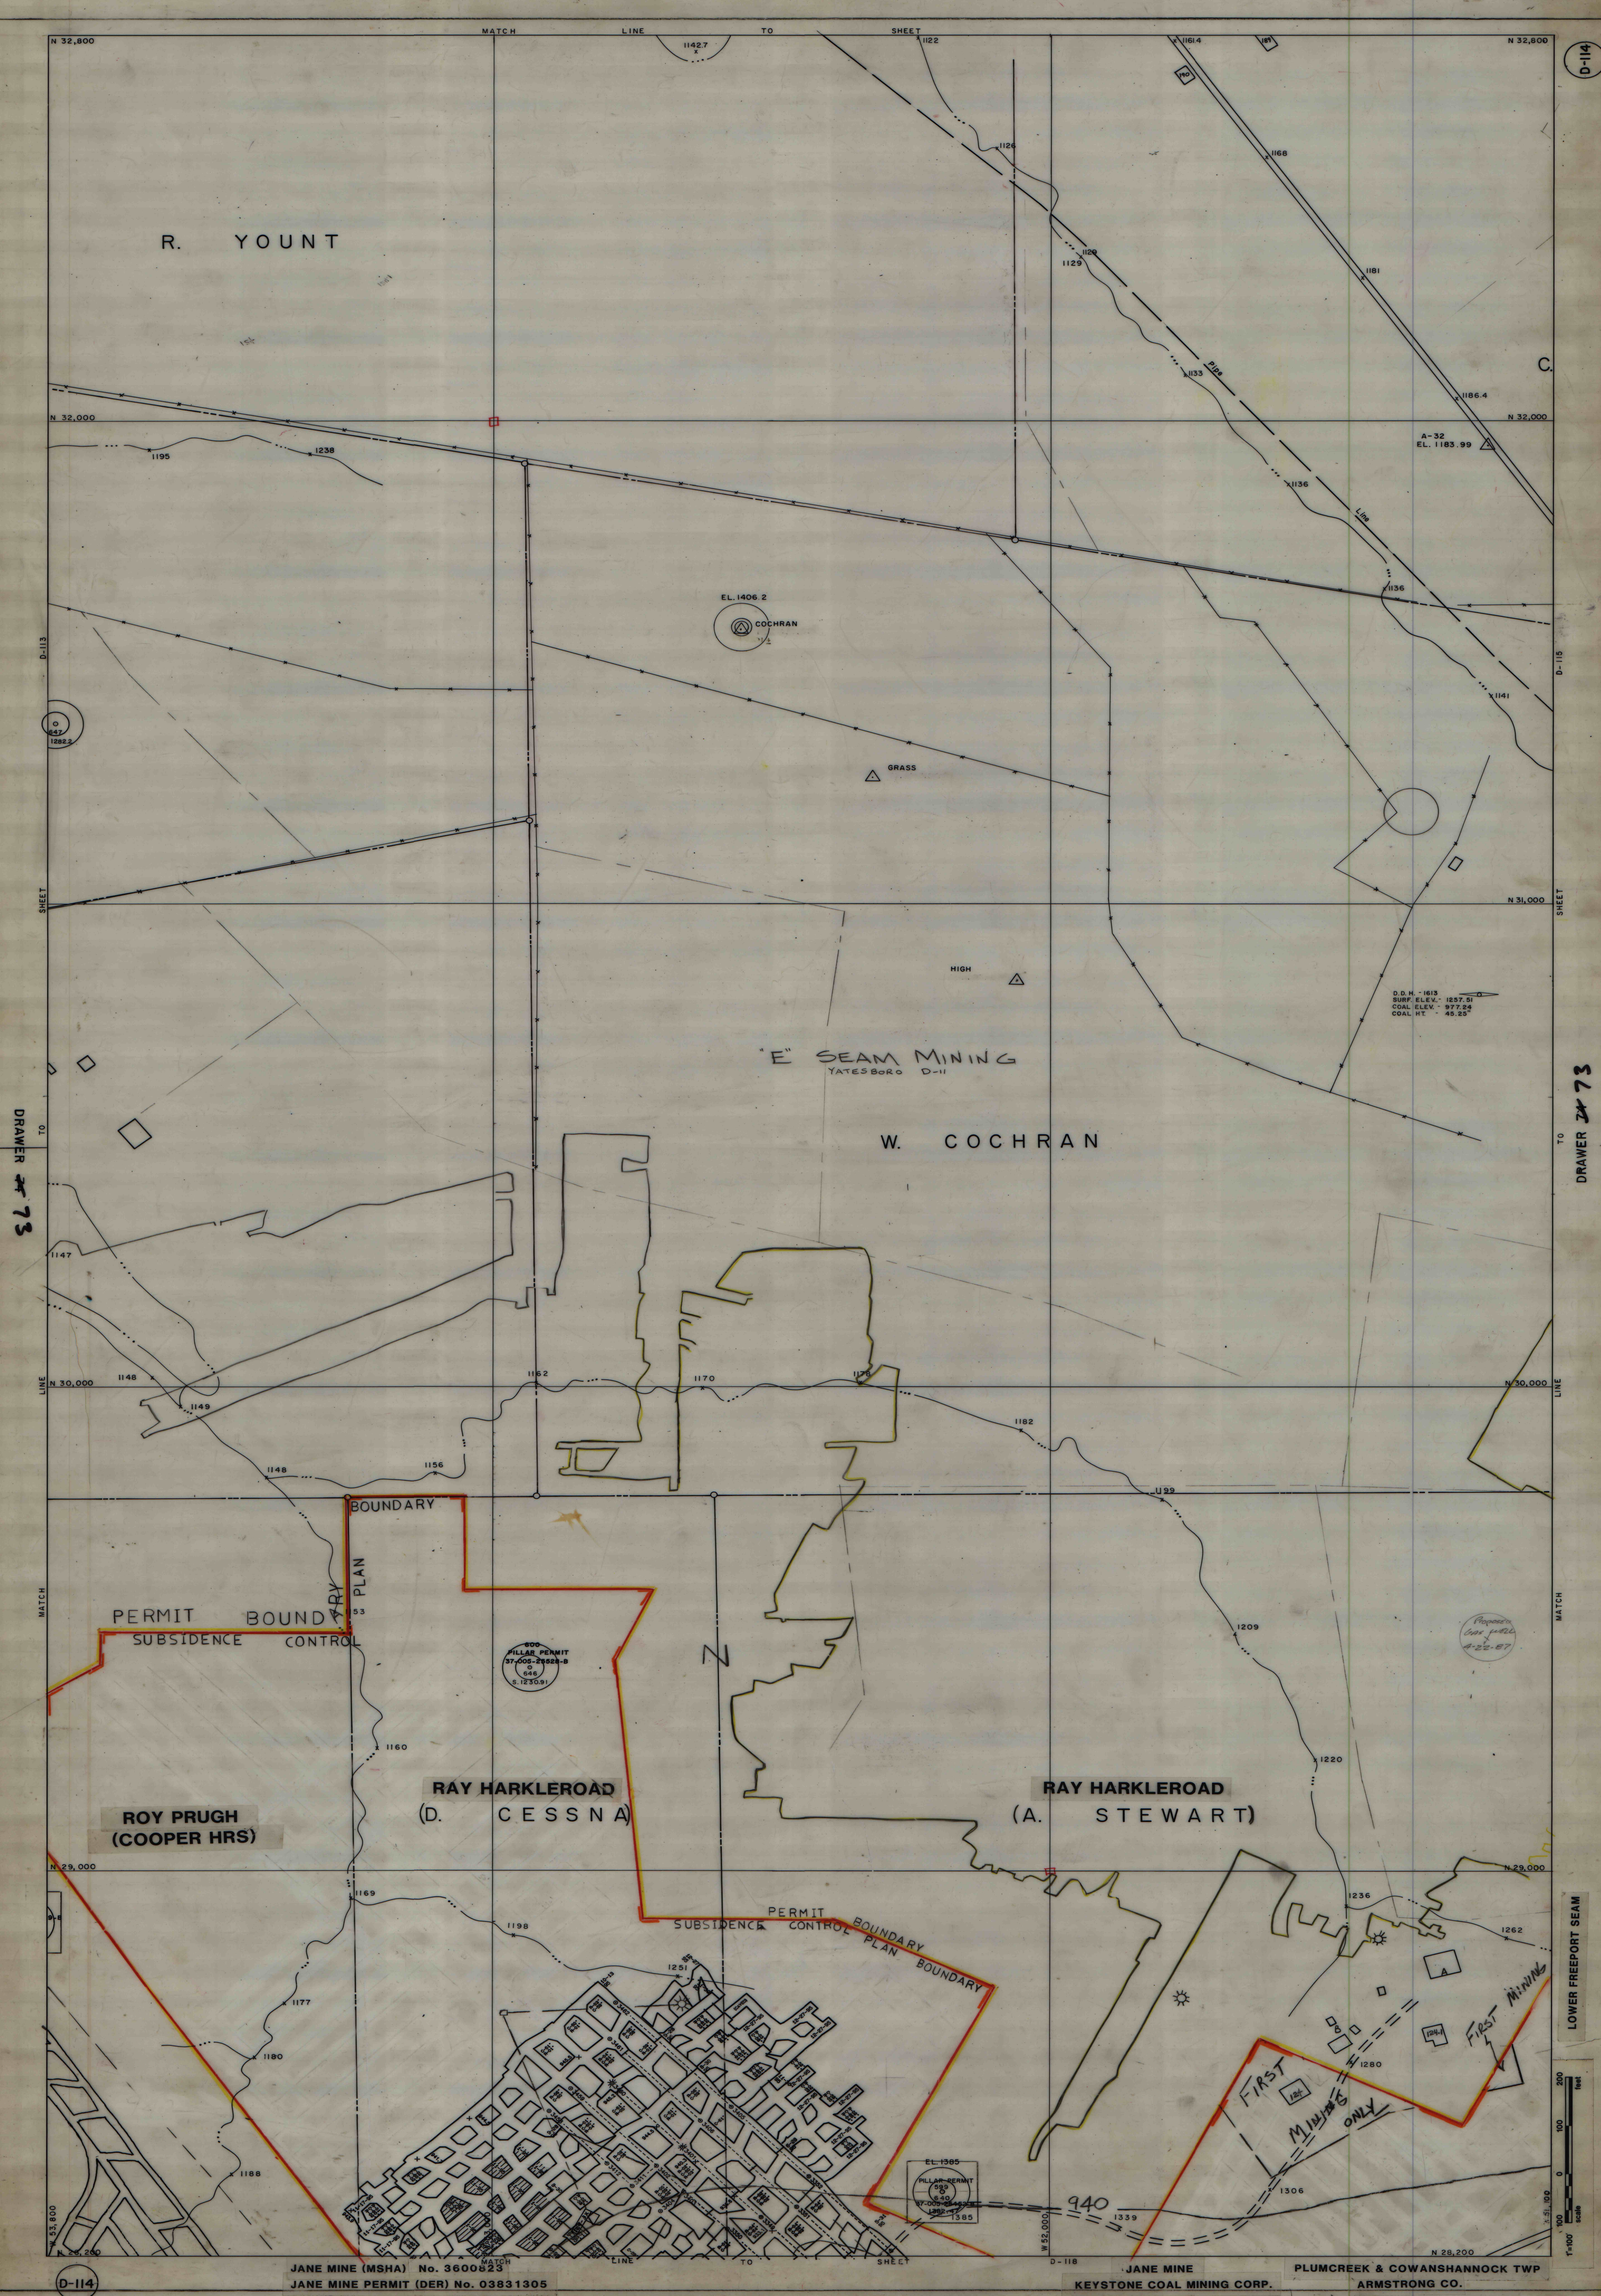

DRAWER 73

DRAWER 73

R. YOUNT

W. COCHRAN

ROY PRUGH
(COOPER HRS)

RAY HARKLEROAD
(D. CESSNA)

RAY HARKLEROAD
(A. STEWART)

E SEAM MINING
YATESBORO D-11

JANE MINE (MSHA) No. 3600823
JANE MINE PERMIT (DER) No. 03831305

JANE MINE
KEYSTONE COAL MINING CORP.

PLUMCREEK & COWANSHANNOCK TWP
ARMSTRONG CO.

LOWER FREEPORT SEAM

