


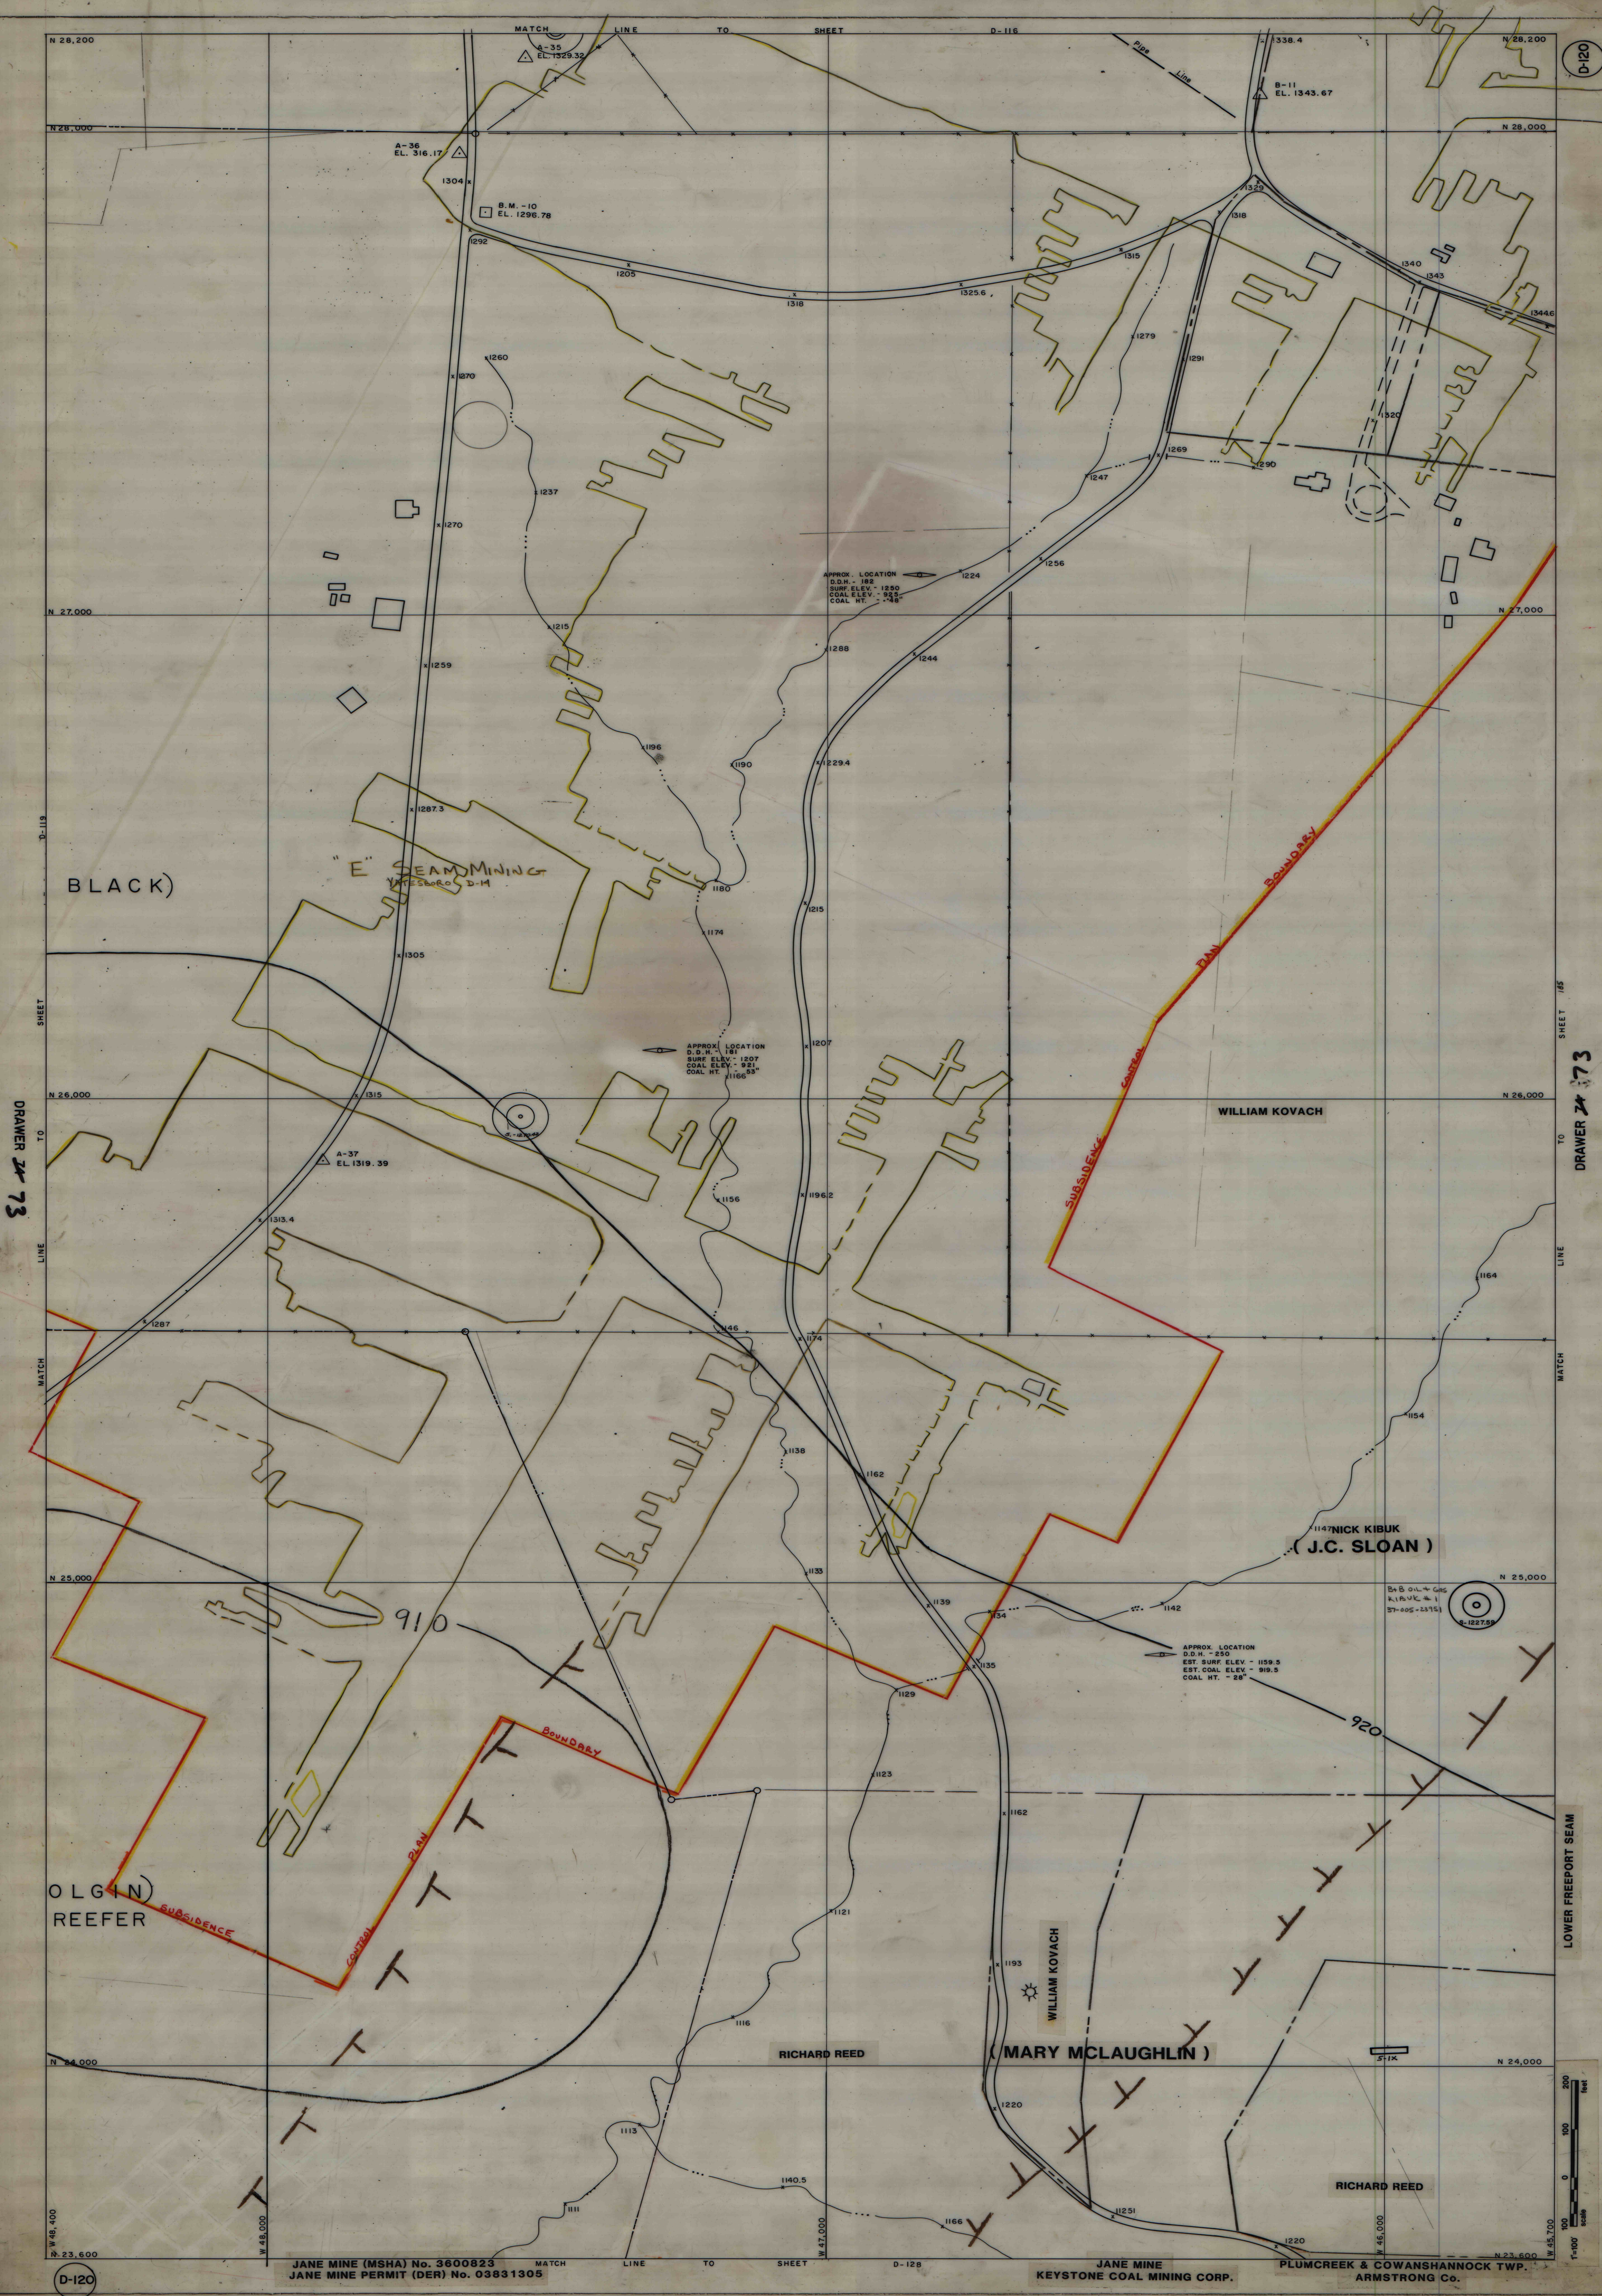

DRAWER 73

DRAWER 73

JANE MINE (MSHA) No. 3600823
JANE MINE PERMIT (DER) No. 03831305

JANE MINE
KEYSTONE COAL MINING CORP.

PLUMCREEK & COWANSHANNOCK TWP.
ARMSTRONG Co.