


Drawer 73

Drawer 73

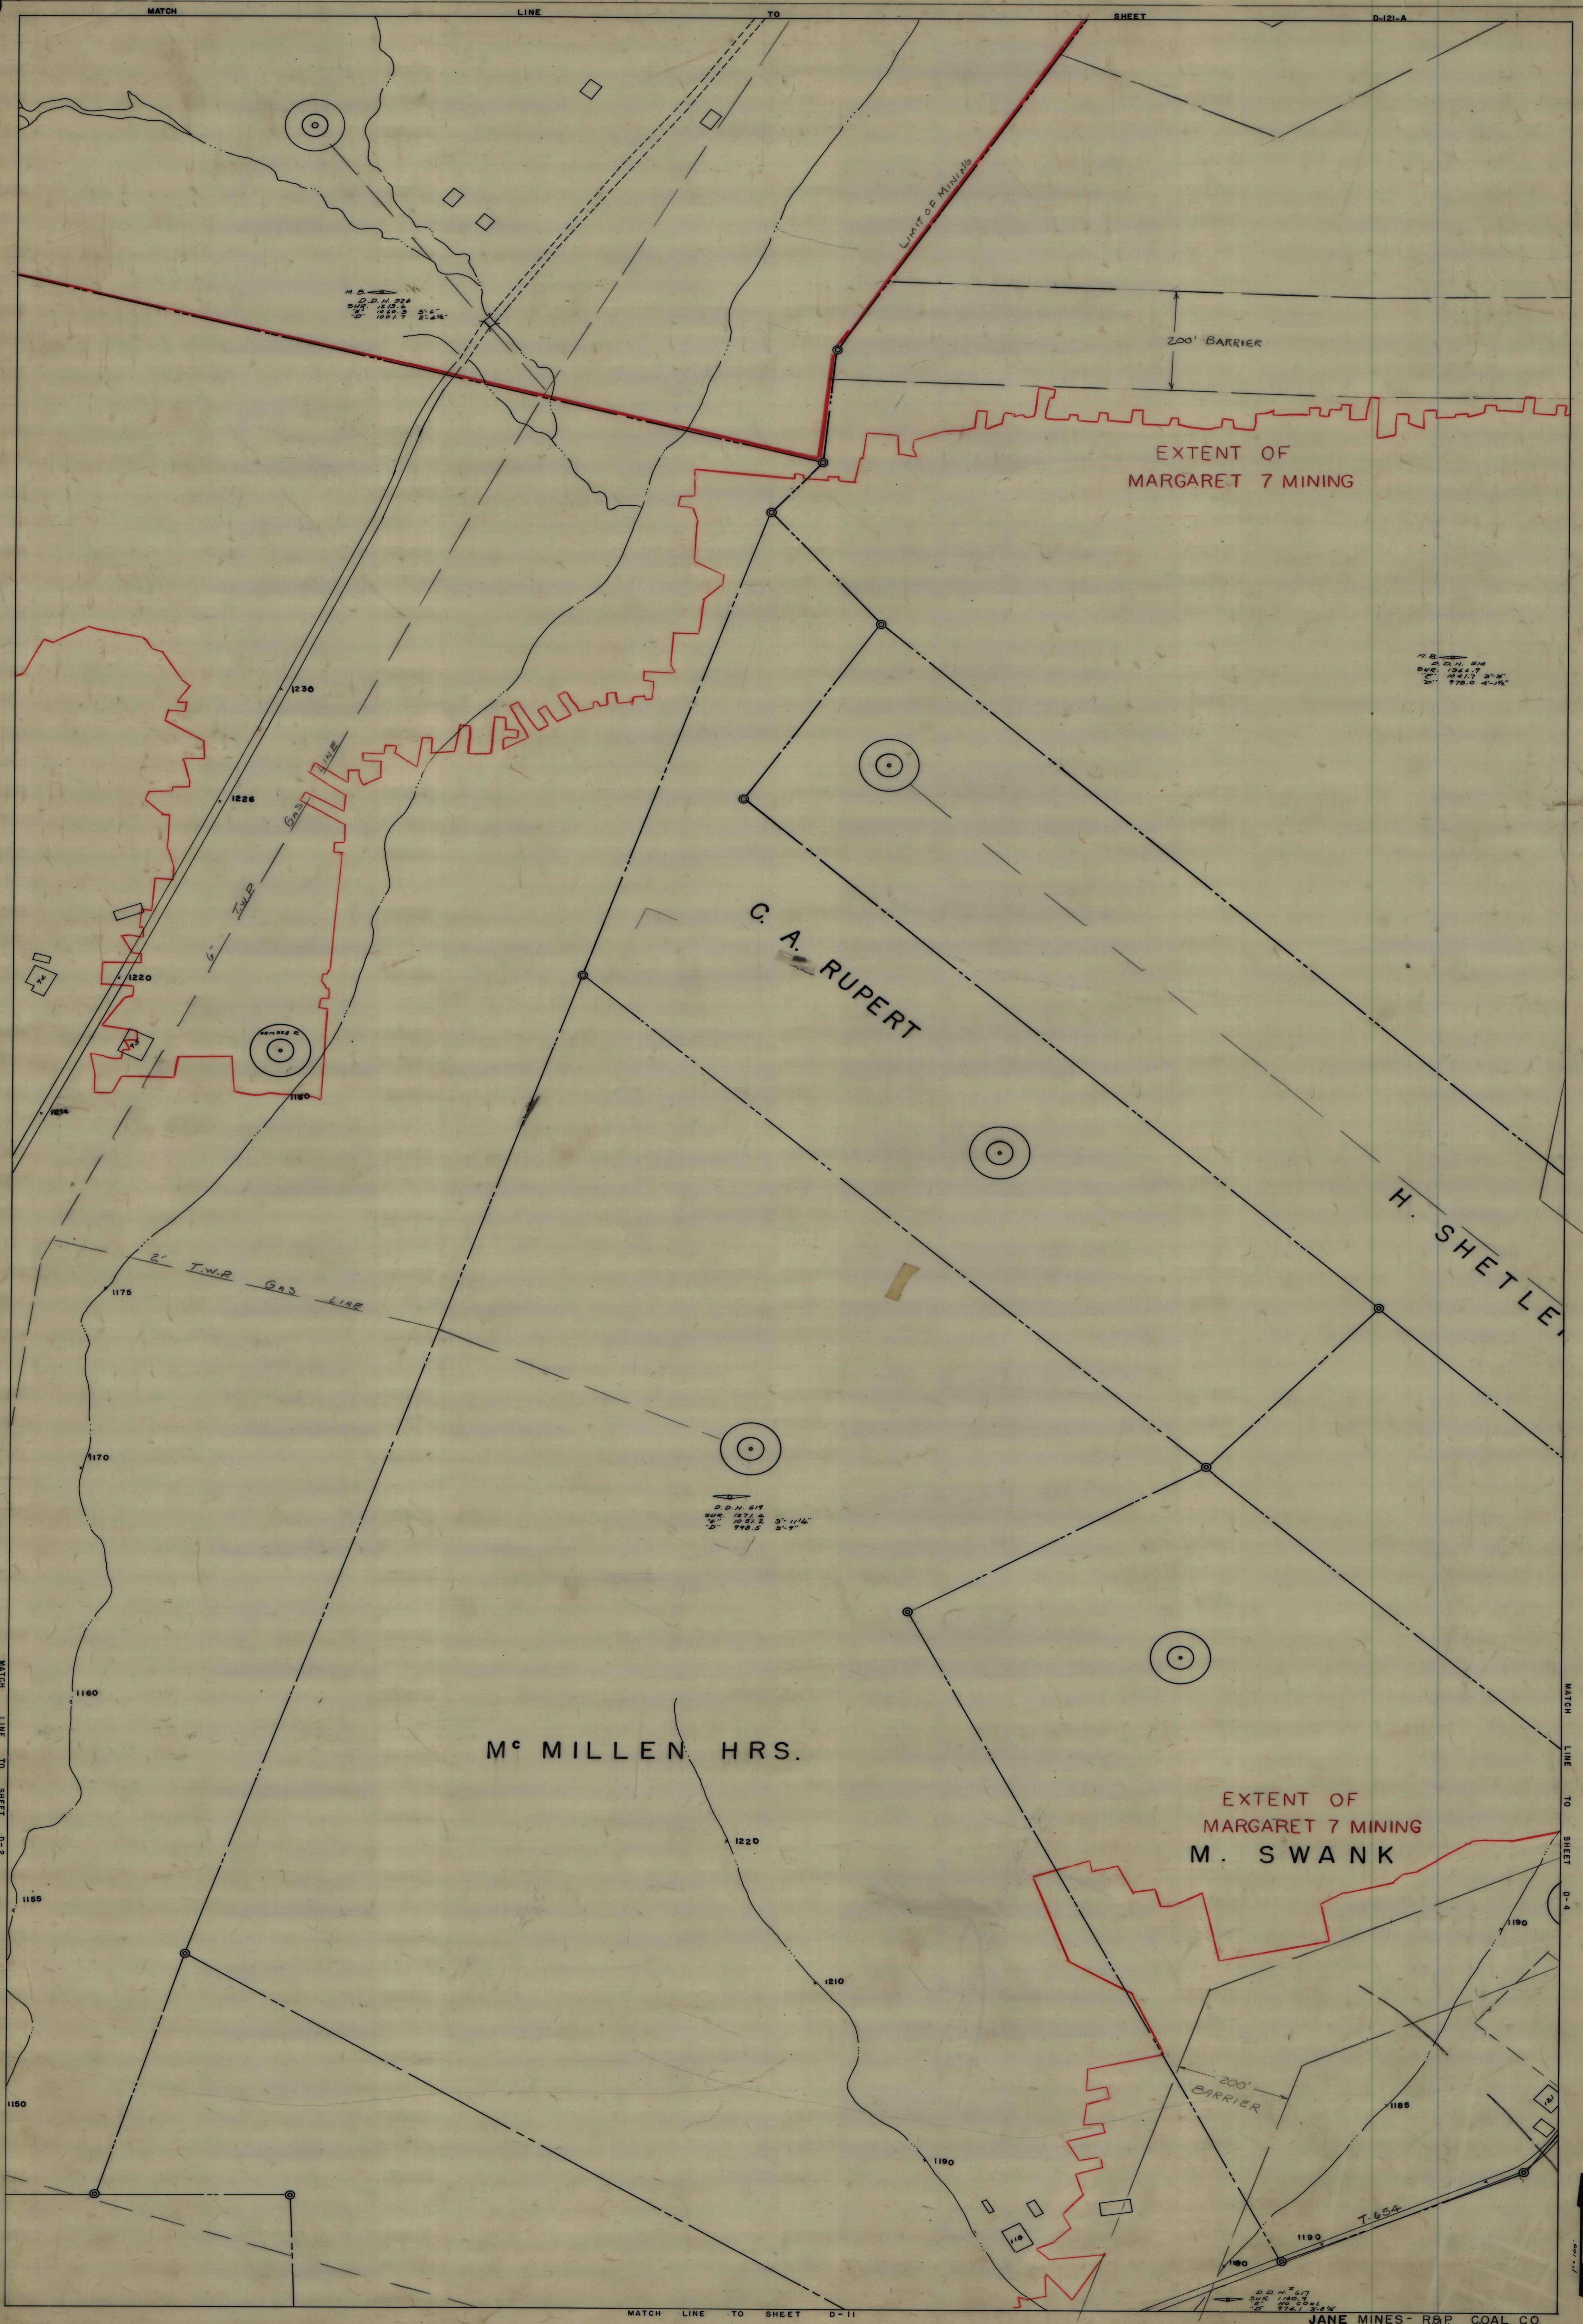

JANE MINES - R&P COAL CO
PLUMCREEK TWP - ARMSTRONG CO.