


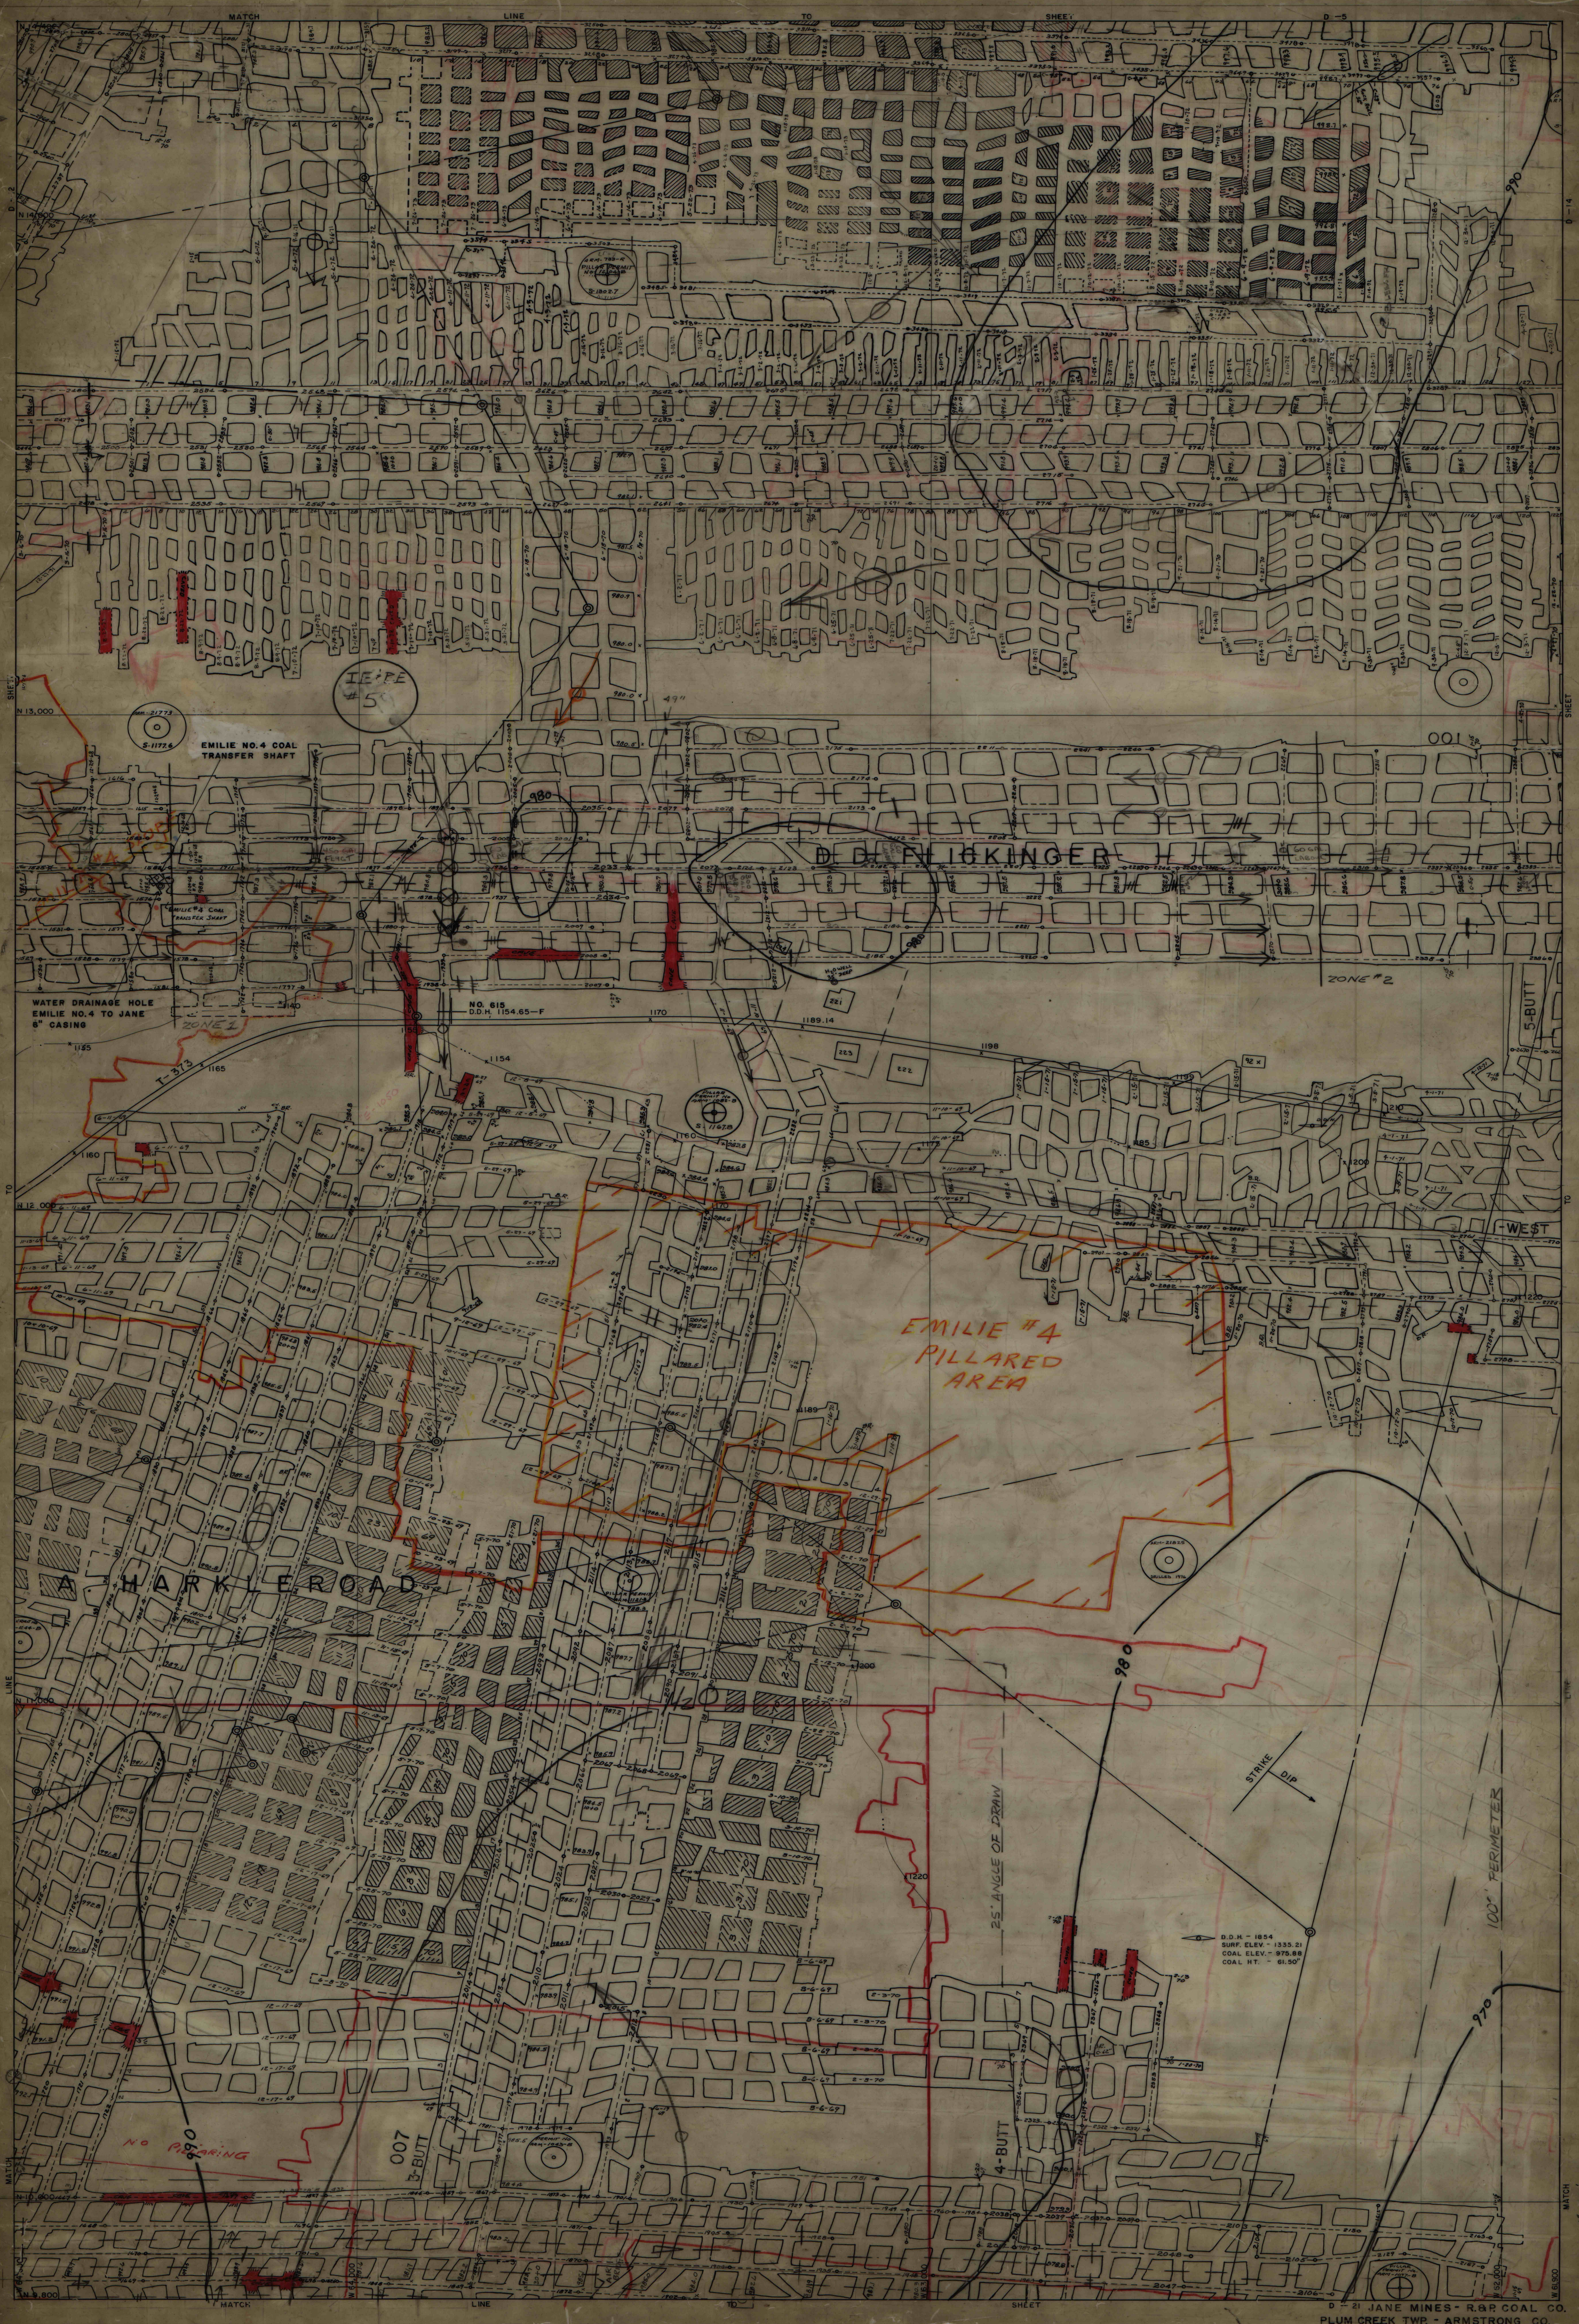

D.D.H. - 1854
SURF. ELEV. - 1335.21
COAL ELEV. - 975.88
COAL HT. - 61.90'

