

F-17

F17

TRACING

DRAWER 73

F17

APPROX. LOCATION
D.D.H. - 682
SURF. ELEV. - 1145.0
COAL ELEV. - 875.5
COAL HT. - 25.0'

EXTENT OF
MARGARET II MINING

E. BOARTZ

J. BOYER



APPROX. LOCATION
D.D.H. - 676
SURF. ELEV. - 1235.0
COAL ELEV. - 909.67
COAL HT. - 15.0'

EXTENT OF
MARGARET II MINING

J. T. ROBB

LIMIT OF MINING
JANE

JANF NO. II MINE - R. & P. COAL CO.
PLUM CREEK TWP. - ARMSTRONG CO.

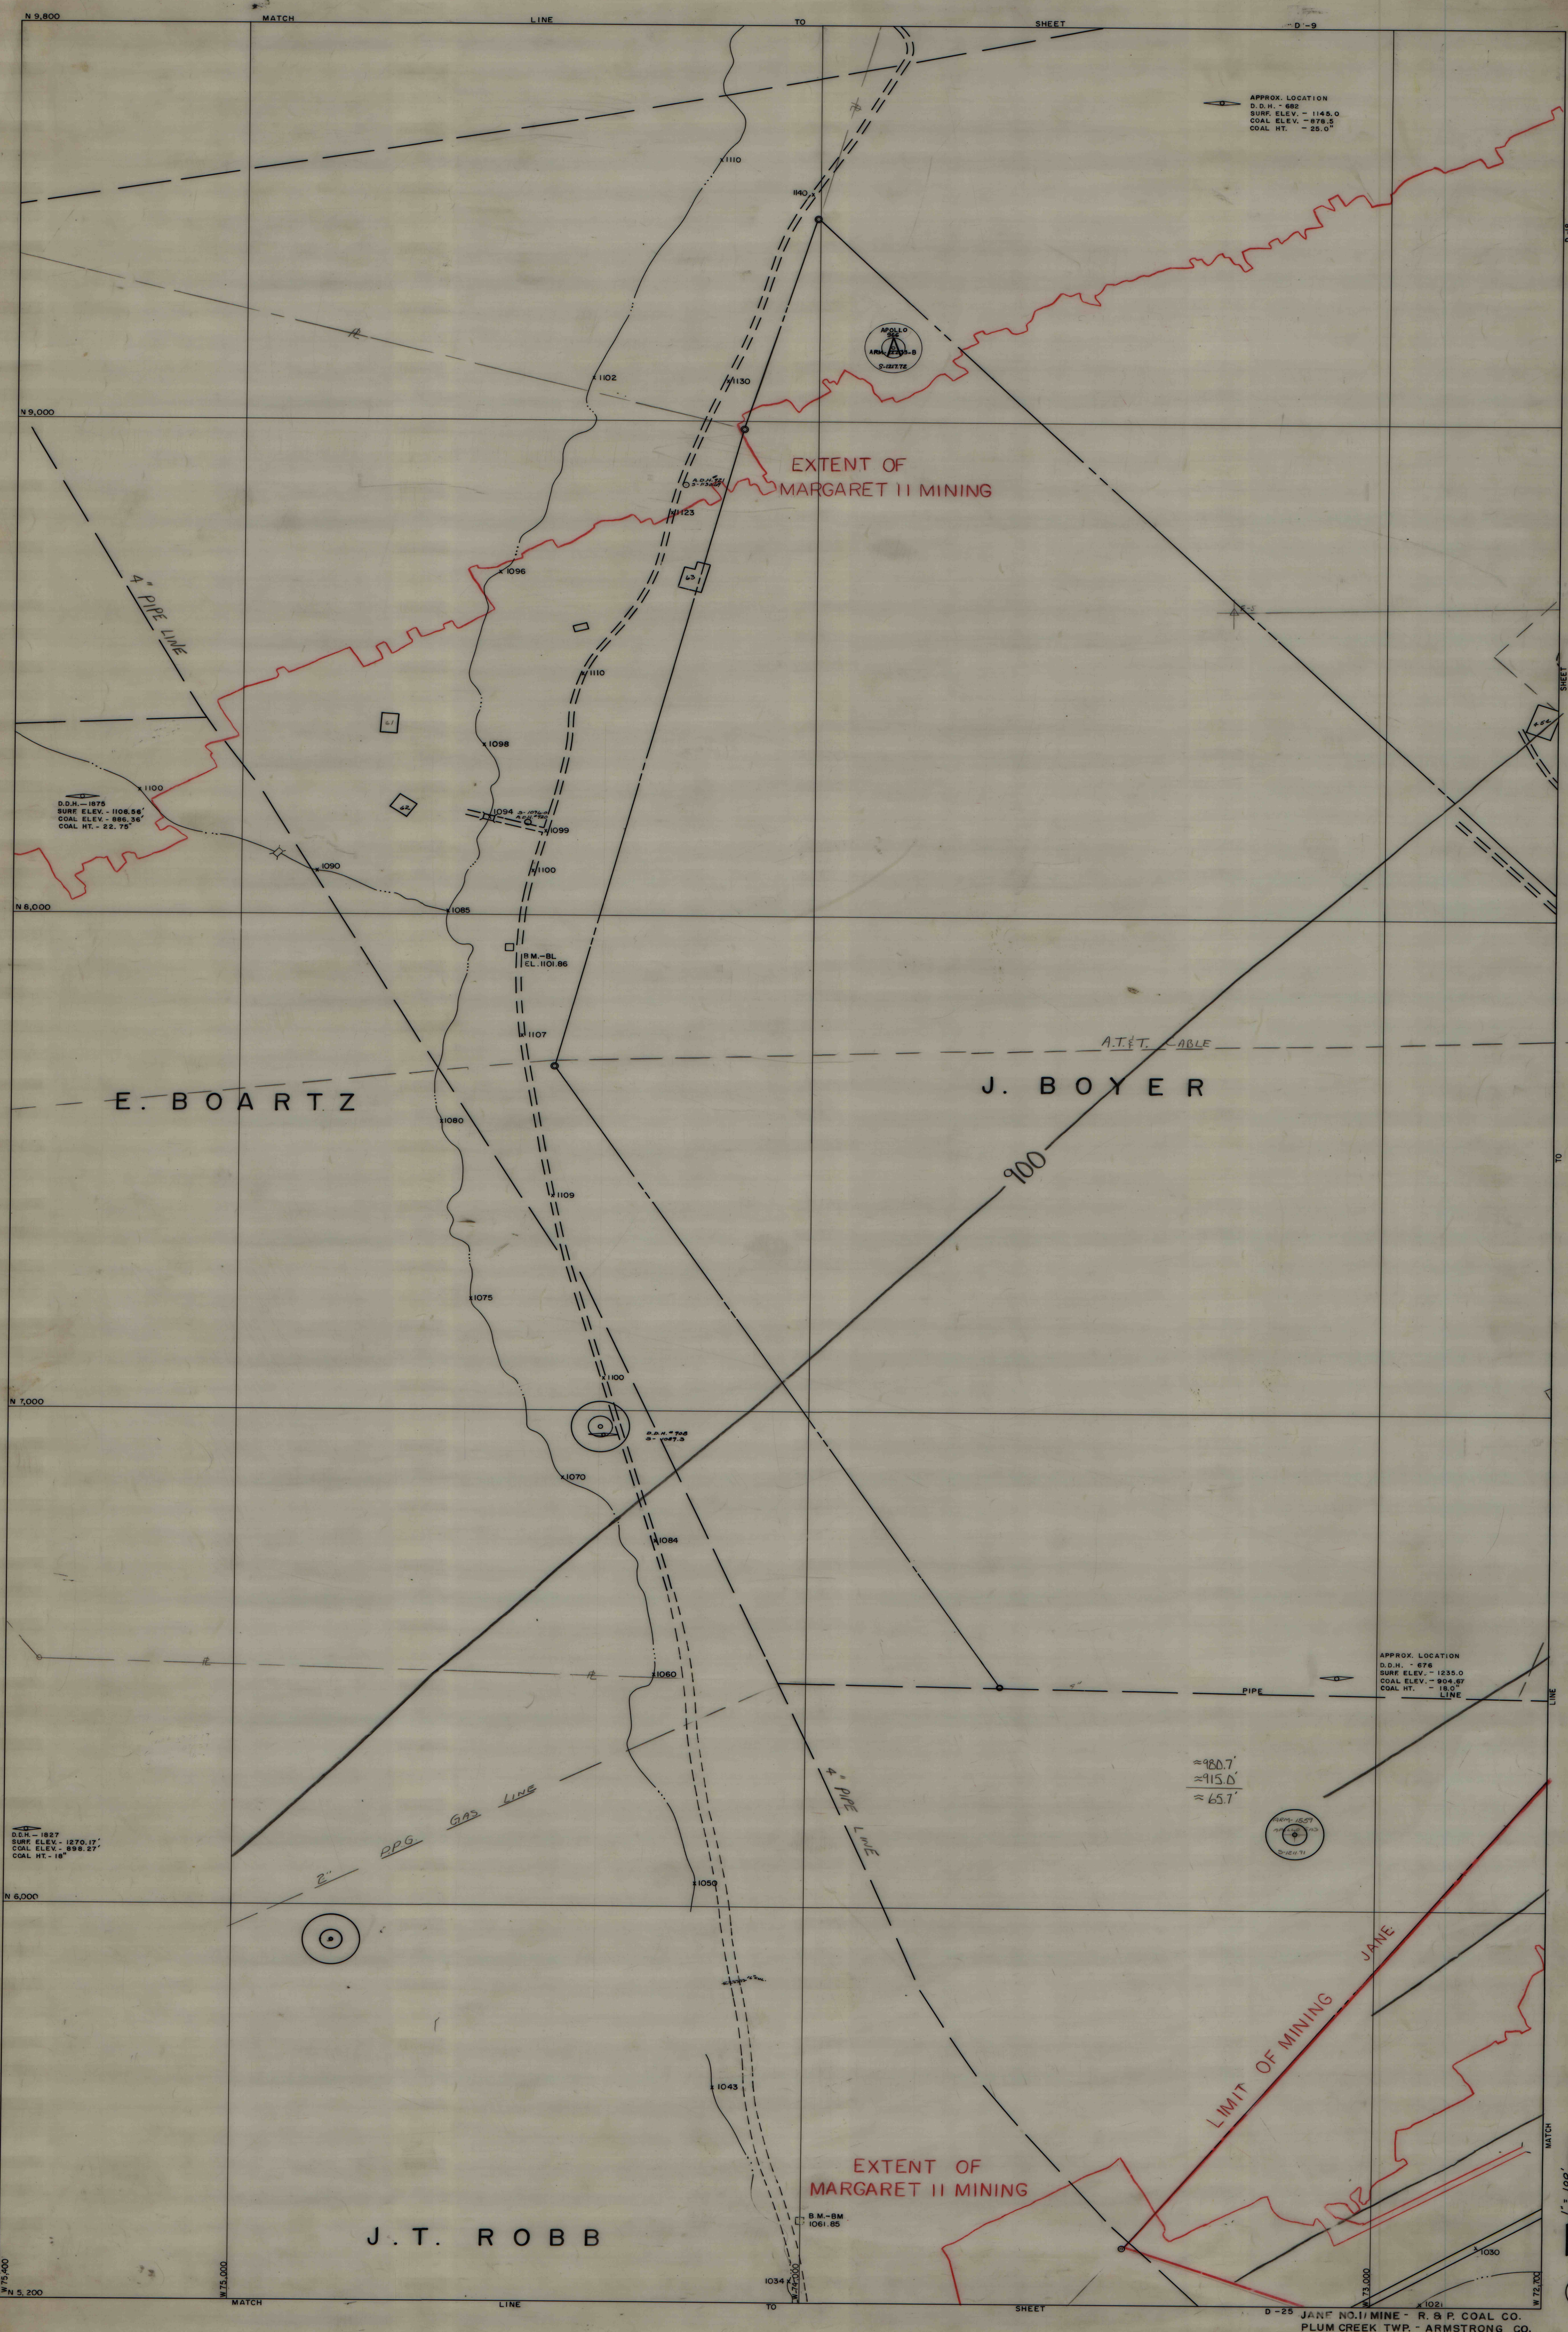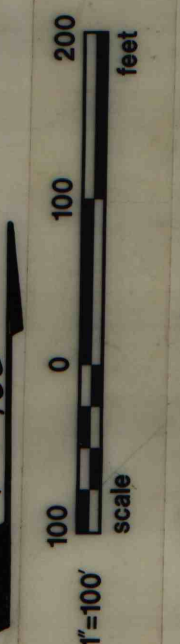

DRAWER 73

TRACING F-17