


F-35

F-35

Drawer 73

Drawer 73

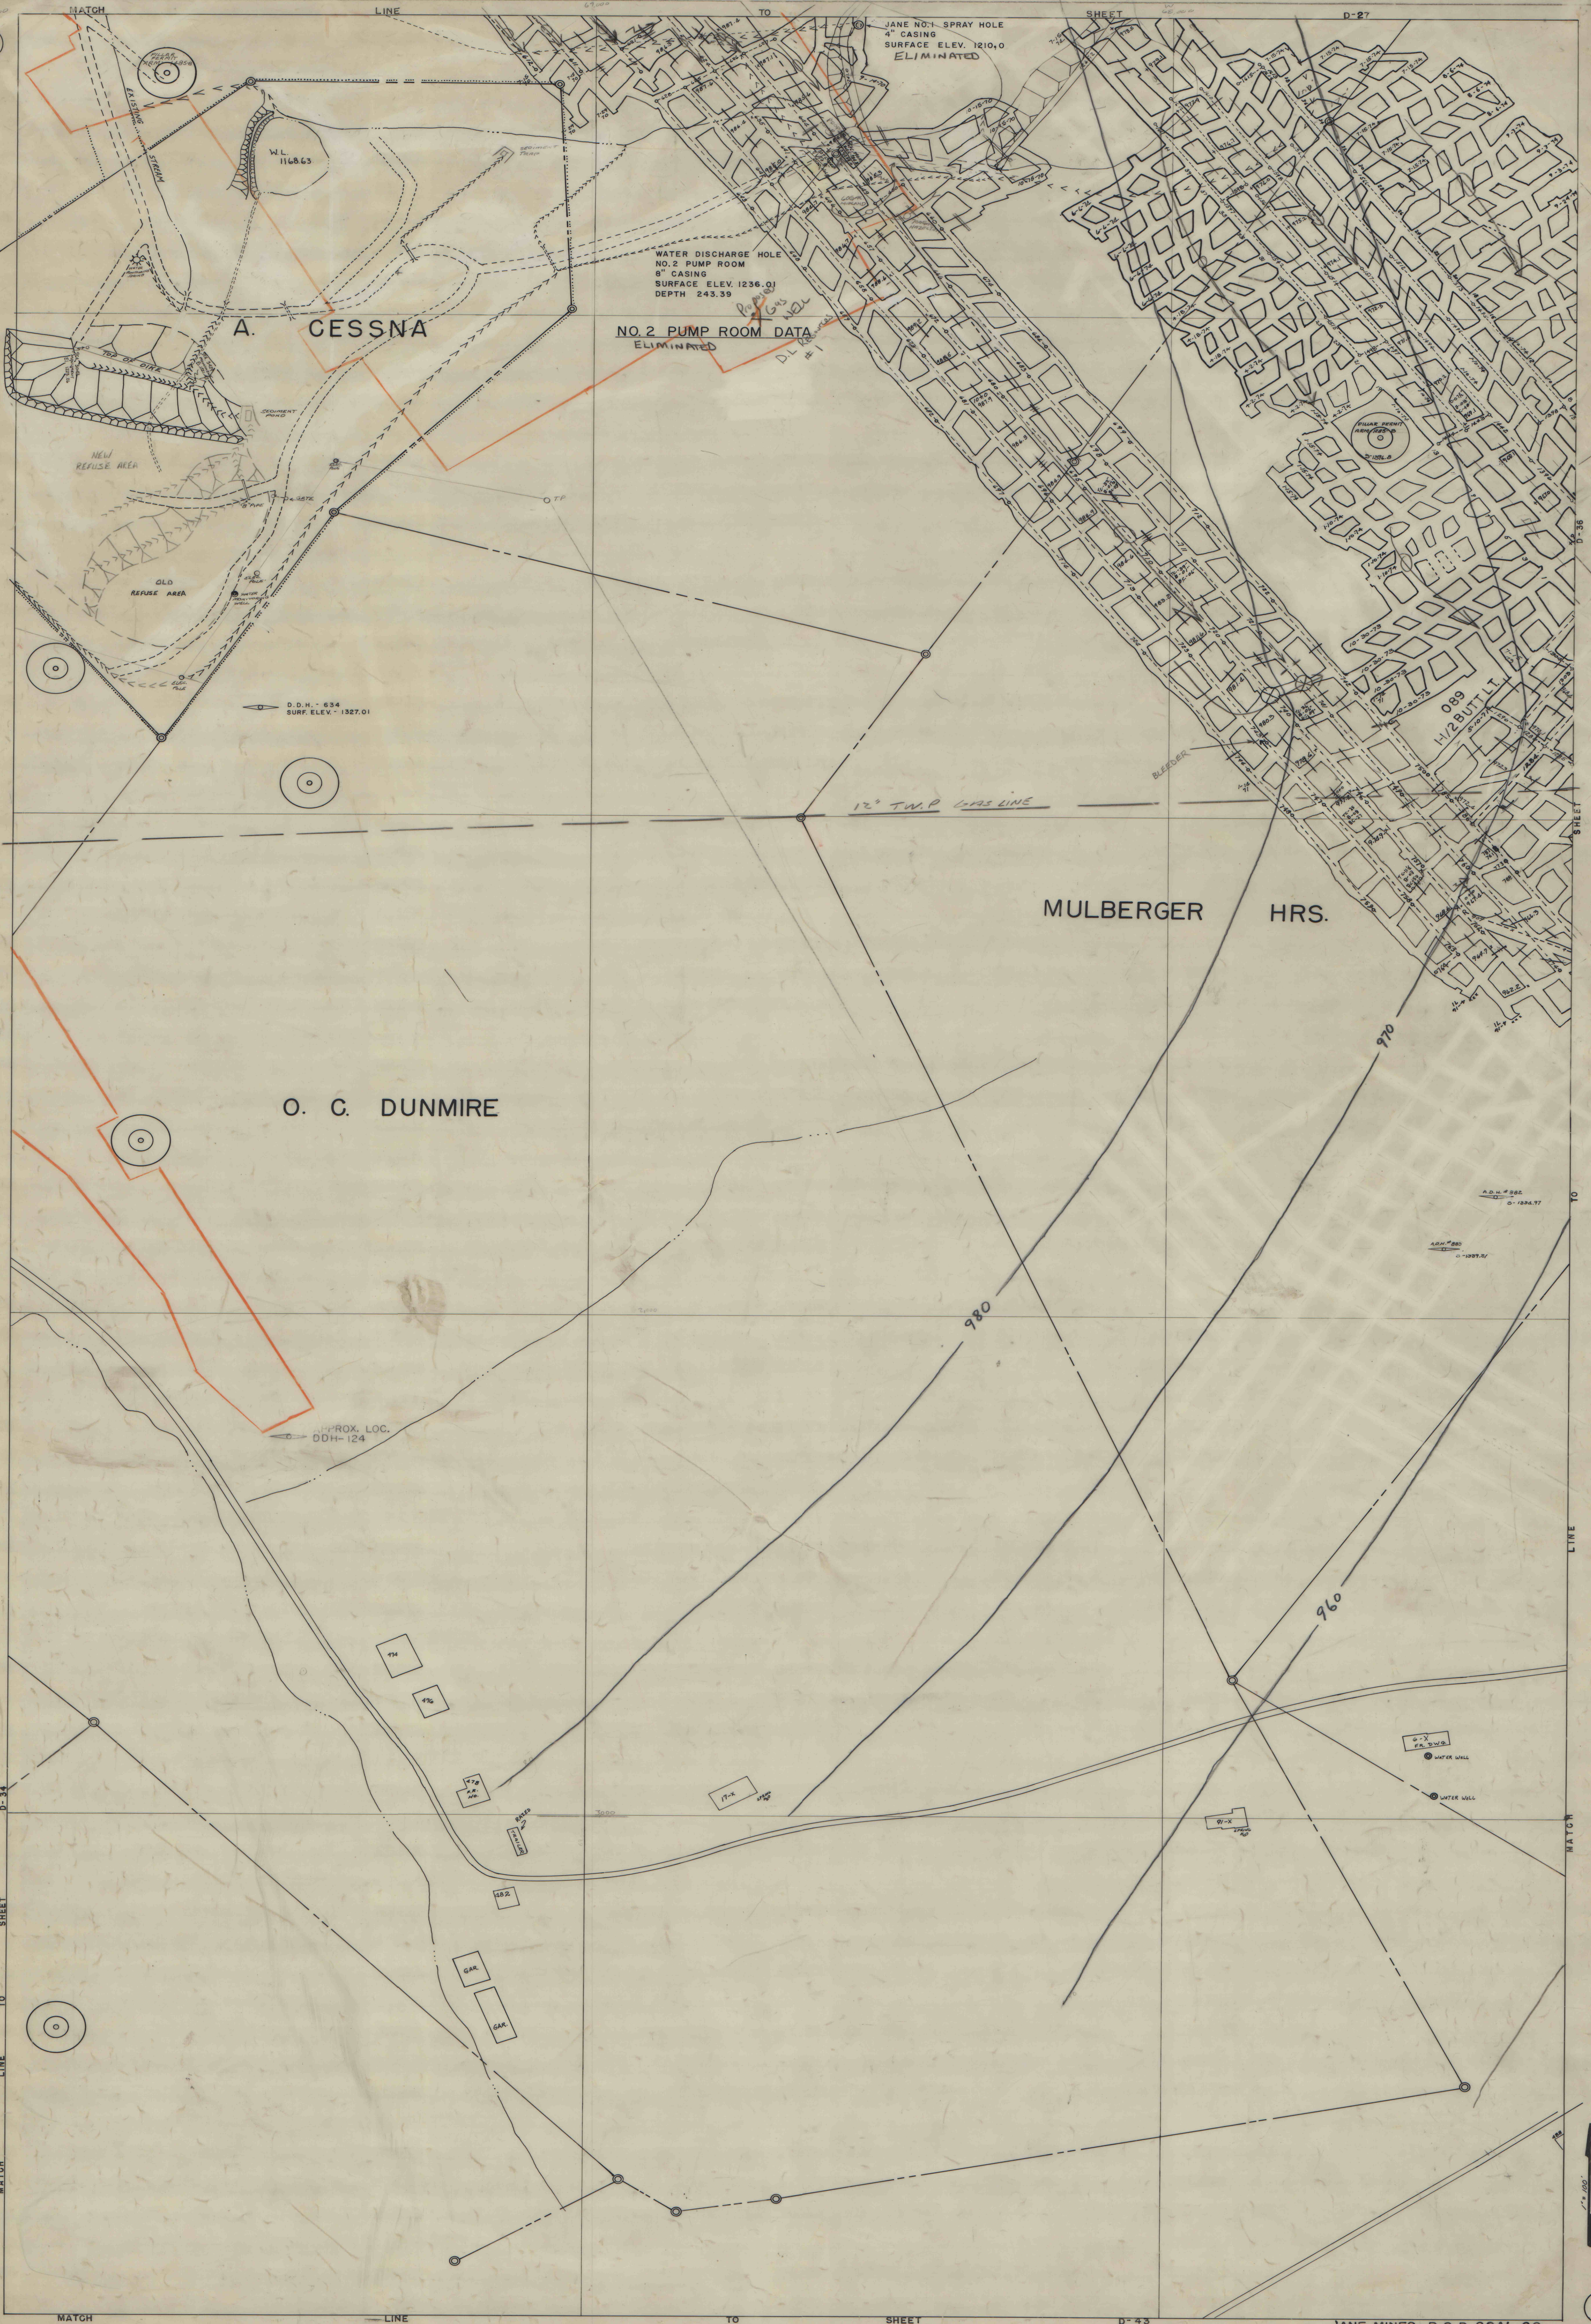

F-35

F-35