


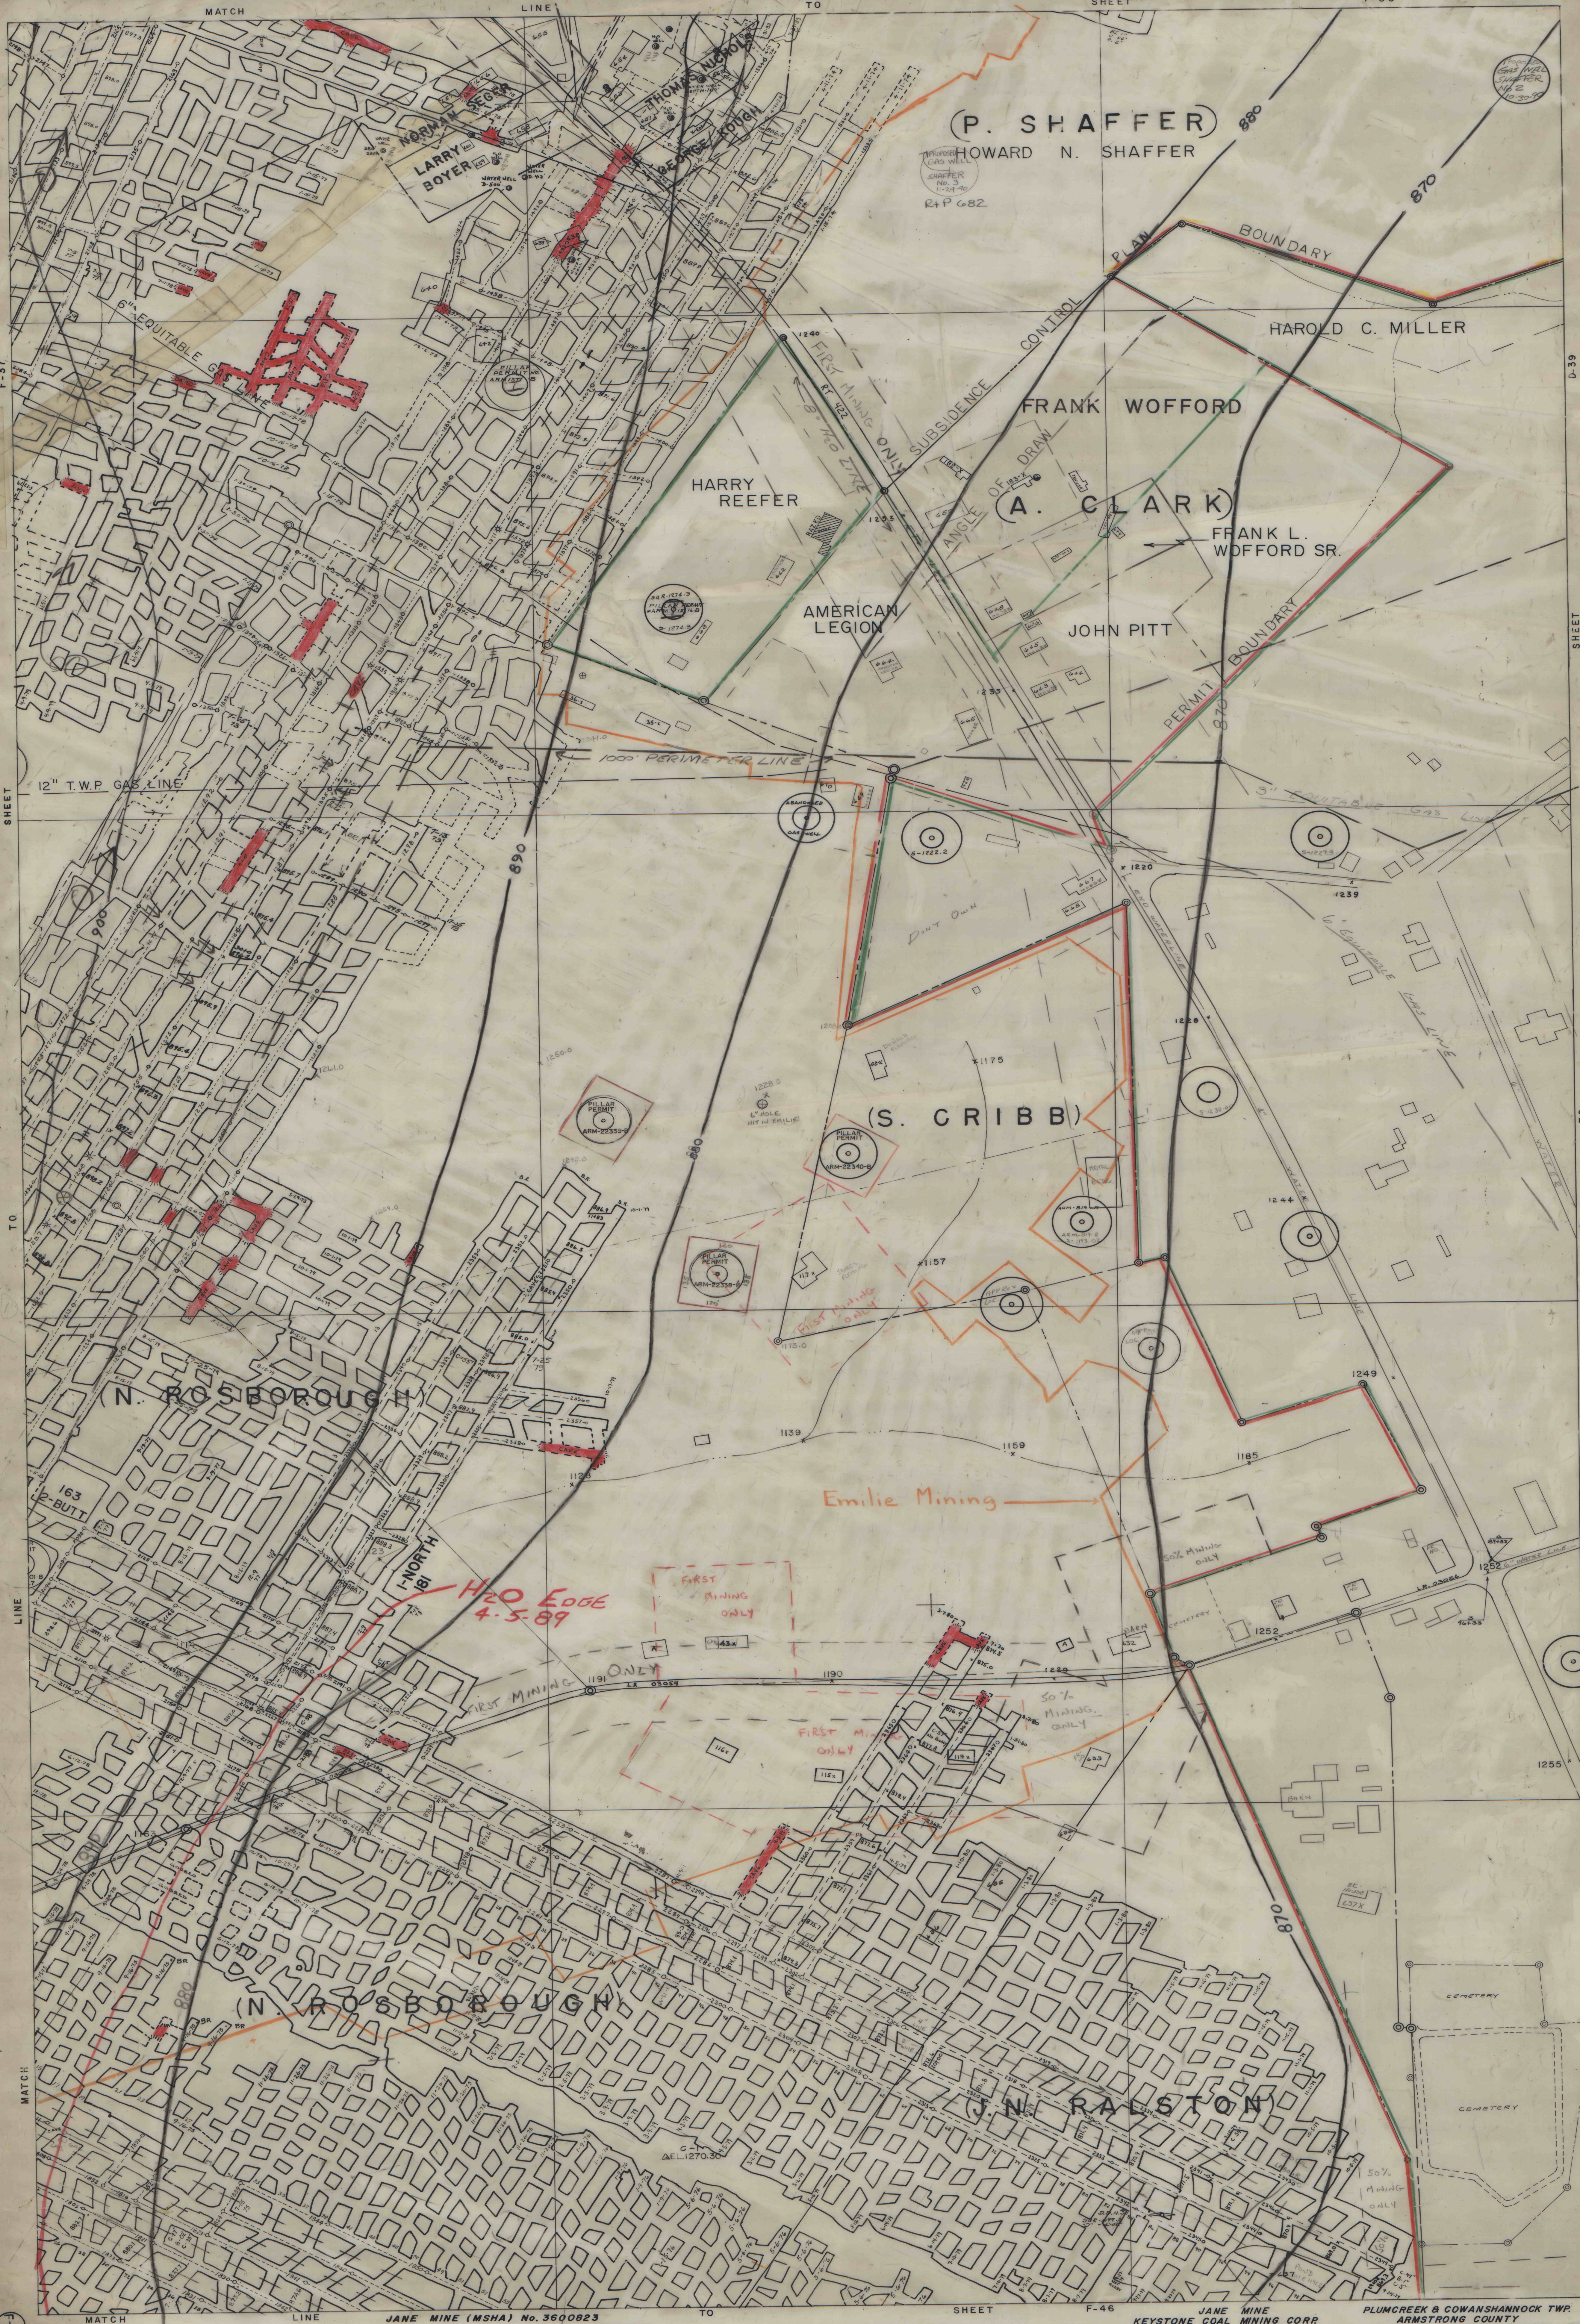

DRAWER 73

DRAWER 73

LOWER FREEPORT SEAM

$1'' = 100'$

80