

N 28,000

N 28,000

N 27,000

N 27,000

N 26,000

N 26,000

N 25,000

N 25,000

N 24,000

N 24,000

N 23,000

N 23,000

MATCH TO SHEET D-122

JANE NO. 1 MINE

PLUMCREEK TWP. - ARMSTRONG CO.


F-129

DRAWING 73

MATCH TO SHEET F-130

1"=100' SCALE

YATESBORO #9 VEIN "D"

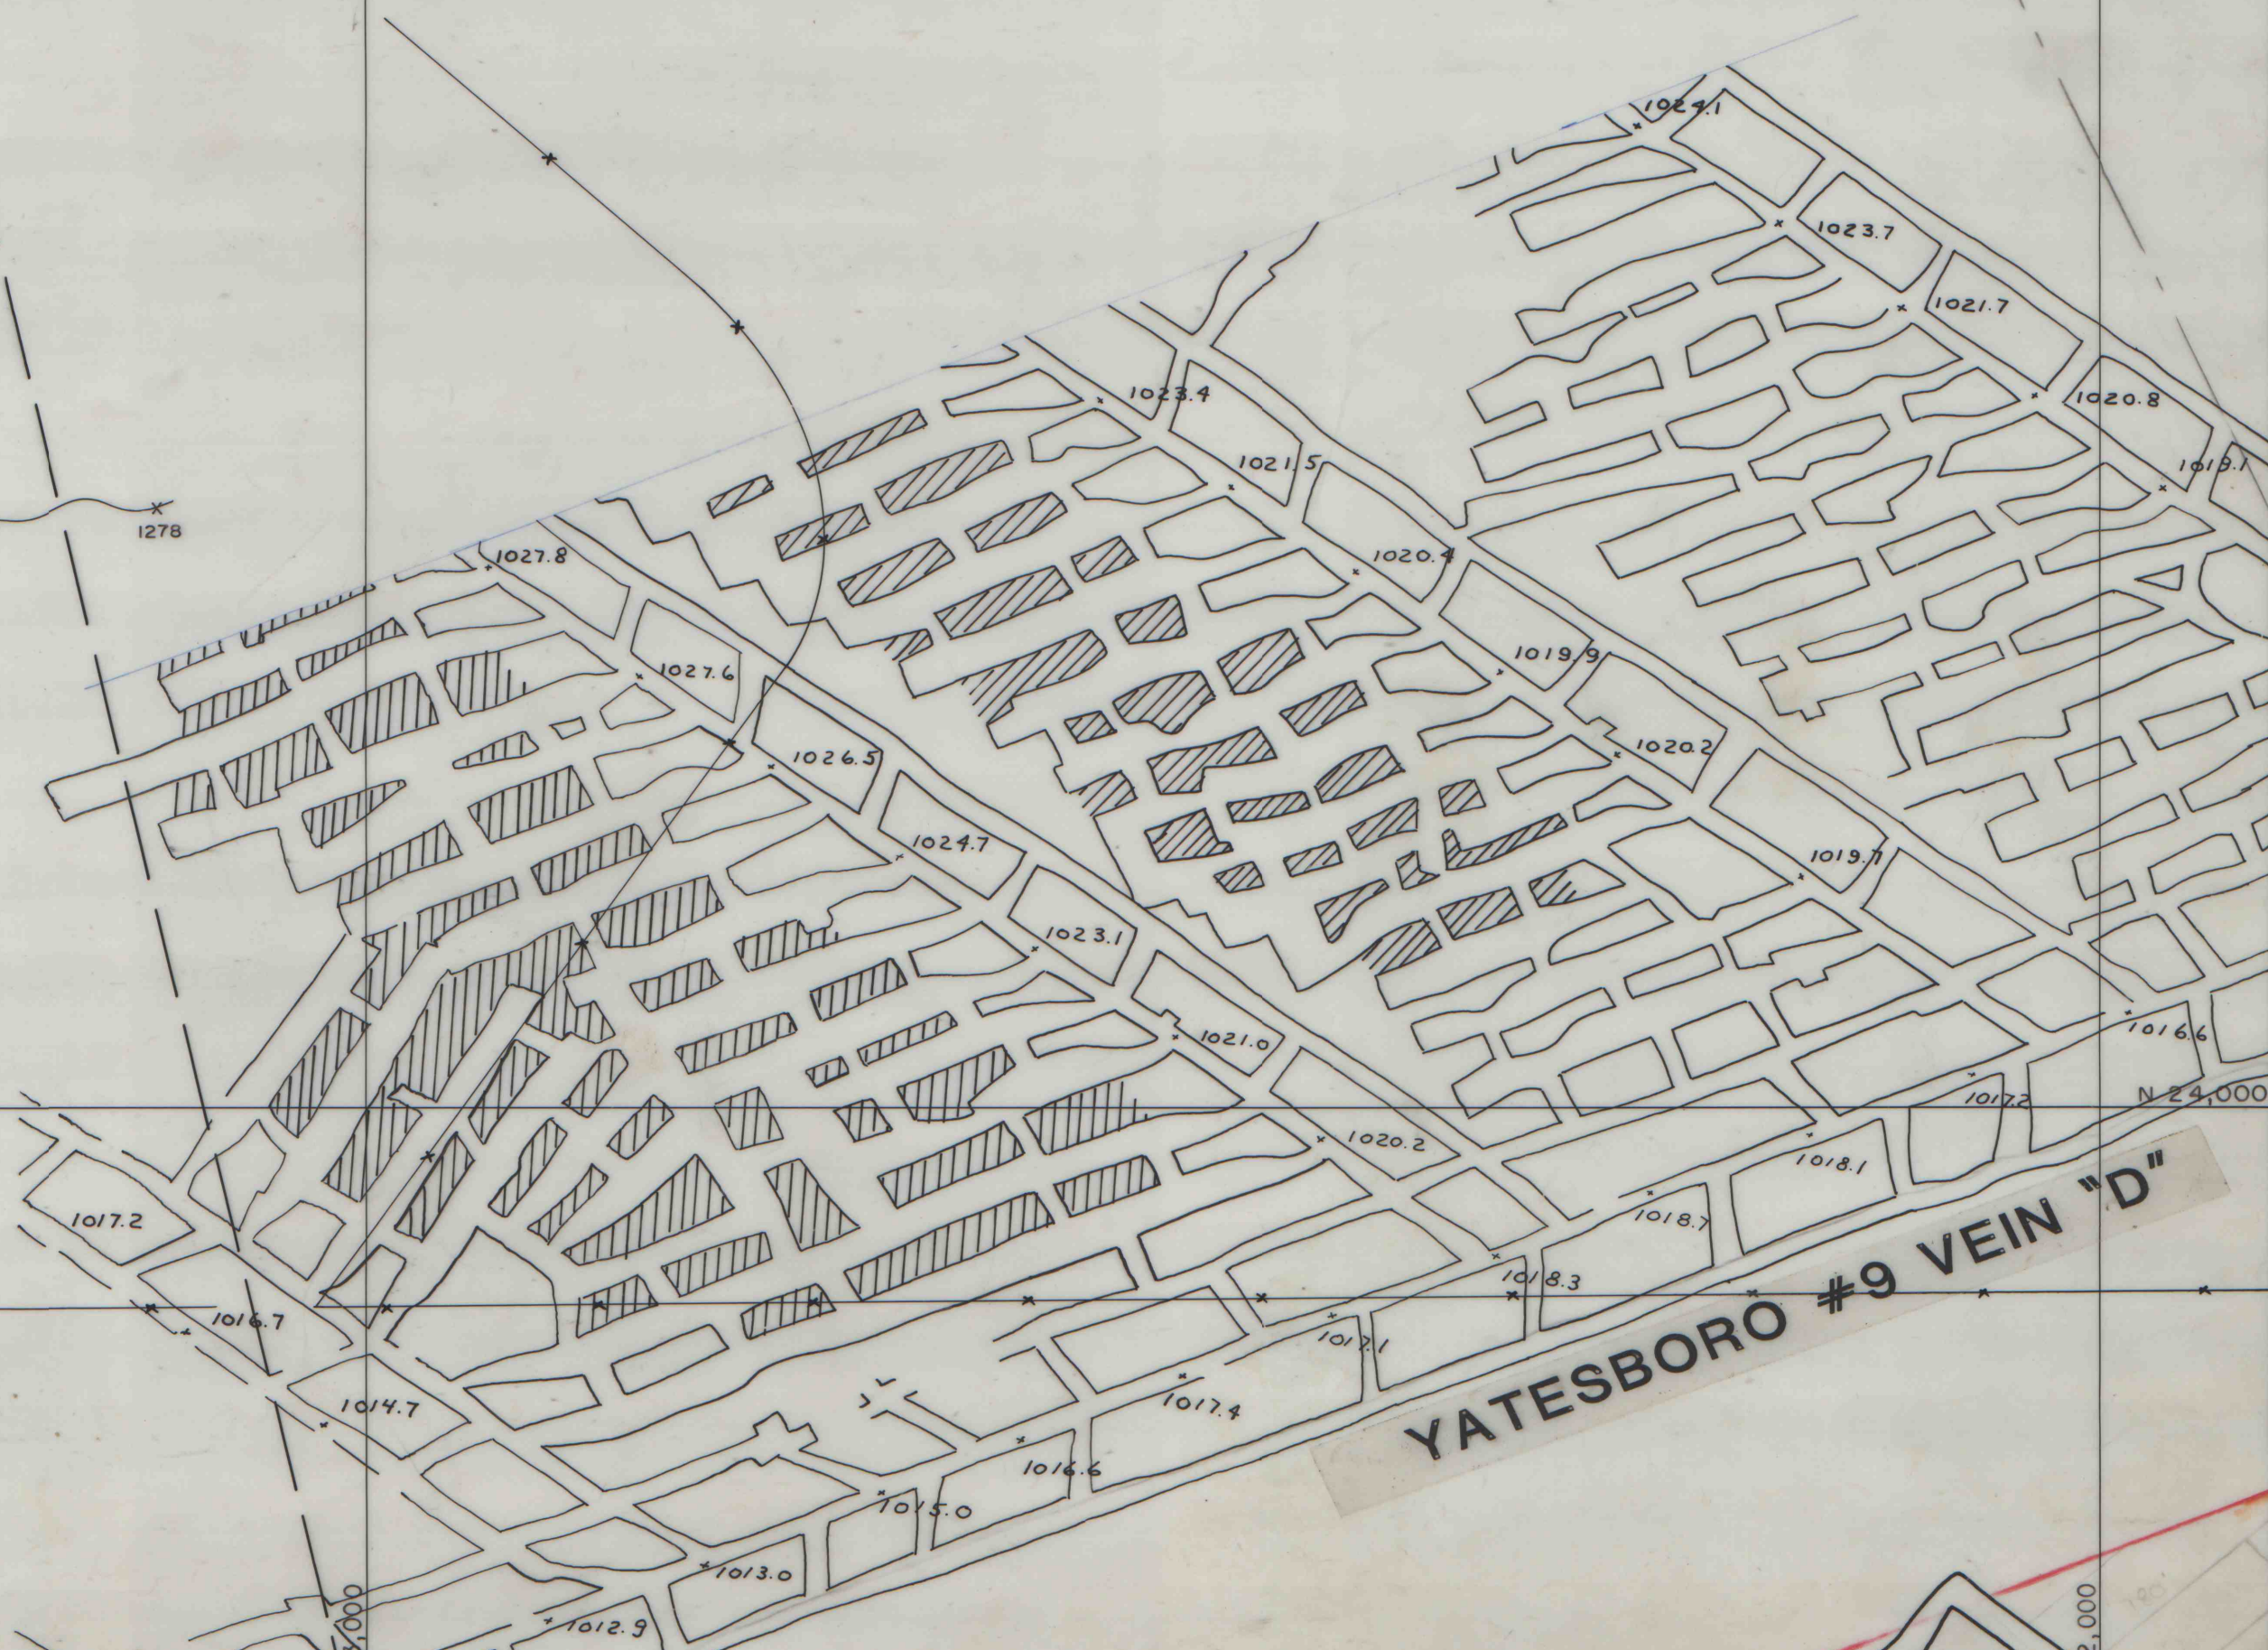

DRAWING 73

MATCH TO SHEET F-128