


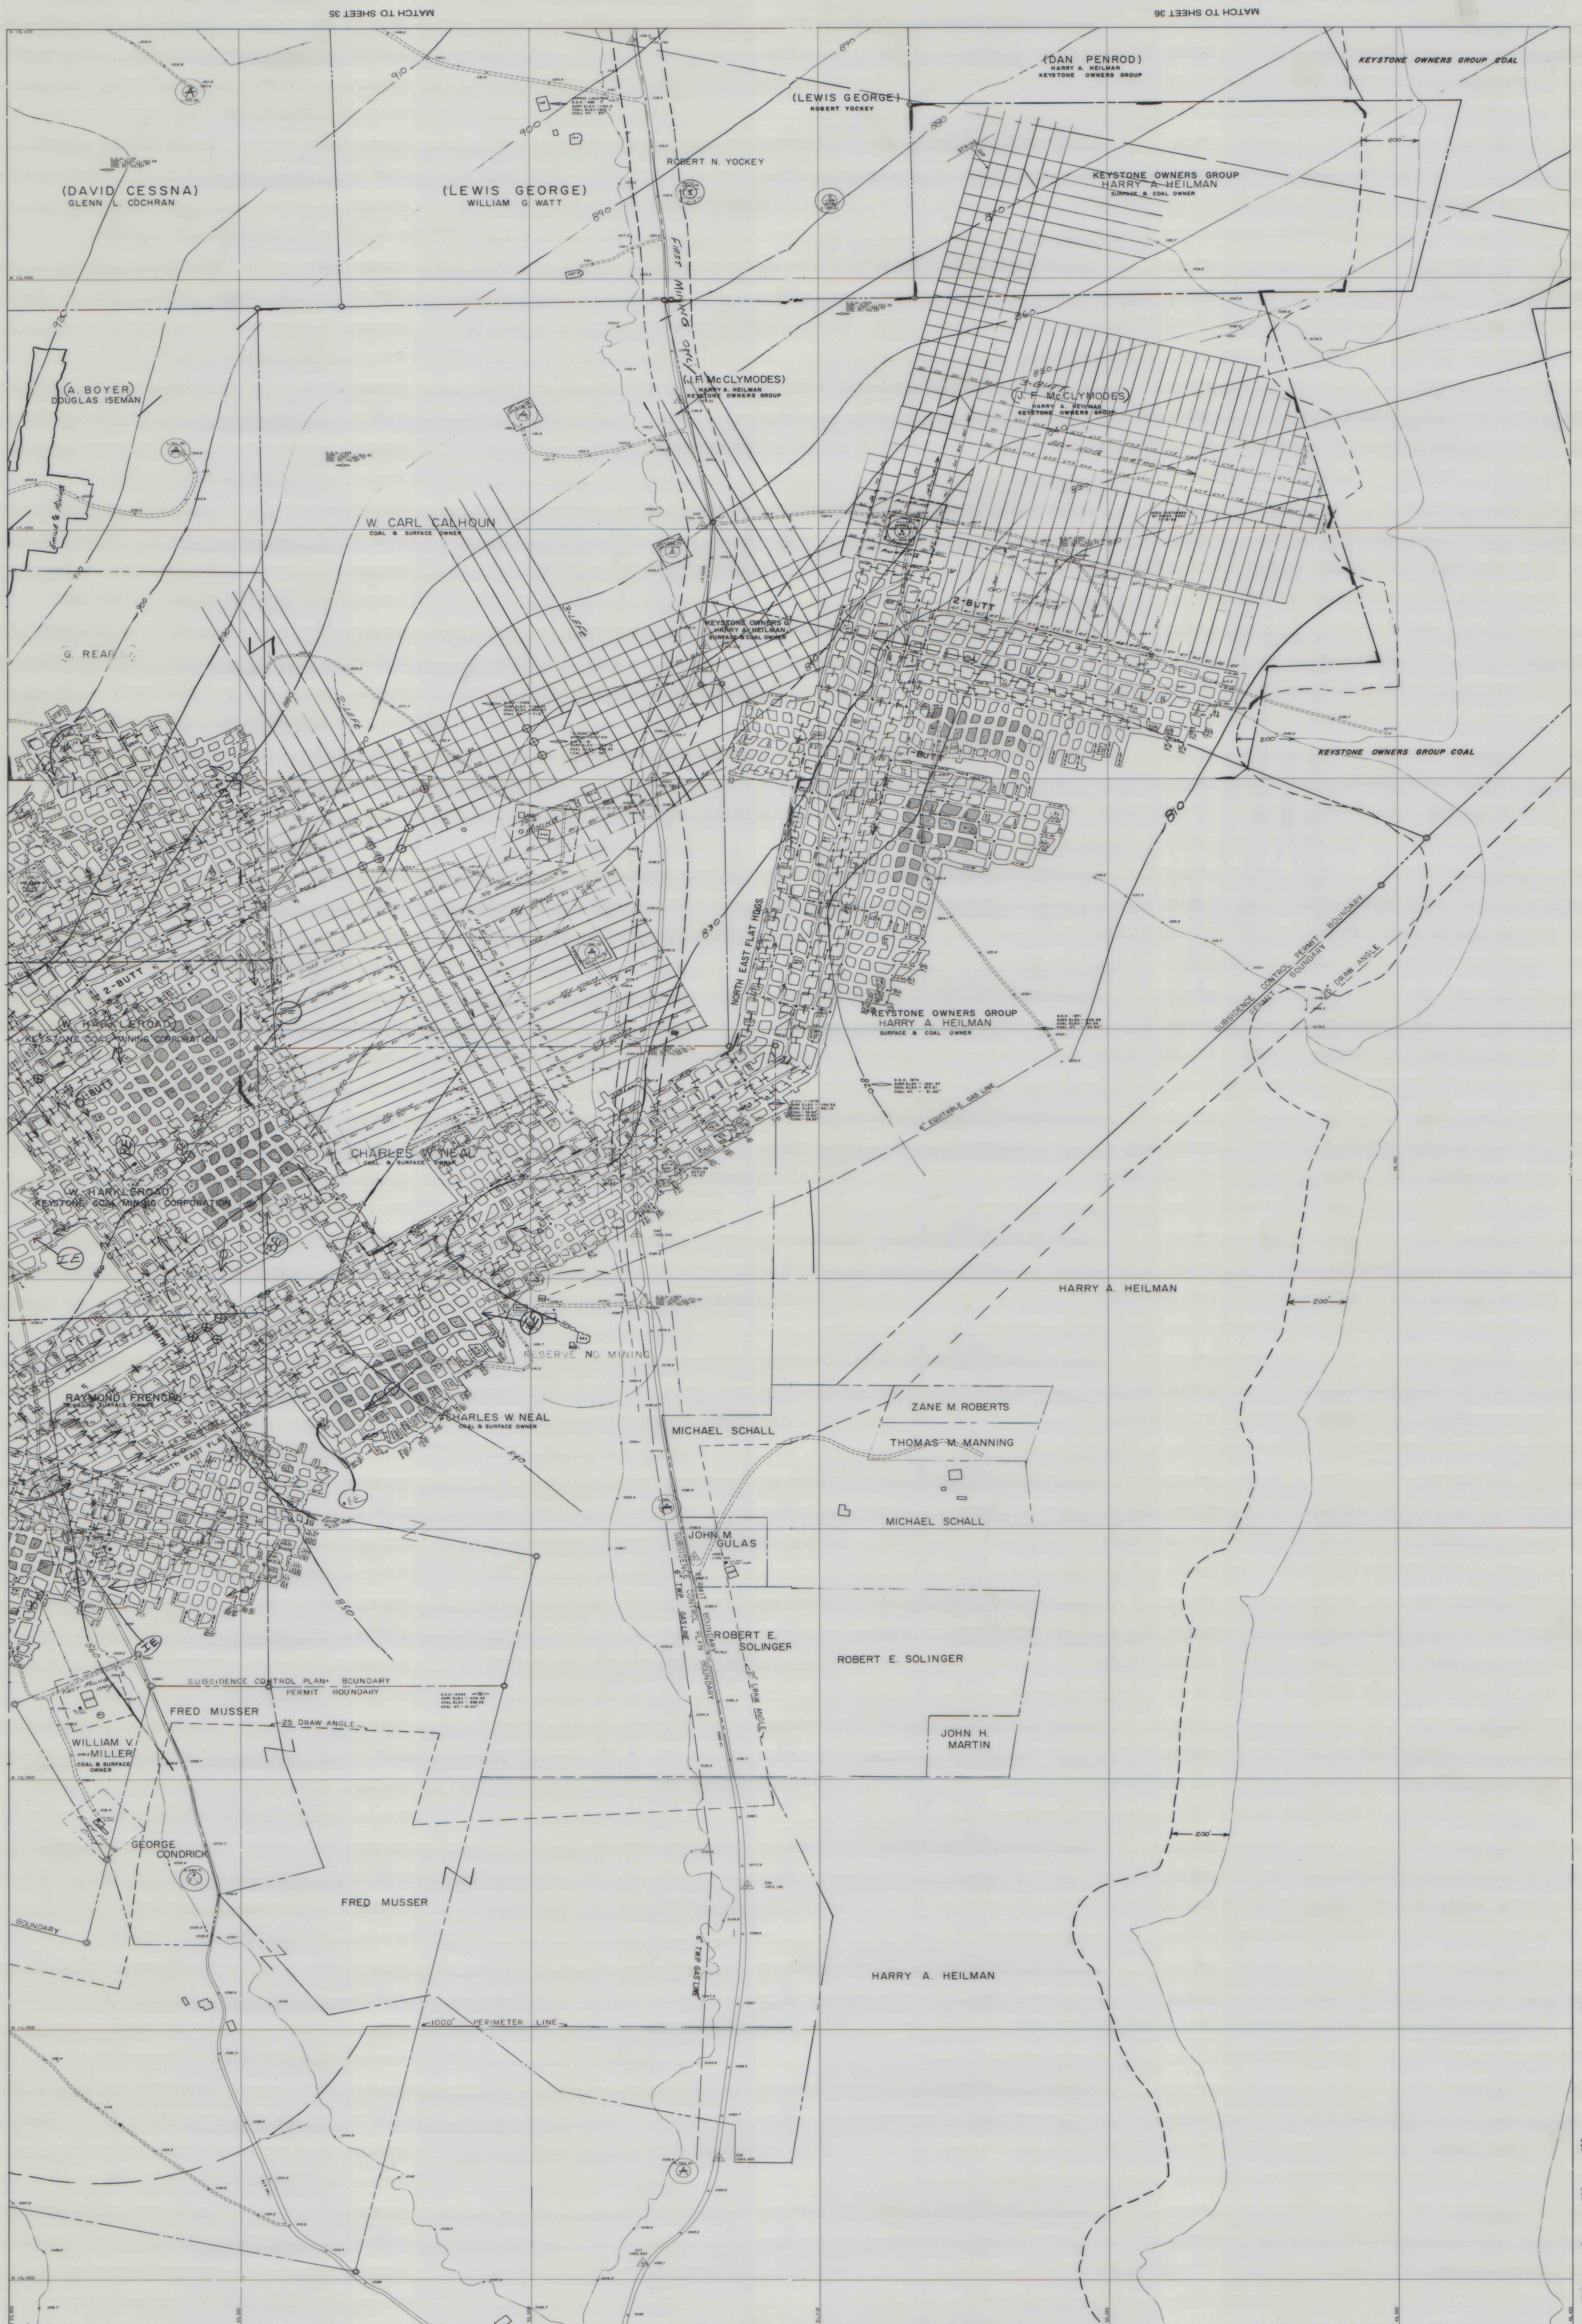

MATCH TO SHEET 51

