


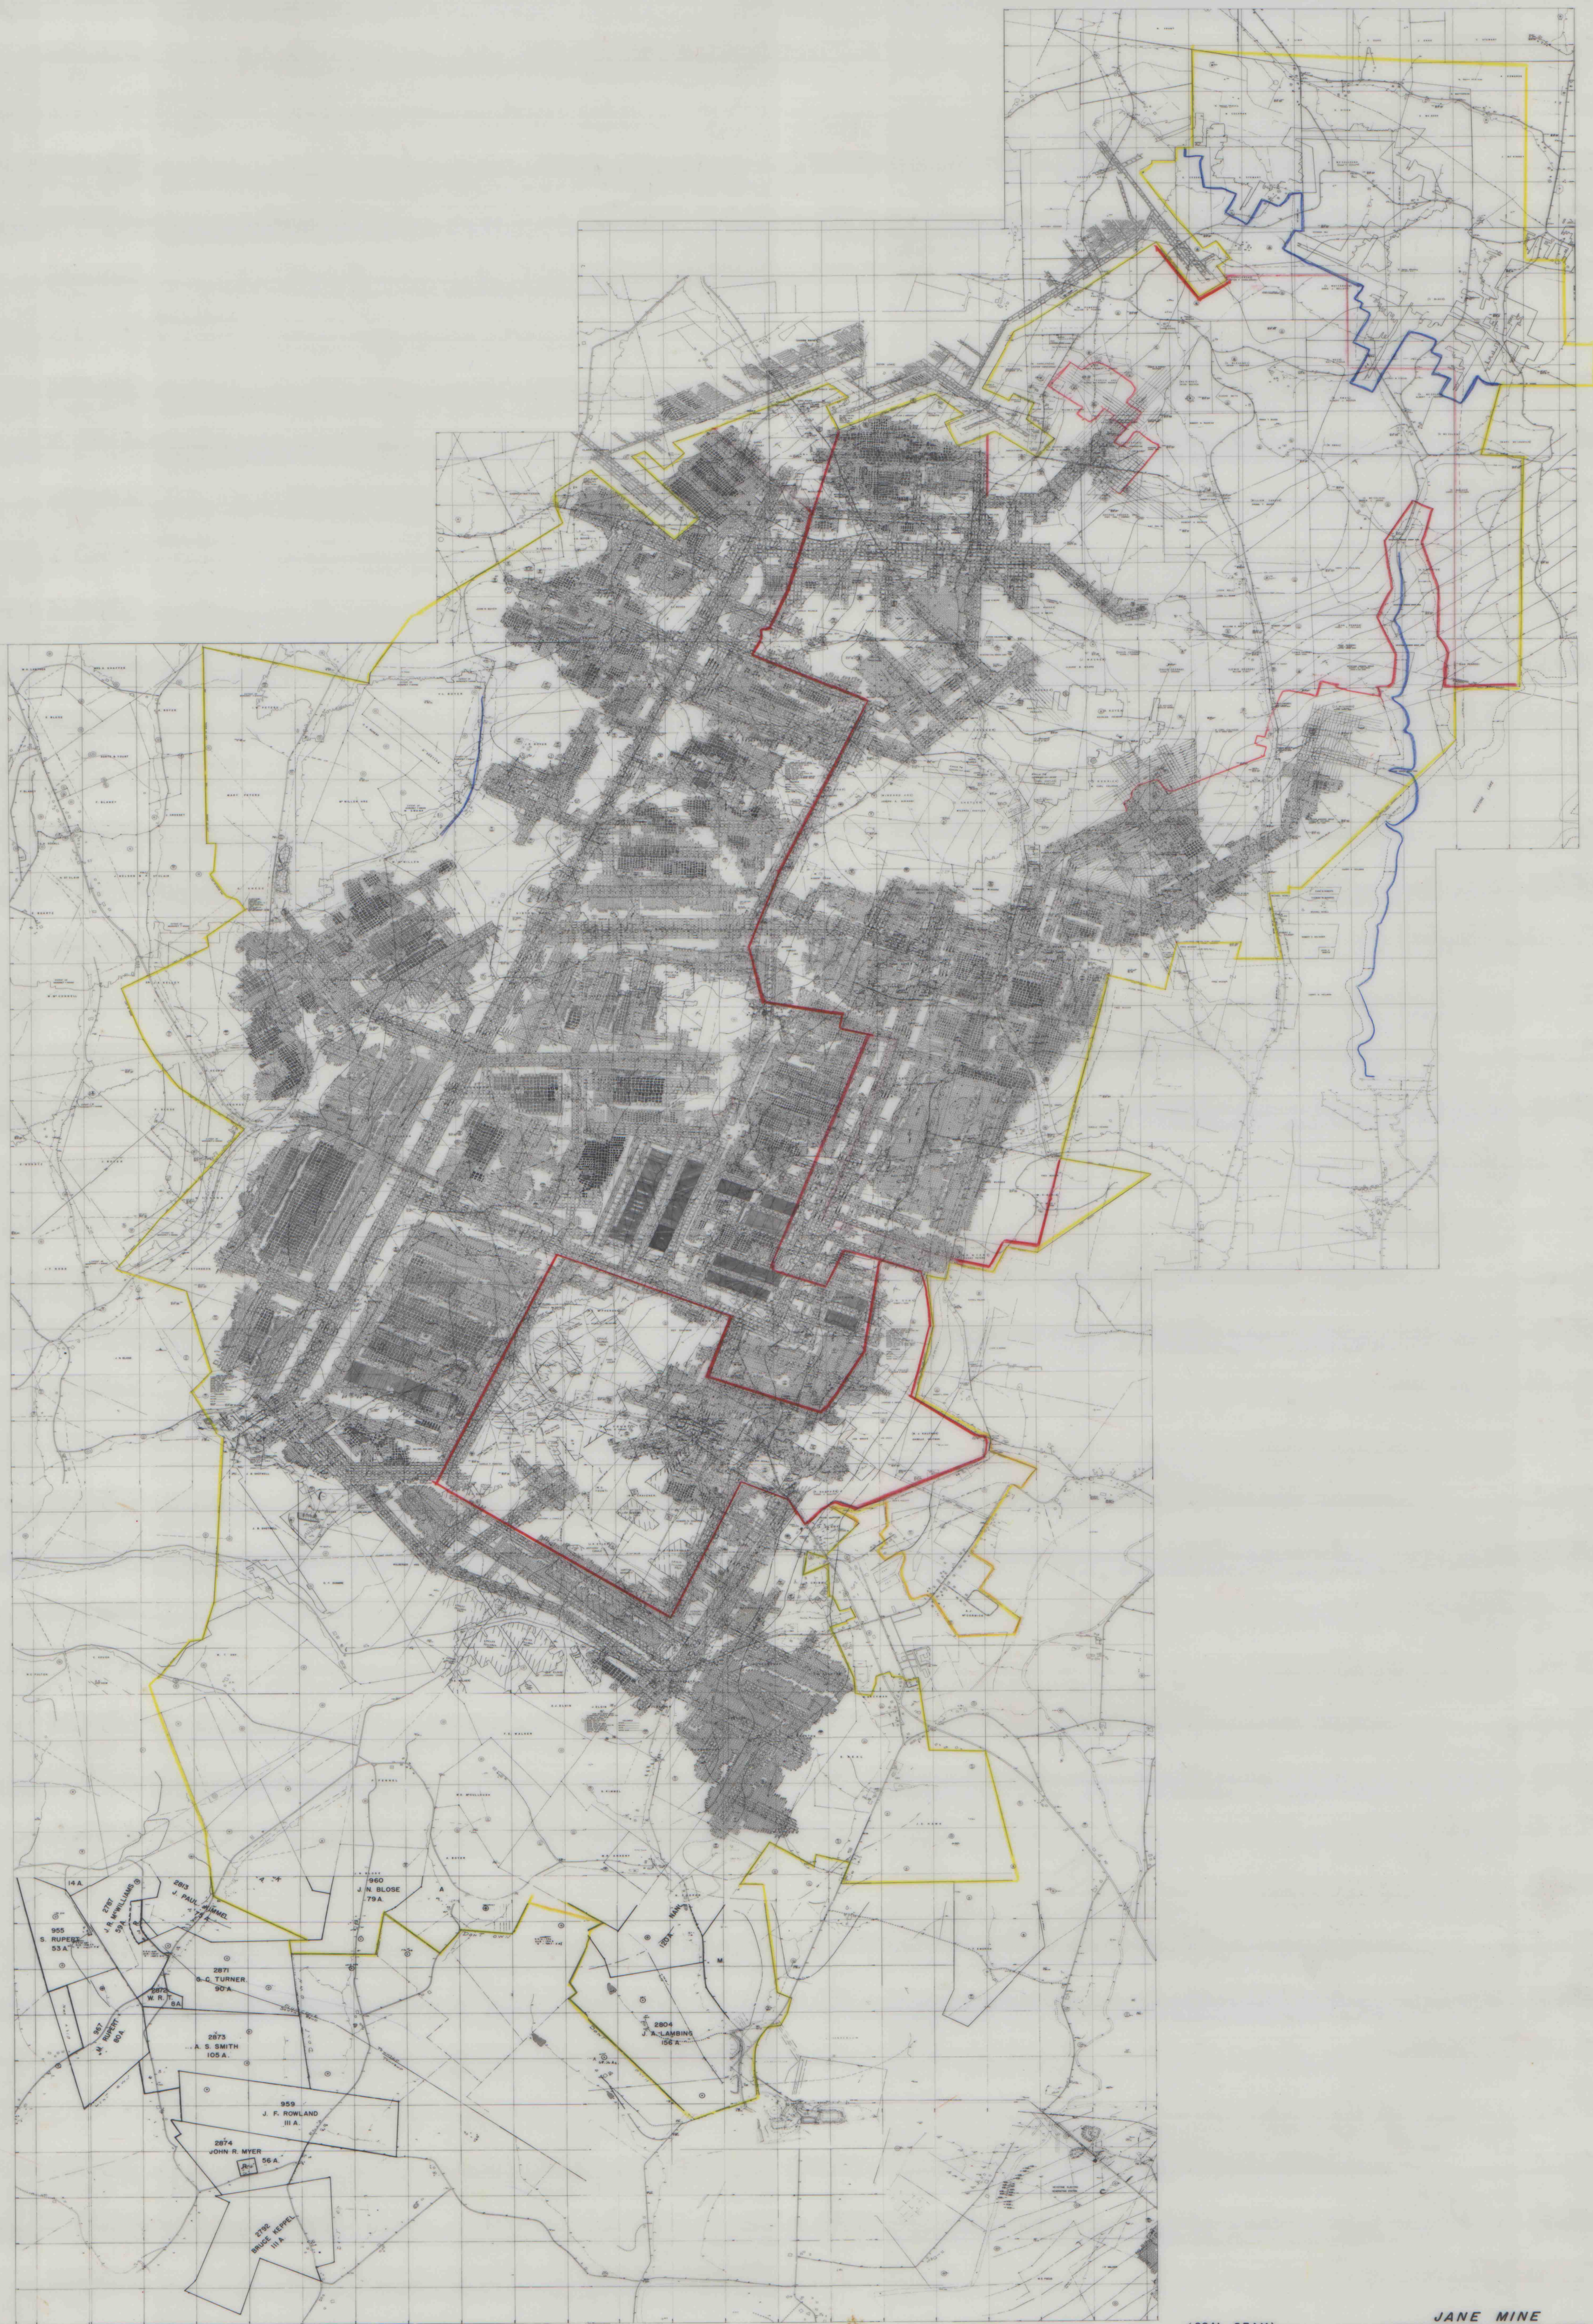

POSTING DATE 1-31-1989 SCALE: 1" = 2000'

(COAL SEAM)
LOWER FREEPOR
JANE MINE
KEYSTONE COAL MINING CORP.
PLUMCREEK & COWANSHANNOCK TWP. ARMSTRONG CO.