


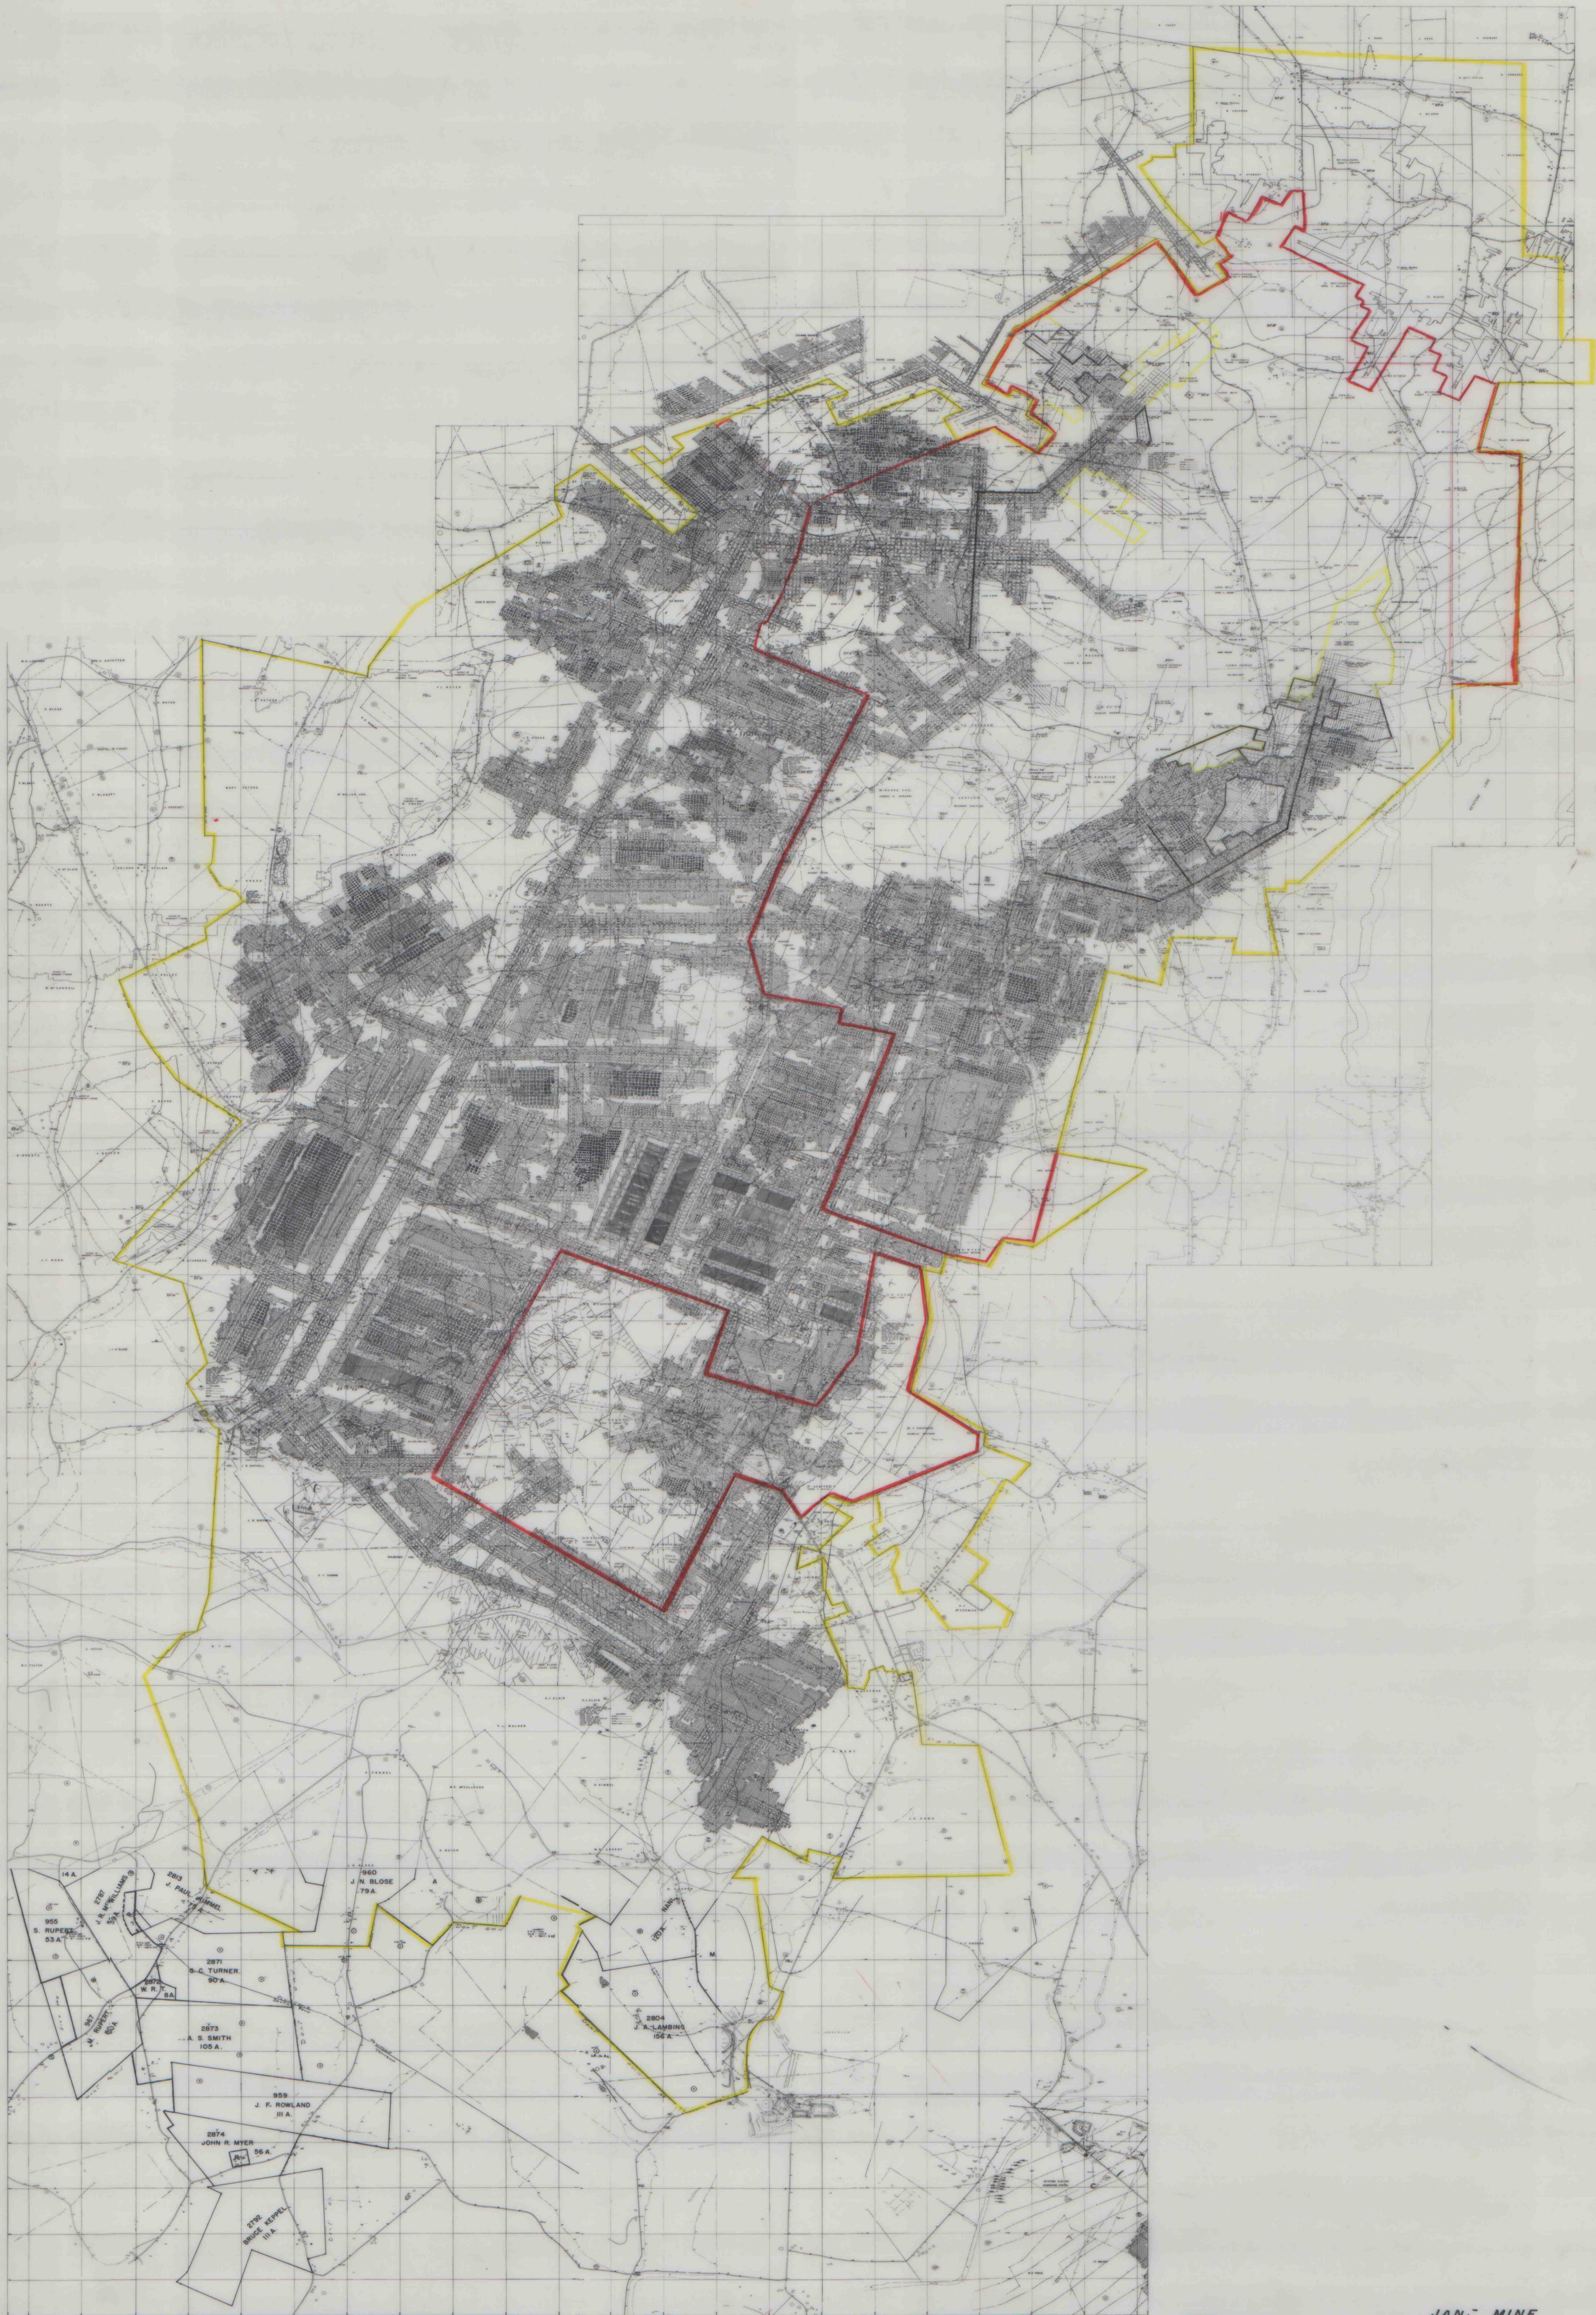

(COAL SEAM)
LOWER FREEPOR
JANZ MINE
KEYSTONE CO. L. MINING CORP.
PLUMCREEK & COWANSHANNOCK TWP. ARMSTRONG CO.