⑦ ⑦

MATCH TO SHEET 3

MATCH TO SHEET 6

MATCH TO SHEET 8

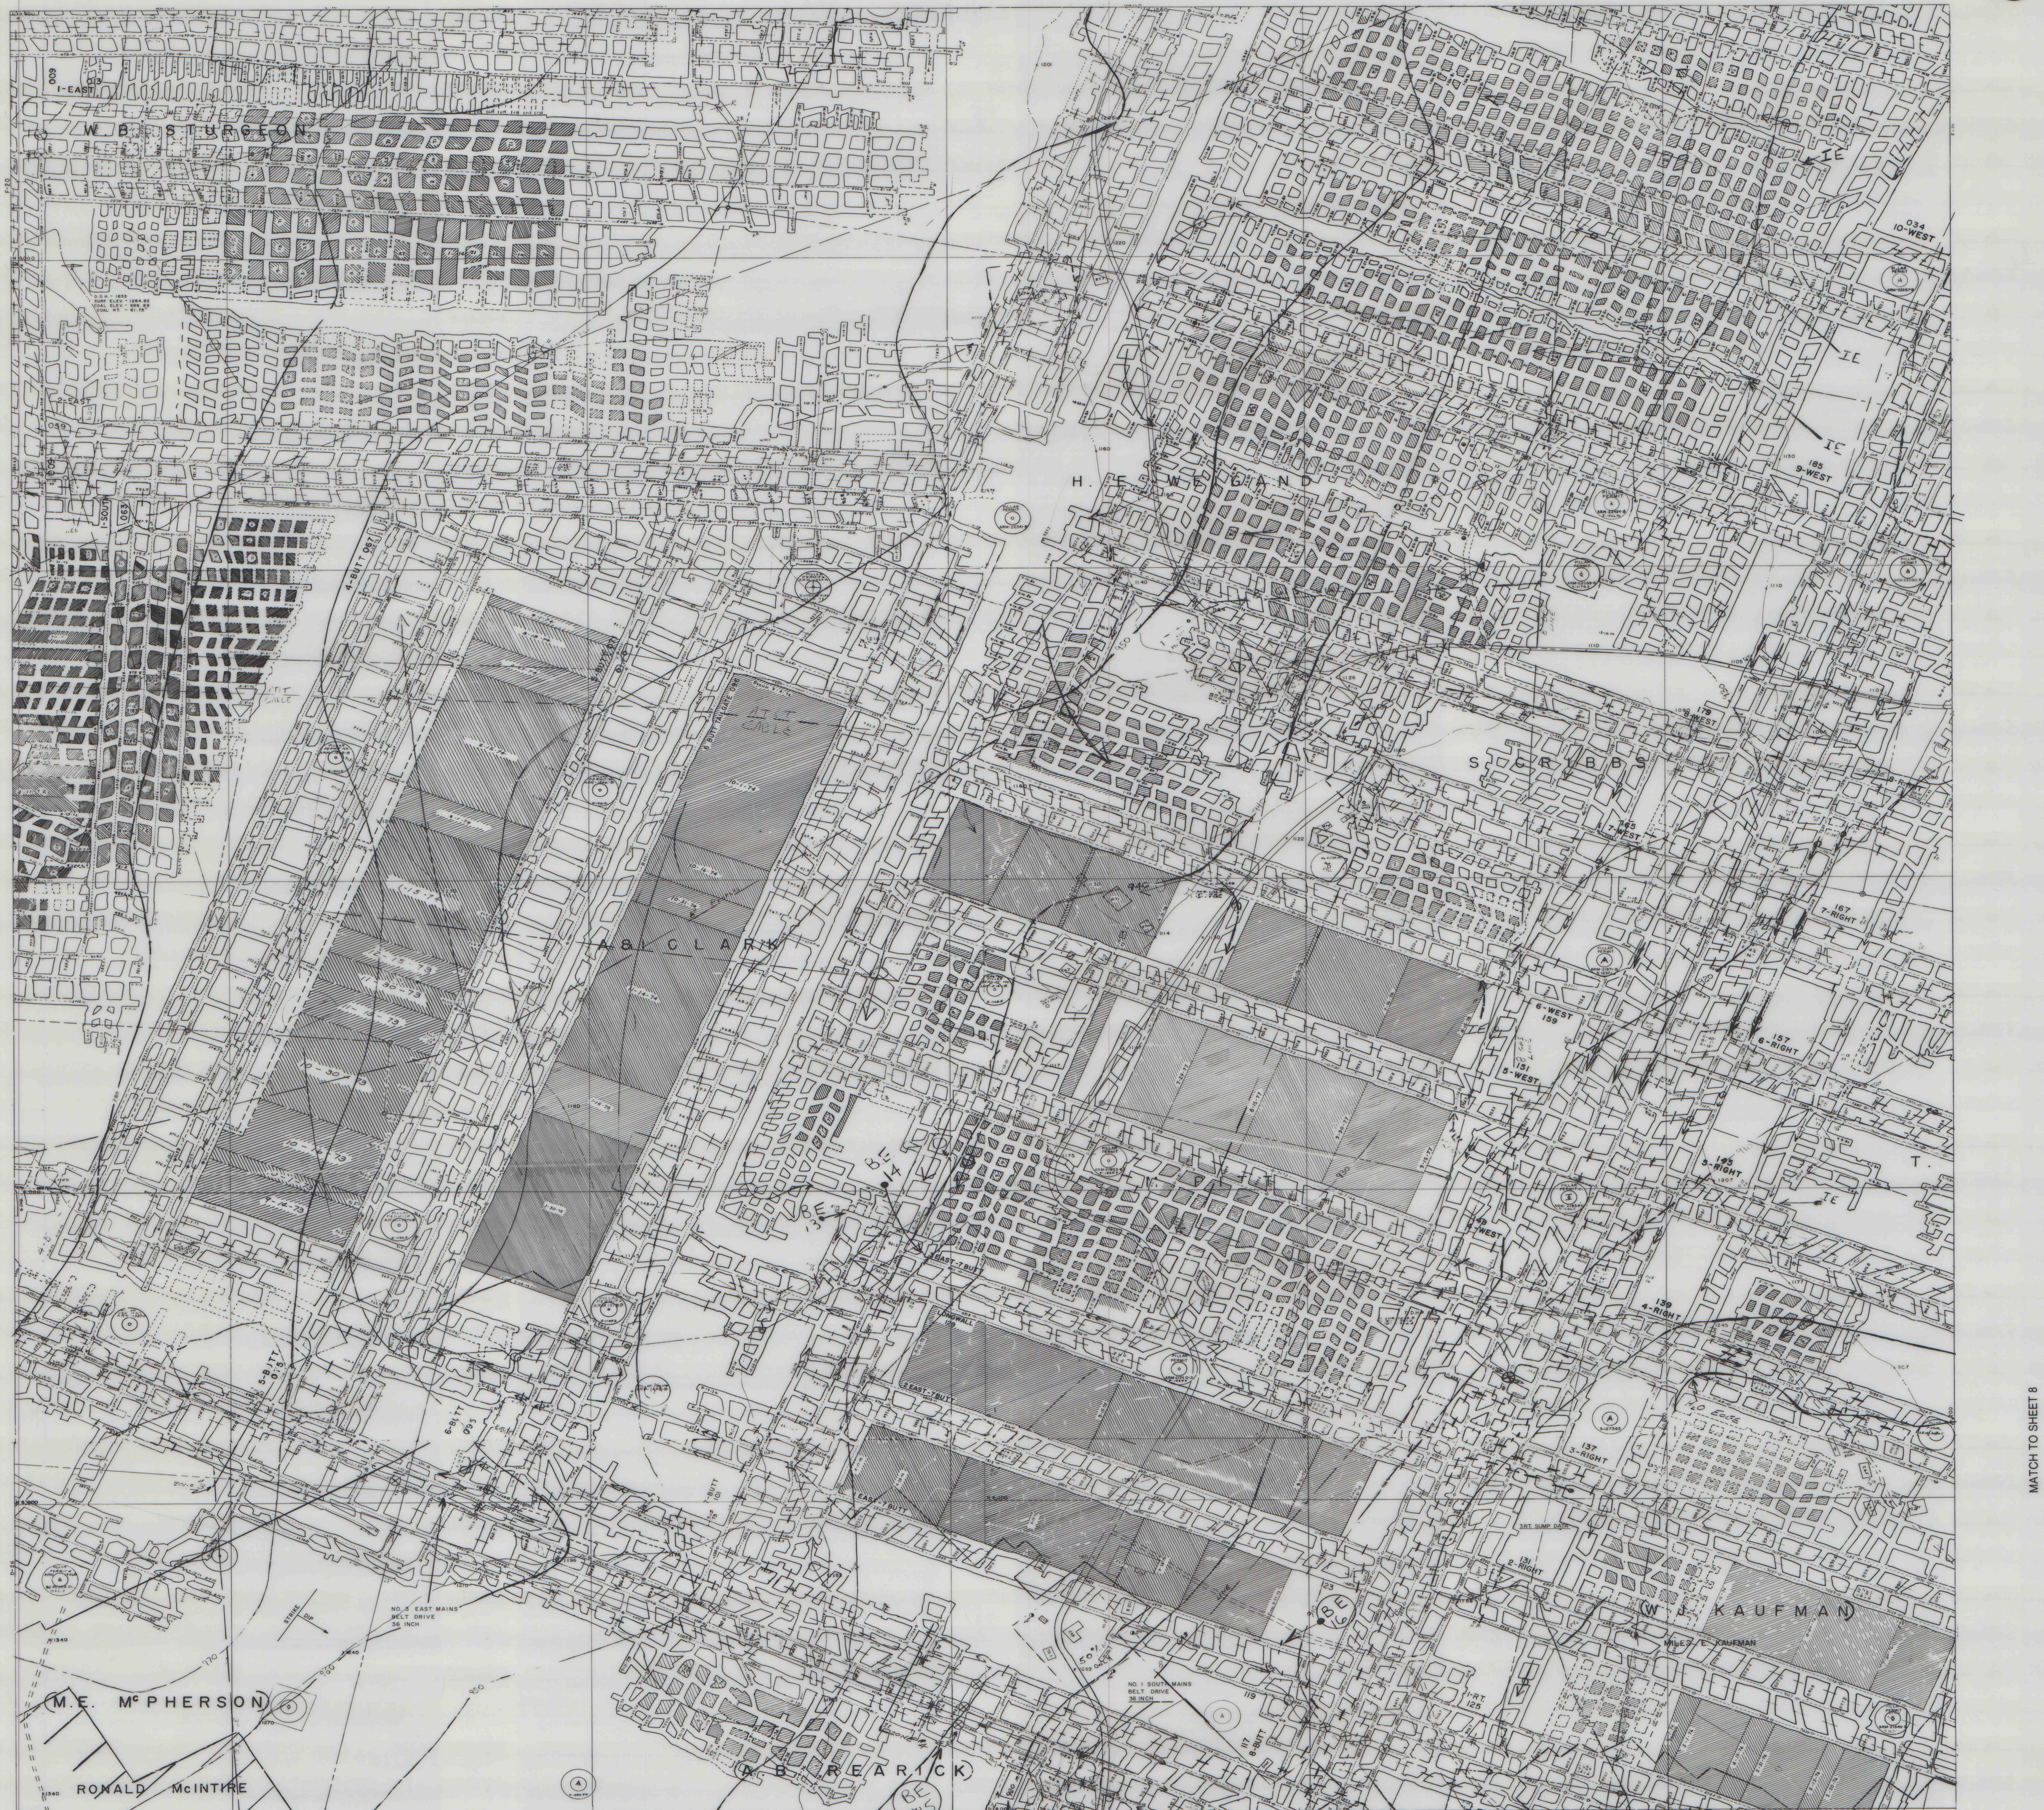
W. B. STURGEON
1-EAST
2-EAST
1-SOUTH
4-BUTT 067
5-BUTT
6 BUTT TAILGATE 096
A&I CLARK
H. F. WEIGAND
S. CRIBBS
034 10-WEST
185 9-WEST
179 8-WEST
165 7-WEST
167 7-RIGHT
159 6-WEST
157 6-RIGHT
151 5-WEST
145 5-RIGHT
139 4-RIGHT
137 3-RIGHT
131 2-RIGHT
1-RT 125
117 8-BUTT
187 SOUTH
LONGWALL 129
2 EAST-7 BUTT
EAST-7 BUTT
5-BUTT 015
6-BUTT 095
7-BUTT 101
PILLAR PERMIT
BE 13
BE 14
BE 15
BE 16
BE 17
BE
CE #20
IE
T.
NO. 3 EAST MAINS BELT DRIVE 36 INCH
NO. 1 SOUTH MAINS BELT DRIVE 36 INCH
NO. 2 SOUTH MAINS BELT DRIVE 36 INCH
3RT SUMP DATA
STRIKE
DIP
M.E. McPHERSON
RONALD McINTIRE
ROY KAUFMAN
A. B. REARICK
W. J. KAUFMAN
MILES E. KAUFMAN
ARTHUR C. HULSE
KEYSTONE COAL MINING CORP.
EMILIE PILLARED AREA
PAUL F. YOUNT
A. YOUNT
HARRY MEYERS
-2- LEFT
HELEN MAE DODSON
1-BUTT
-2- BUTT
3-BUTT
HARRY BEITCH
H. W. PRU
LAWRENCE E. OMASTA
LARRY REARIC
M. HECKMAN
ALEX CRIBBS
FRANK BAKER
ROGER HOOKS
RANDY GRAHAM
ROBERT H. SCHALL
JON GROVE
A. ELGIN
ROY SCHALL
CLARK THOMAS
DONALD CROWNOVER
KEN SCHALL
SHAFFER
HOWARD N. SHAFFER
FIRST MINING ONLY
50% MINING ONLY
W.C. YOUNT
6" EQUITABLE GAS LINE
8" PEOPLES GAS LINE
BERNARD BOYER
DENNIS SCHRENCENGOST
ROBERT BOYER
JOSEPH BERTILINO
WILLIAM WOOD
HARRY BOYER
ROBERT SHILLING
BLAIR PETERMAN
O.J. WINGARD
3-LEFT
4-LEFT
5-LEFT
GLENNA SHUGHART
W. A. CRAVENER
WILLIAM B. WOOD
WILLIAM C. WOOD
APPROX. LOCATION D.D.H. - 633 SURF. ELEV. - 1379.75 COAL ELEV. - 937.65 COAL HT. - 59.25"
D.D.H. - 1853 SURF. ELEV. - 1284.82 COAL ELEV. - 988.89 COAL HT. - 61.75"
N
1"=200' scale
200 0 200 400 feet
POSTING DATE 7-31-1989

JANE MINE (MSHA) No. 3600823
JANE MINE PERMIT (DER) No. 03831305

MATCH TO SHEET 11

(COAL SEAM)
LOWER FREEPORT

JANE MINE
KEYSTONE COAL MINING CORP.
PLUMCREEK & COWANSHANNOCK TWP. ARMSTRONG CO.

⑦ ⑦