


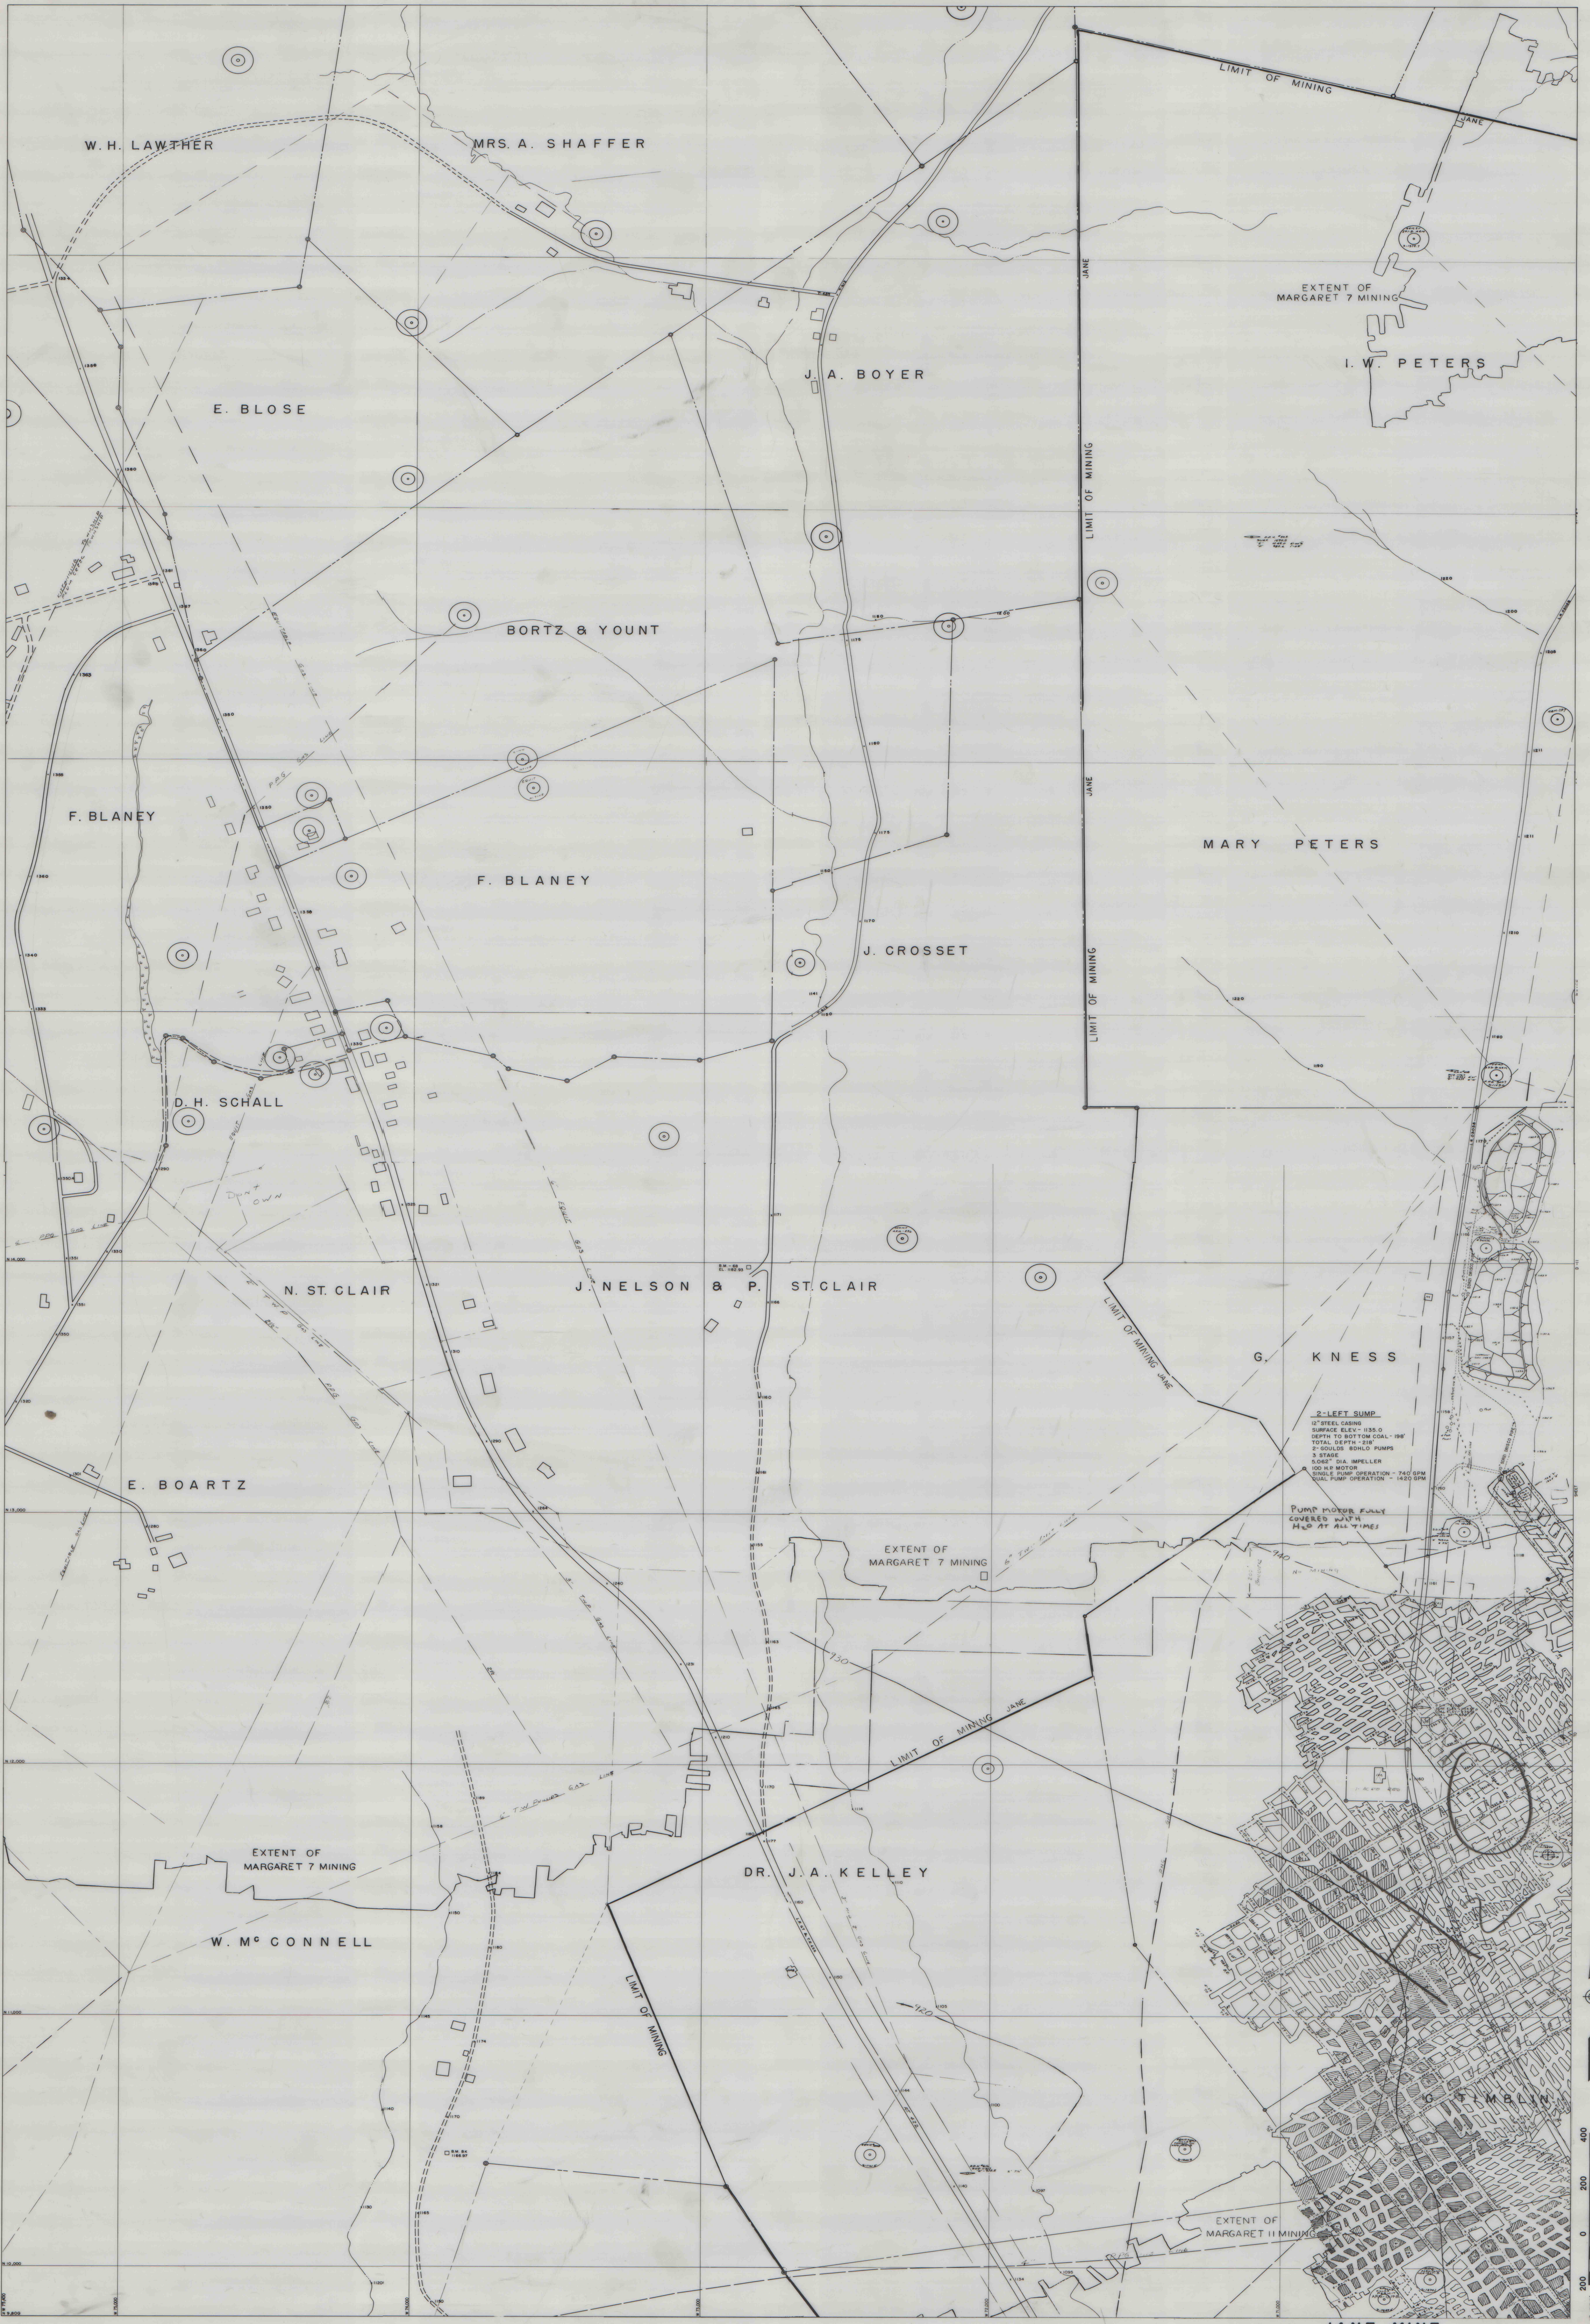

JANE MINE (MSHA) No. 3600823
JANE MINE PERMIT (DER) No. 03831305
MATCH TO SHEET 5

(COAL SEAM)
LOWER FREEPORT PLUMCREEK & COWANSHANNOCK TWP. ARMSTRONG CO.
JANE MINE
KEYSTONE COAL MINING CORP.

MATCH TO SHEET 2

POSTING DATE 7-31-1989