


MATCH TO SHEET 1

MATCH TO SHEET 15

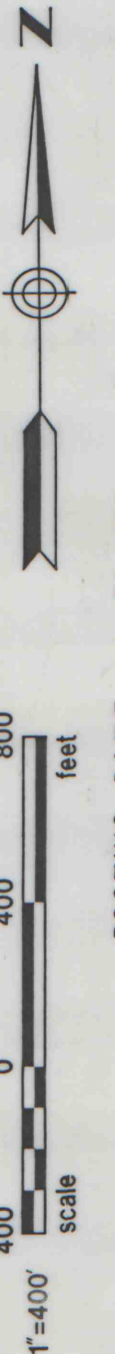

POSTING DATE 1-31-1930

2

2

JANE MINE (MSHA) No. 3600823 (COAL SEAM)
JANE MINE PERMIT (DER) No. 03631305 LOWER FREEPORT
MATCH TO SHEET 4 PLUMCREEK & COVAHSHANNOCK TWP. ARMSTRONG CO.

JANE MINE
KEYSTONE COAL MINING CORP.