


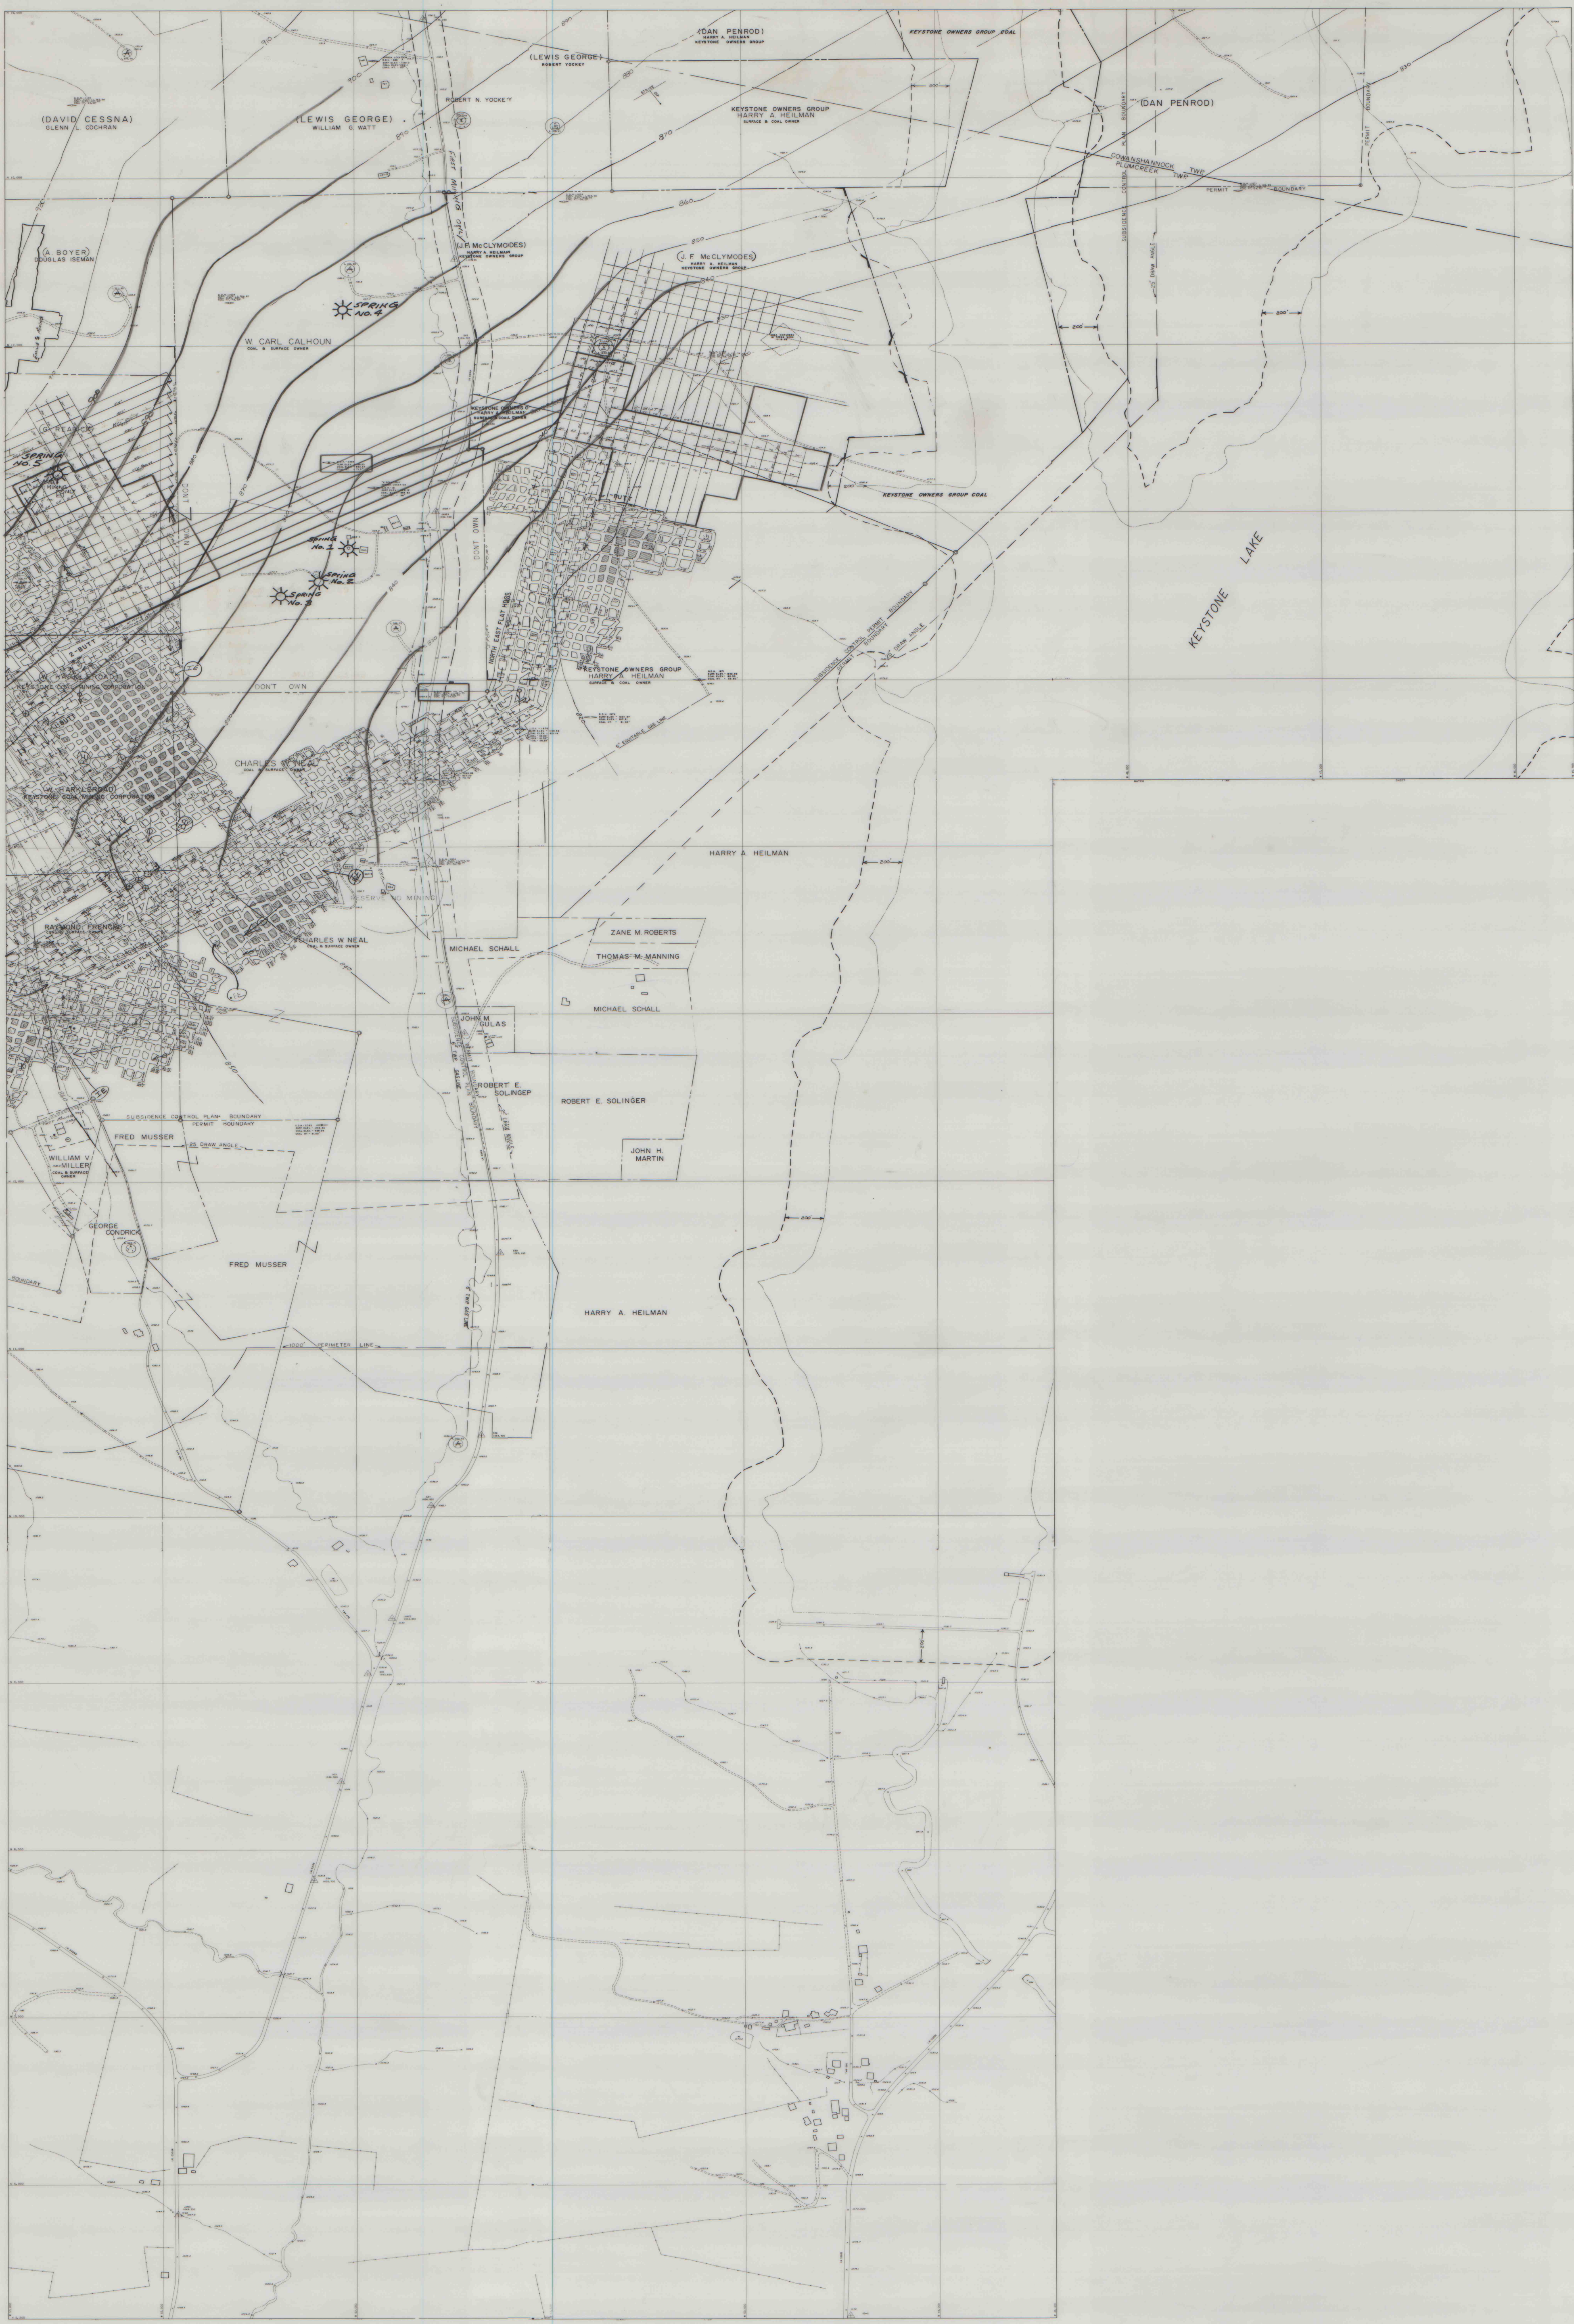

MATCH TO SHEET 2

