



MATCH TO SHEET 1


JANE MINE (MSHA) No. 3600823
JANE MINE PERMIT (DER) No. 03831305

(COAL SEAM)
LOWER FREEPORT

JANE MINE
KEYSTONE COAL MINING CORP.
PLUMOREEK & COWANSHANNOCK TWP. ARMSTRONG CO.

MATCH TO SHEET 2

MATCH TO SHEET 11

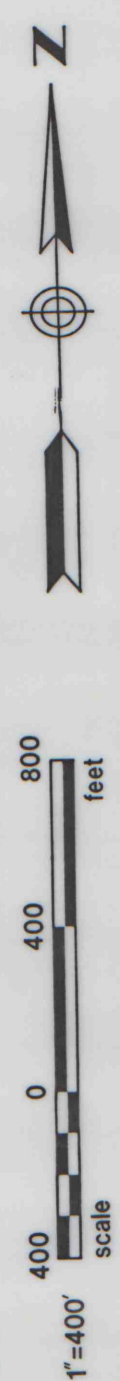

POSTING DATE 1-31-1930