
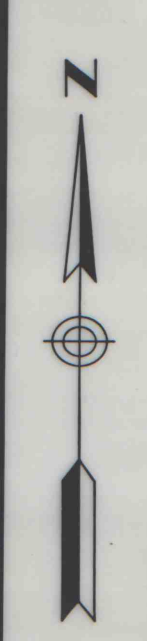


MATCH TO SHEET 35

MATCH TO SHEET 33

POSTING DATE 1-31-1990

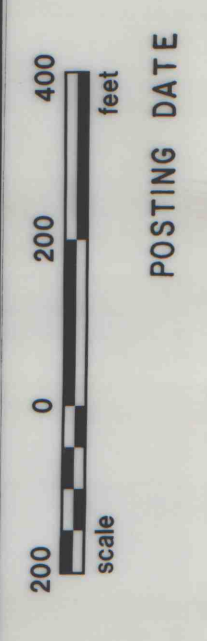

JANE MINE (MSHA) No. 3600823
LOWER FREEPORT PLUMCREEK & COWANSHANNOCK TWP ARMSTRONG CO
JANE MINE

MATCH TO SHEET 33