




MATCH TO SHEET 10

MATCH TO SHEET 12

MATCH TO SHEET 2

MATCH TO SHEET 15

JANE MINE (MSHA) No. 3600823
JANE MINE PERMIT (DER) No. 03931305
(COAL SEAM)
LOWER FREEPORT
JANE MINE
KEYSTONE COAL MINING CORP.
PLUMCREEK & COWANSHANNOCK TWP. ARMSTRONG CO.

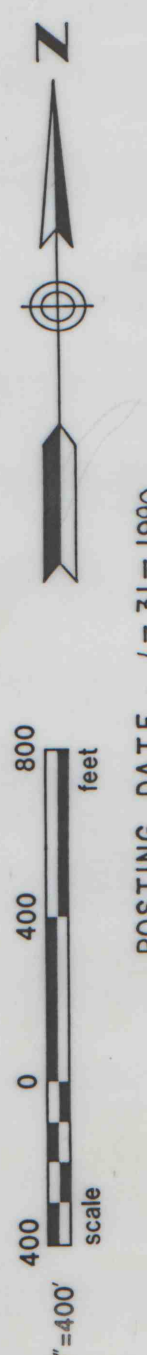

POSTING DATE 1-31-1990