②

MATCH TO SHEET 3

MATCH TO SHEET 6

MATCH TO SHEET 8

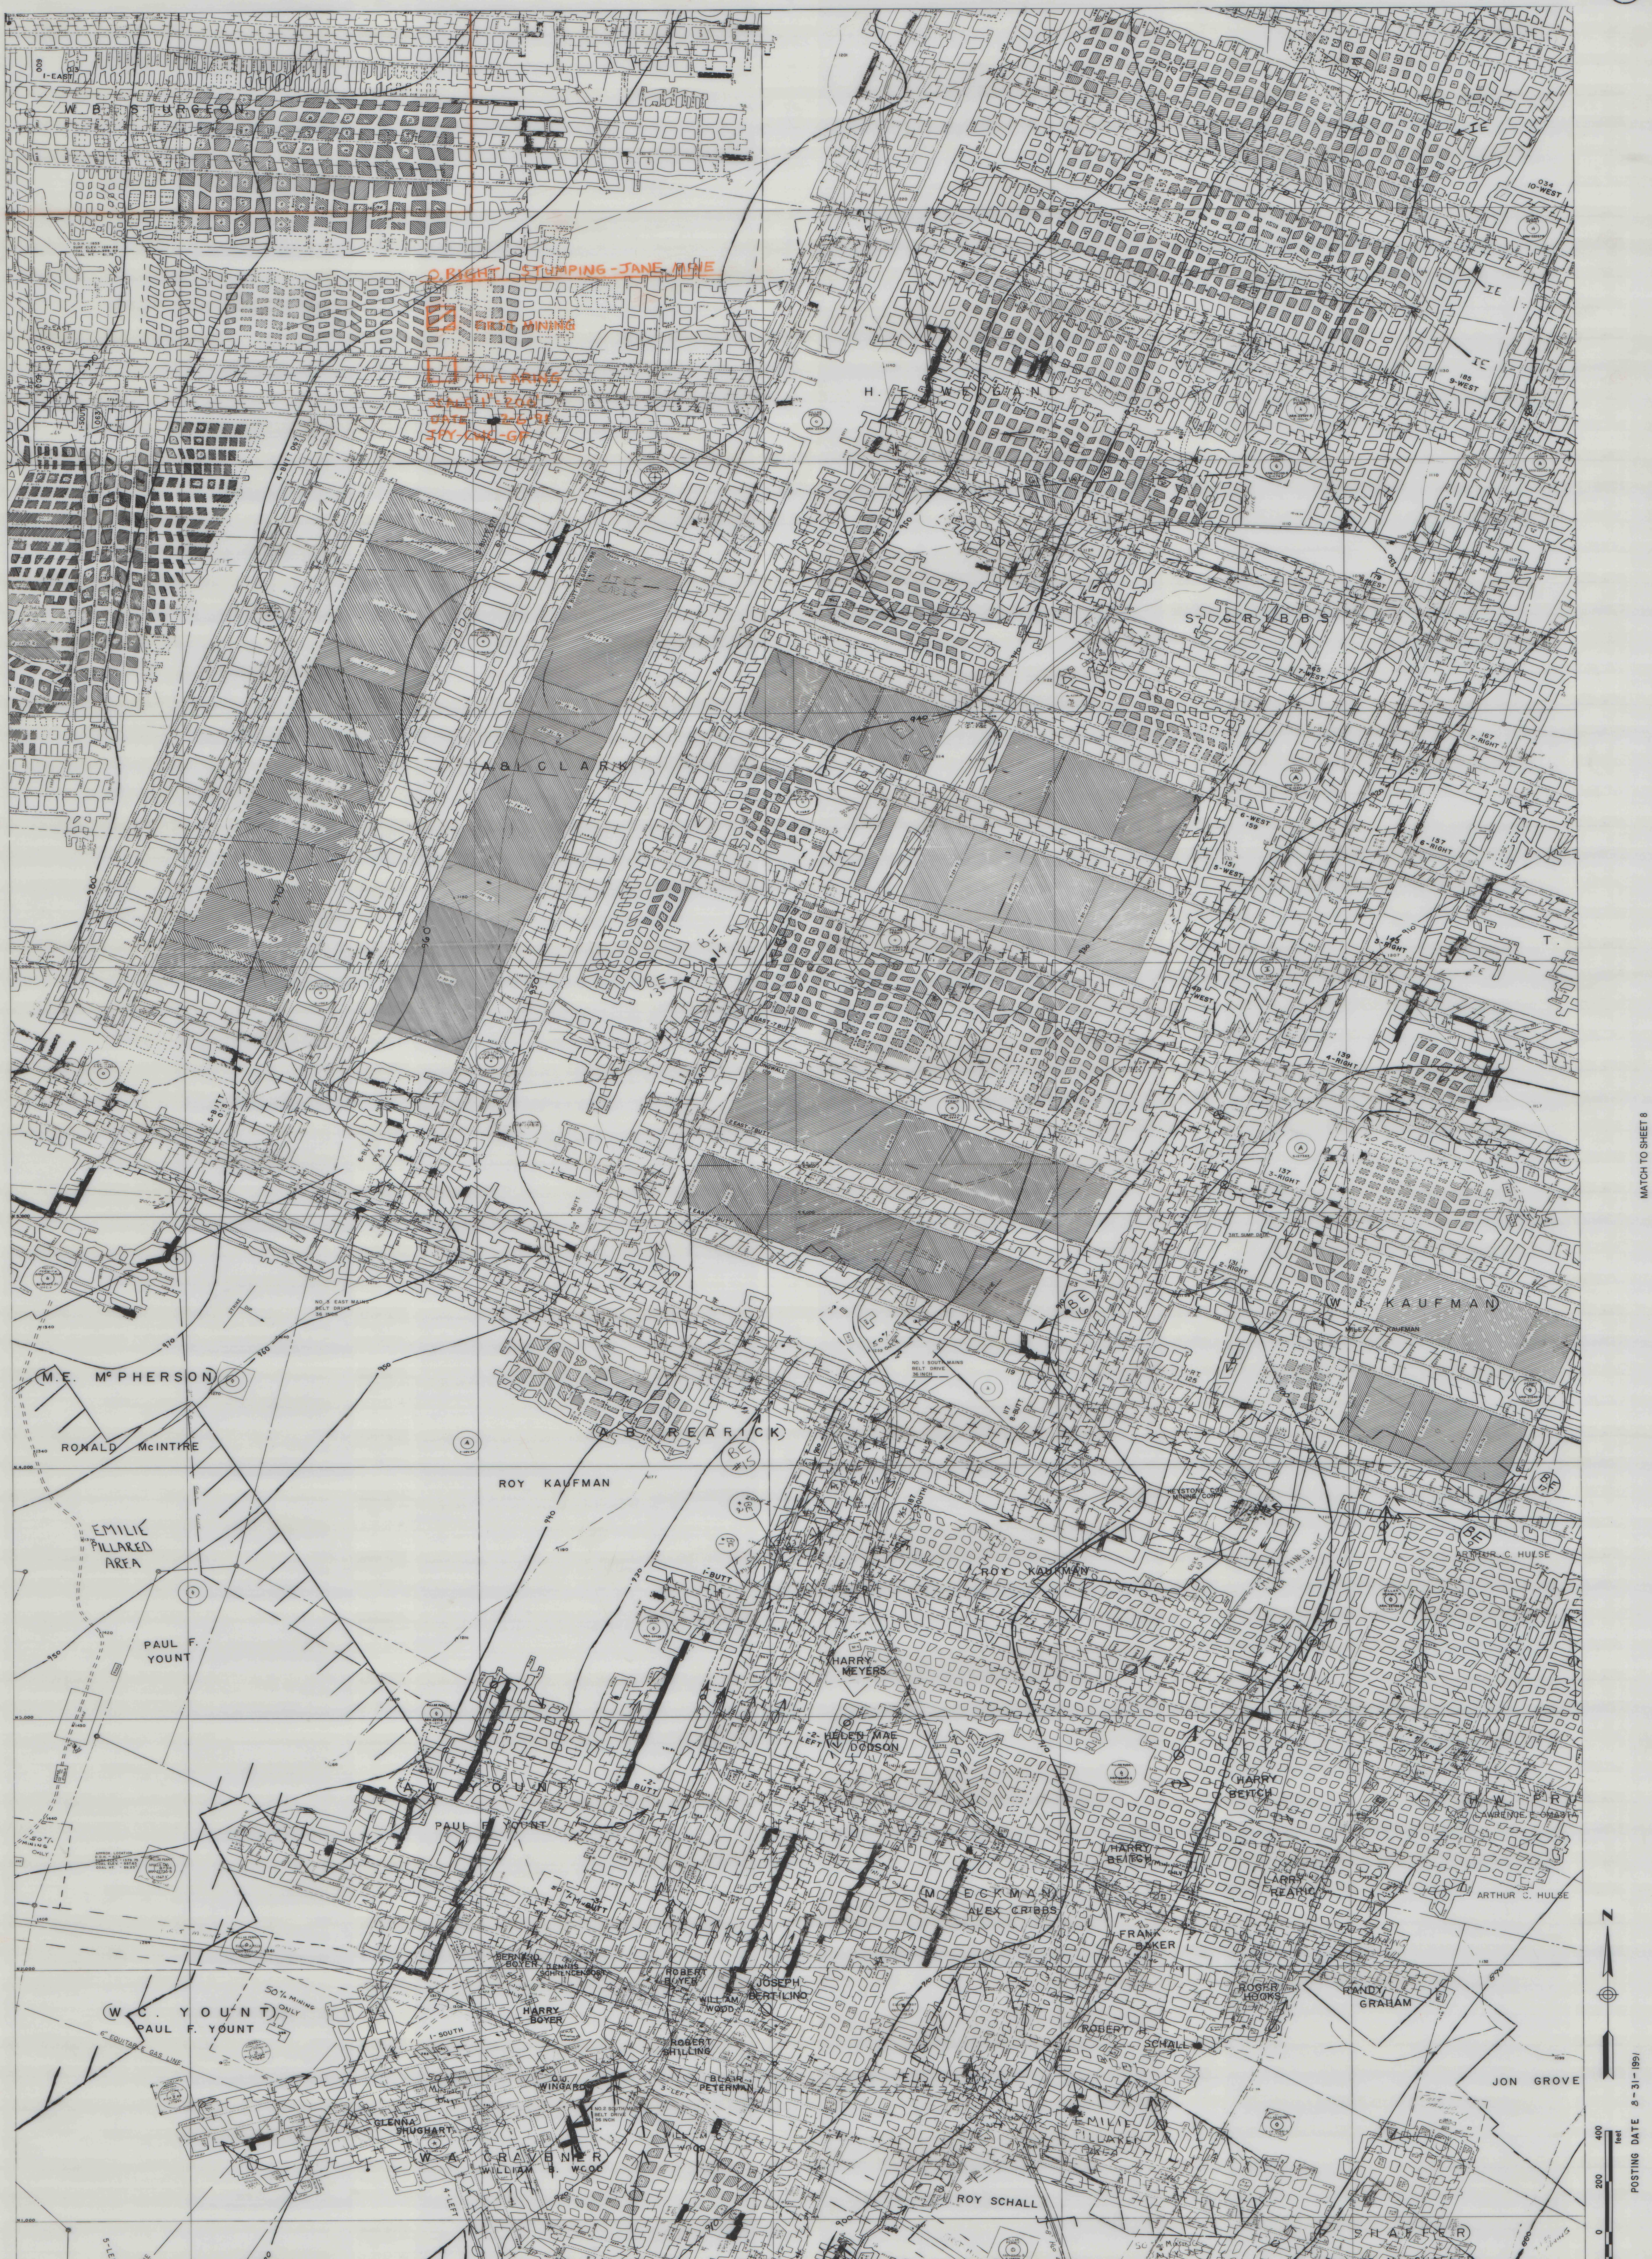
O RIGHT STUMPING - JANE MINE
FIRST MINING
PILLARING
SCALE 1"=200'
DATE 2-6-91
JPY-CWC-GF
W. B. STURGEON
1-EAST
2-EAST
1-SOUTH
4-BUTT
5-BUTT
6-BUTT
A & I CLARK
H. E. WEIGAND
S. CRIBBS
10-WEST
9-WEST
8-WEST
7-WEST
6-WEST
5-WEST
4-WEST
7-RIGHT
6-RIGHT
5-RIGHT
4-RIGHT
3-RIGHT
2-RIGHT
1-RT.
8-BUTT
LONGWALL
W. J. KAUFMAN
MILES E. KAUFMAN
NO. 3 EAST MAINS BELT DRIVE 36 INCH
NO. 1 SOUTH MAINS BELT DRIVE 36 INCH
NO. 2 SOUTH MAINS BELT DRIVE 36 INCH
STRIKE
DIP
M.E. McPHERSON
RONALD McINTIRE
A. B. REARICK
ROY KAUFMAN
EMILIE PILLARED AREA
PAUL F. YOUNT
KEYSTONE COAL MINING CORP.
ARTHUR C. HULSE
1-BUTT
-2-BUTT
-3-BUTT
2-LEFT
3-LEFT
4-LEFT
5-LEFT
HARRY MEYERS
HELEN MAE DODSON
A. J. YOUNT
HARRY BEITCH
LAWRENCE E. OMASTA
H. W. PRU
LARRY REARIC
M. ECKMAN
ALEX CRIBBS
FRANK BAKER
ROGER HOOKS
RANDY GRAHAM
ROBERT H. SCHALL
JON GROVE
W.C. YOUNT
50% MINING ONLY
FIRST MINING ONLY
6" EQUITABLE GAS LINE
8" PEOPLES GAS LINE
BERNARD BOYER
DENNIS SCHRENCENGOST
ROBERT BOYER
JOSEPH BERTILINO
WILLIAM WOOD
HARRY BOYER
ROBERT SHILLING
O.J. WINGARD
BLAIR PETERMAN
GLENNA SHUGHART
W. A. CRAVENER
WILLIAM B. WOOD
A. E. GLA
EMILIE PILLARED AREA
ROY SCHALL
SHAFFER
HOWARD N. SHAFFER
CLARK THOMAS
DONALD CROWNOVER
KEN SCHALL
PILLAR PERMIT
BE
N
400
200
0
200
feet
scale
1"=200'

POSTING DATE 8-31-1991

JANE MINE (MSHA) No. 3600823
JANE MINE PERMIT (DER) No. 03831305

(COAL SEAM)
LOWER FREEPORT

JANE MINE
KEYSTONE COAL MINING CORP.
PLUMCREEK & COWANSHANNOCK TWP. ARMSTRONG CO.

MATCH TO SHEET 11

⑦