


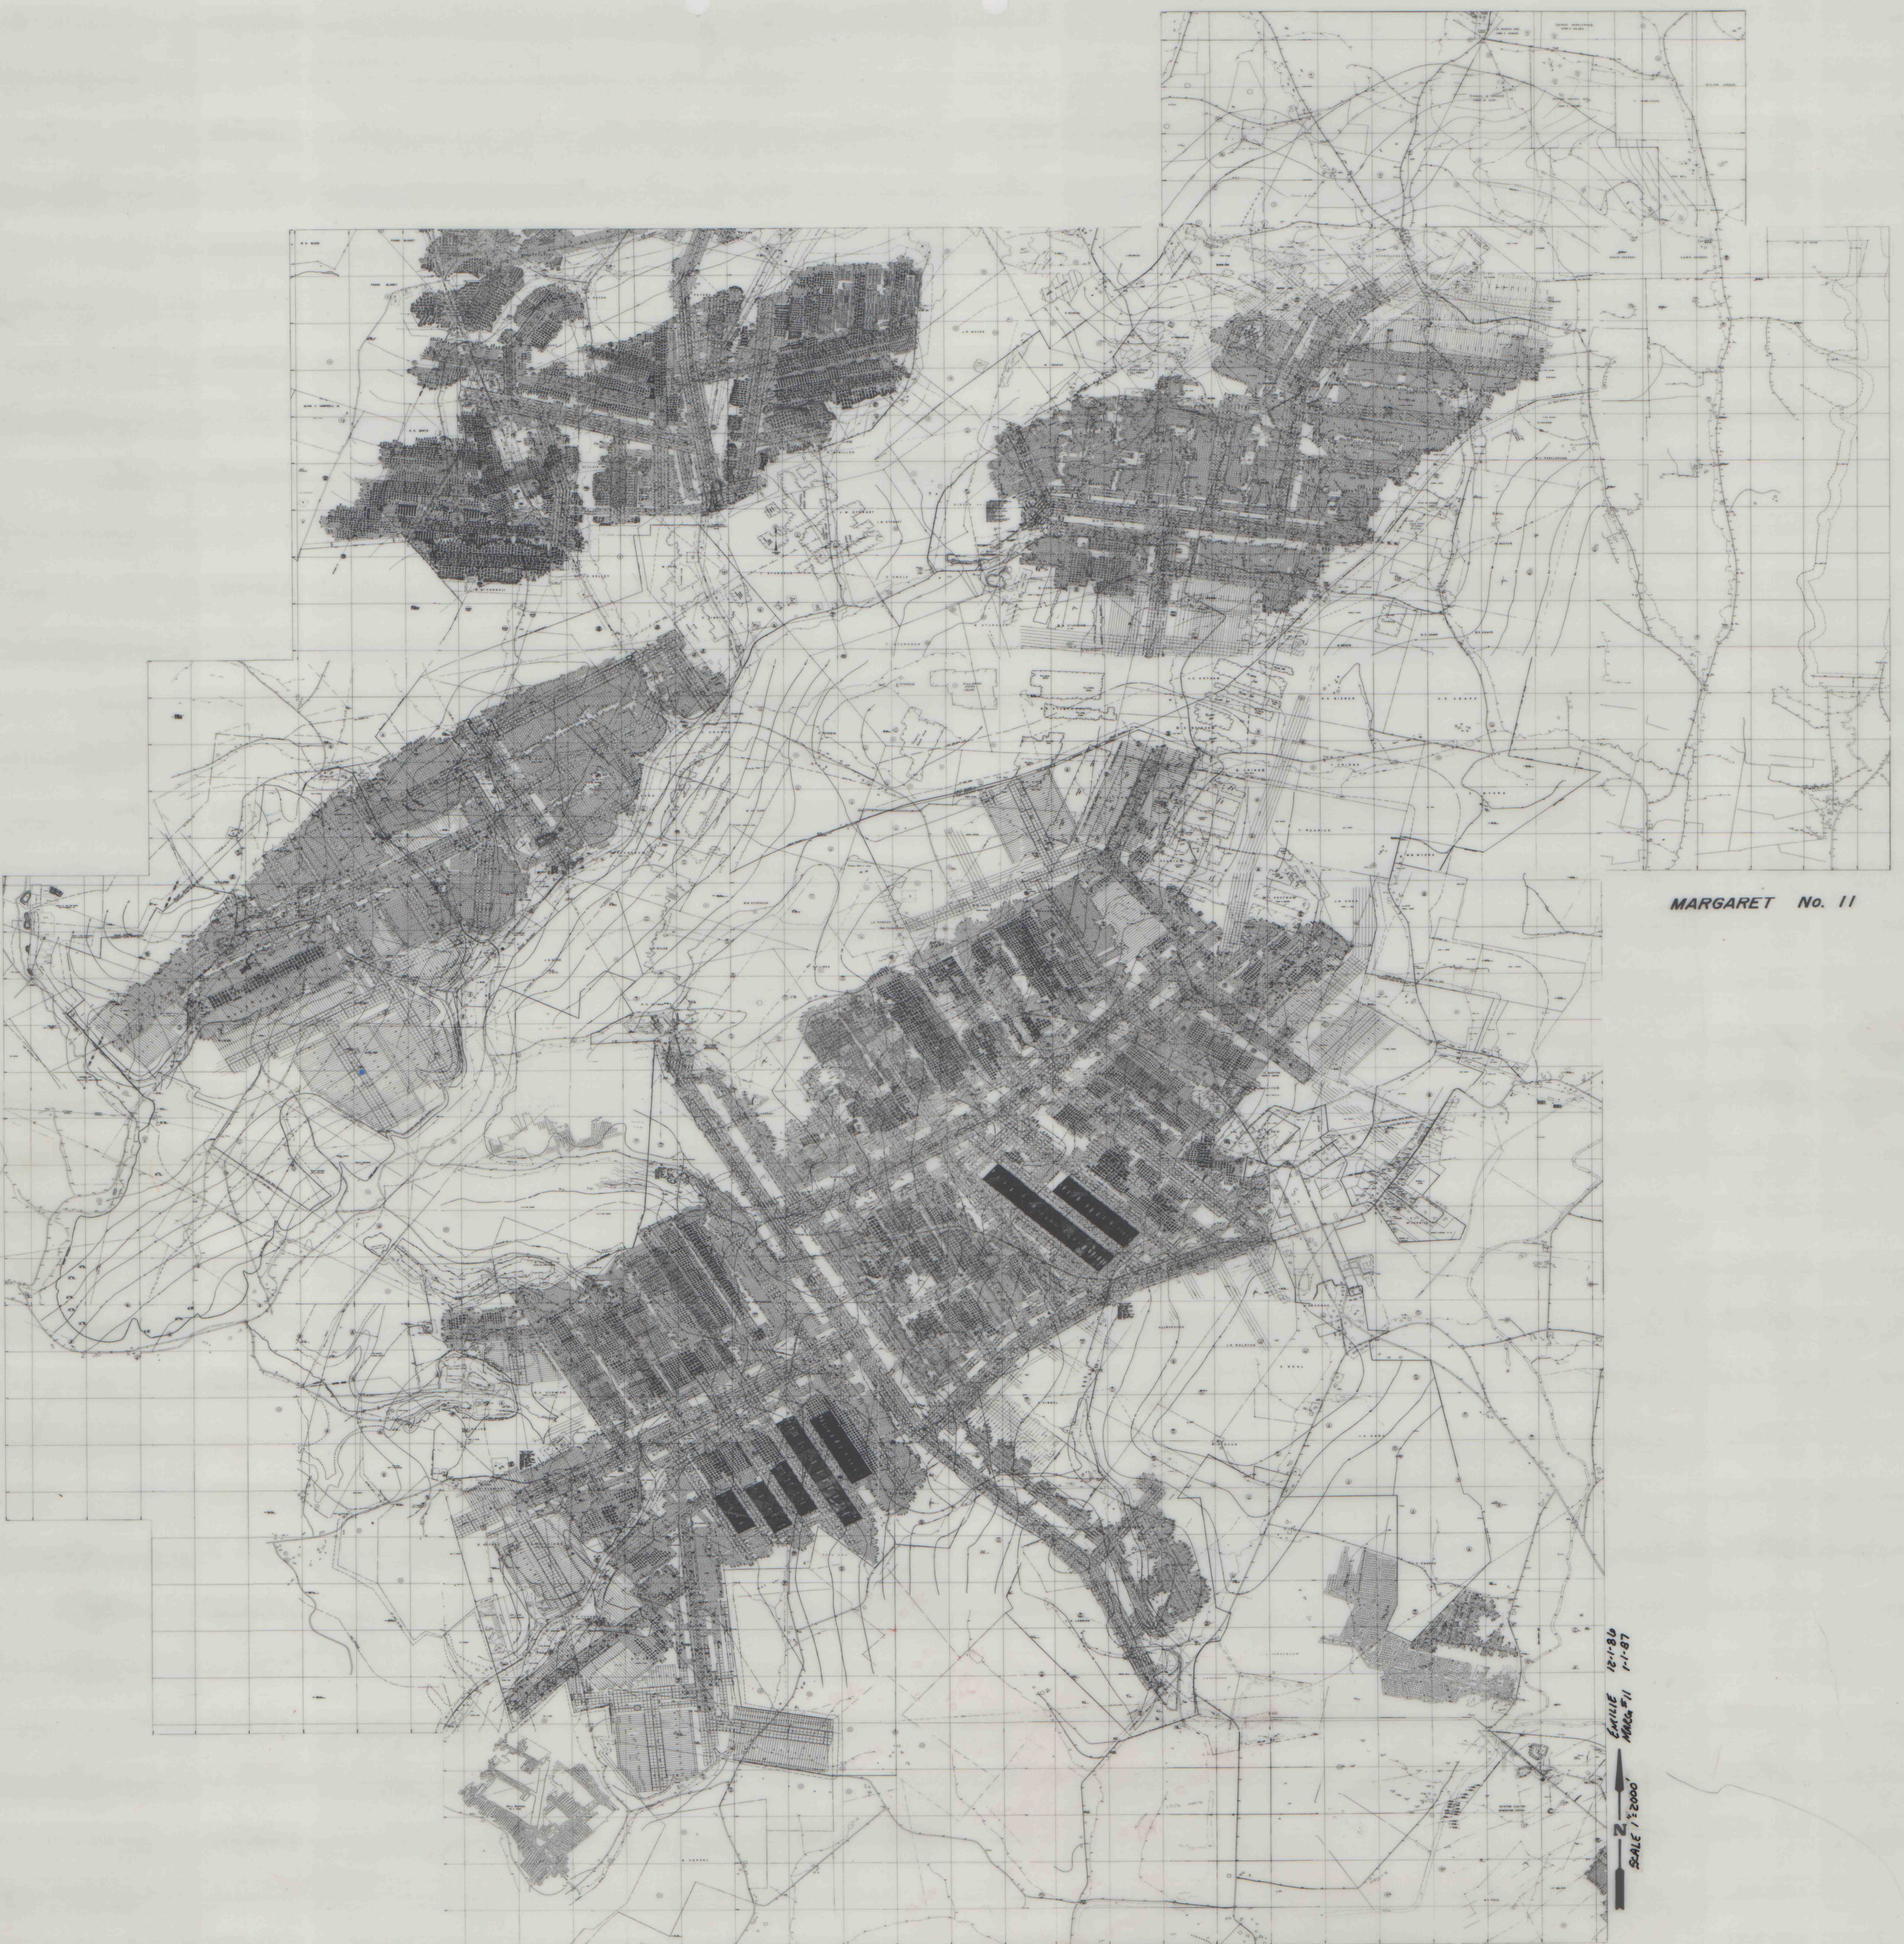

MARGARET No. 11

PLUMCEEK & SOUTH BEND TWPS.
ARMSTRONG COUNTY

EMILIE 12-1-86
MARG. 1-1-87
SCALE 1:2000

EMILIE No. 1 & 2 MINE
(UPPER FREEPORT COAL SEAM)