


MARGARET No. 7


EMILIE No. 4

LEGEND
PERMIT BOUNDARY
SUBSIDY CONTROL PLAN BOUNDARY
UPDATED MINING
2-10-92
1" = 1000'

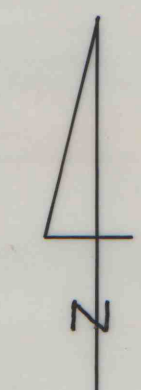

MARGARET
No. 11

POSTING DATE 12-1-1991 1" = 1000'

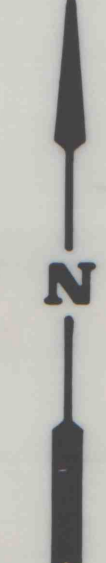

PLUMCREEK & SOUTH BEND TOWNSHIPS,
ARMSTRONG COUNTY

EMILIE No. 1 & 2 MINE
(UPPER FREEPORT COAL SEAM)