


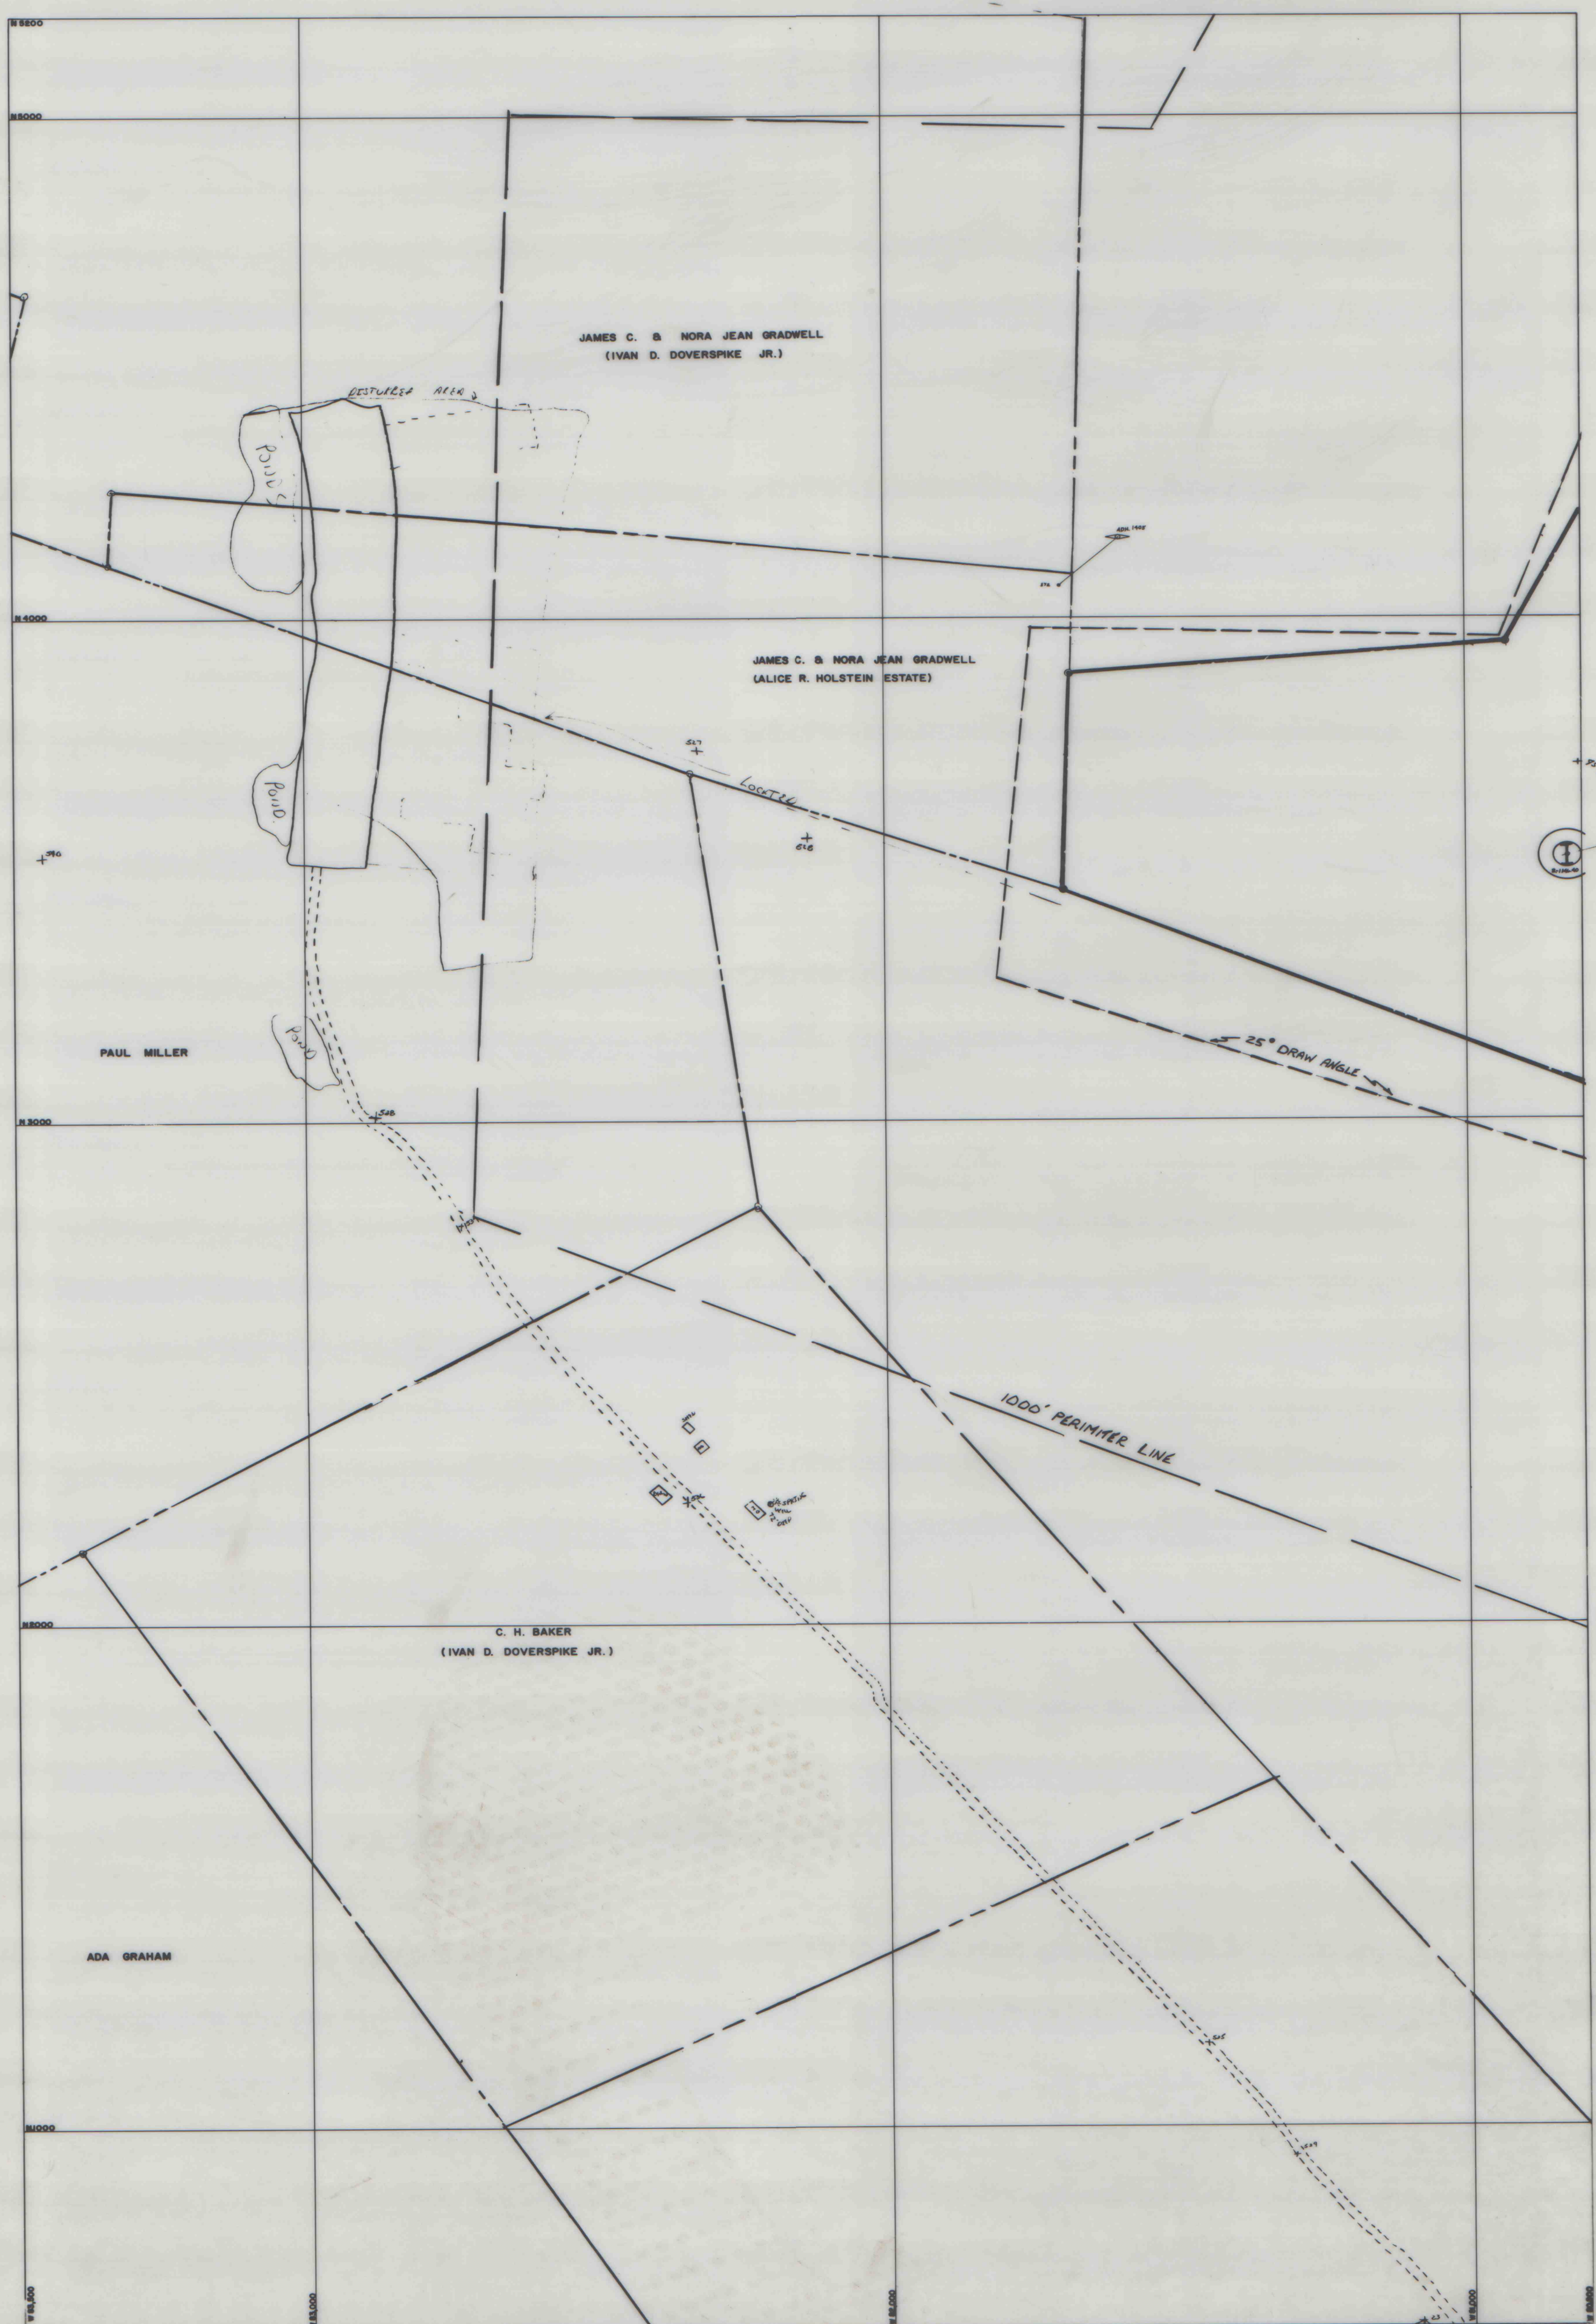

PLUMCEEK & SOUTH BEND TWPS.
ARMSTRONG COUNTY

EMILIE No. 1 & 2 MINE
(UPPER FREEPORT COAL SEAM)