


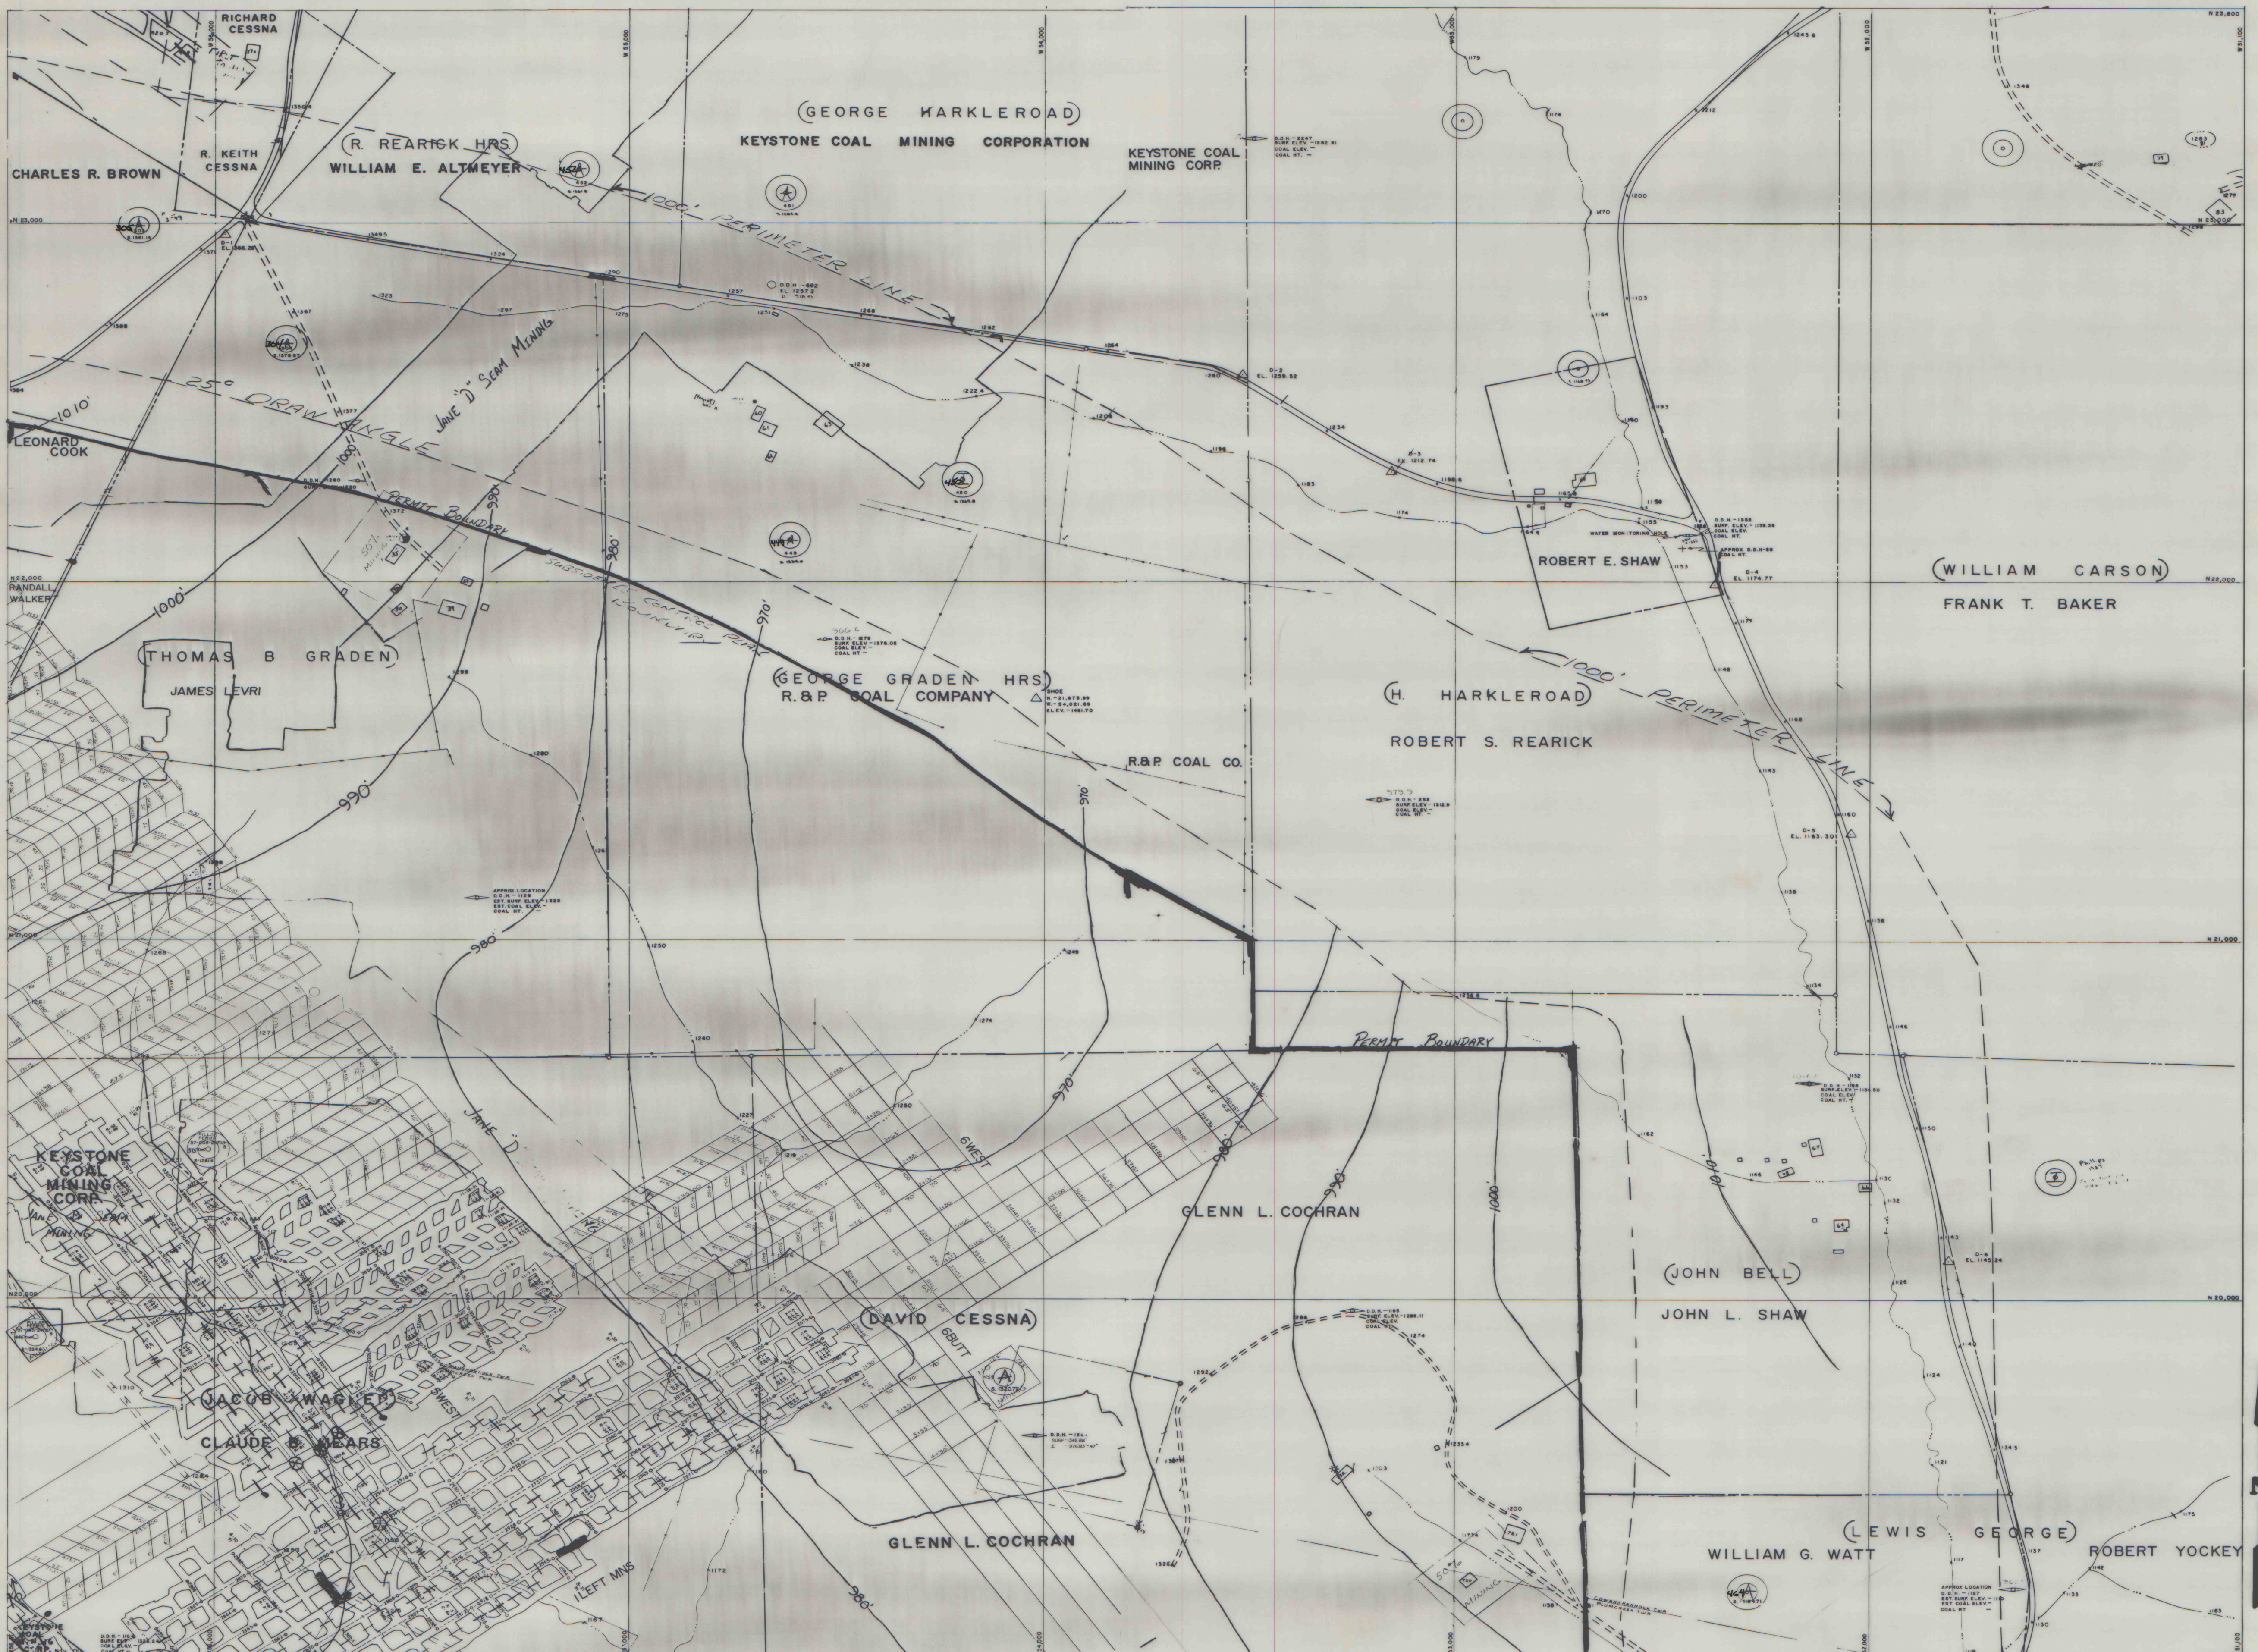

PLUMCEEK & SOUTH BEND TWP.
ARMSTRONG COUNTY

EMILIE No. 1 & 2 MINE
(UPPER FREEPORT COAL SEAM)

POSTING DATE 12-1-1991
N
0 200 400
feet
1"=200' scale