


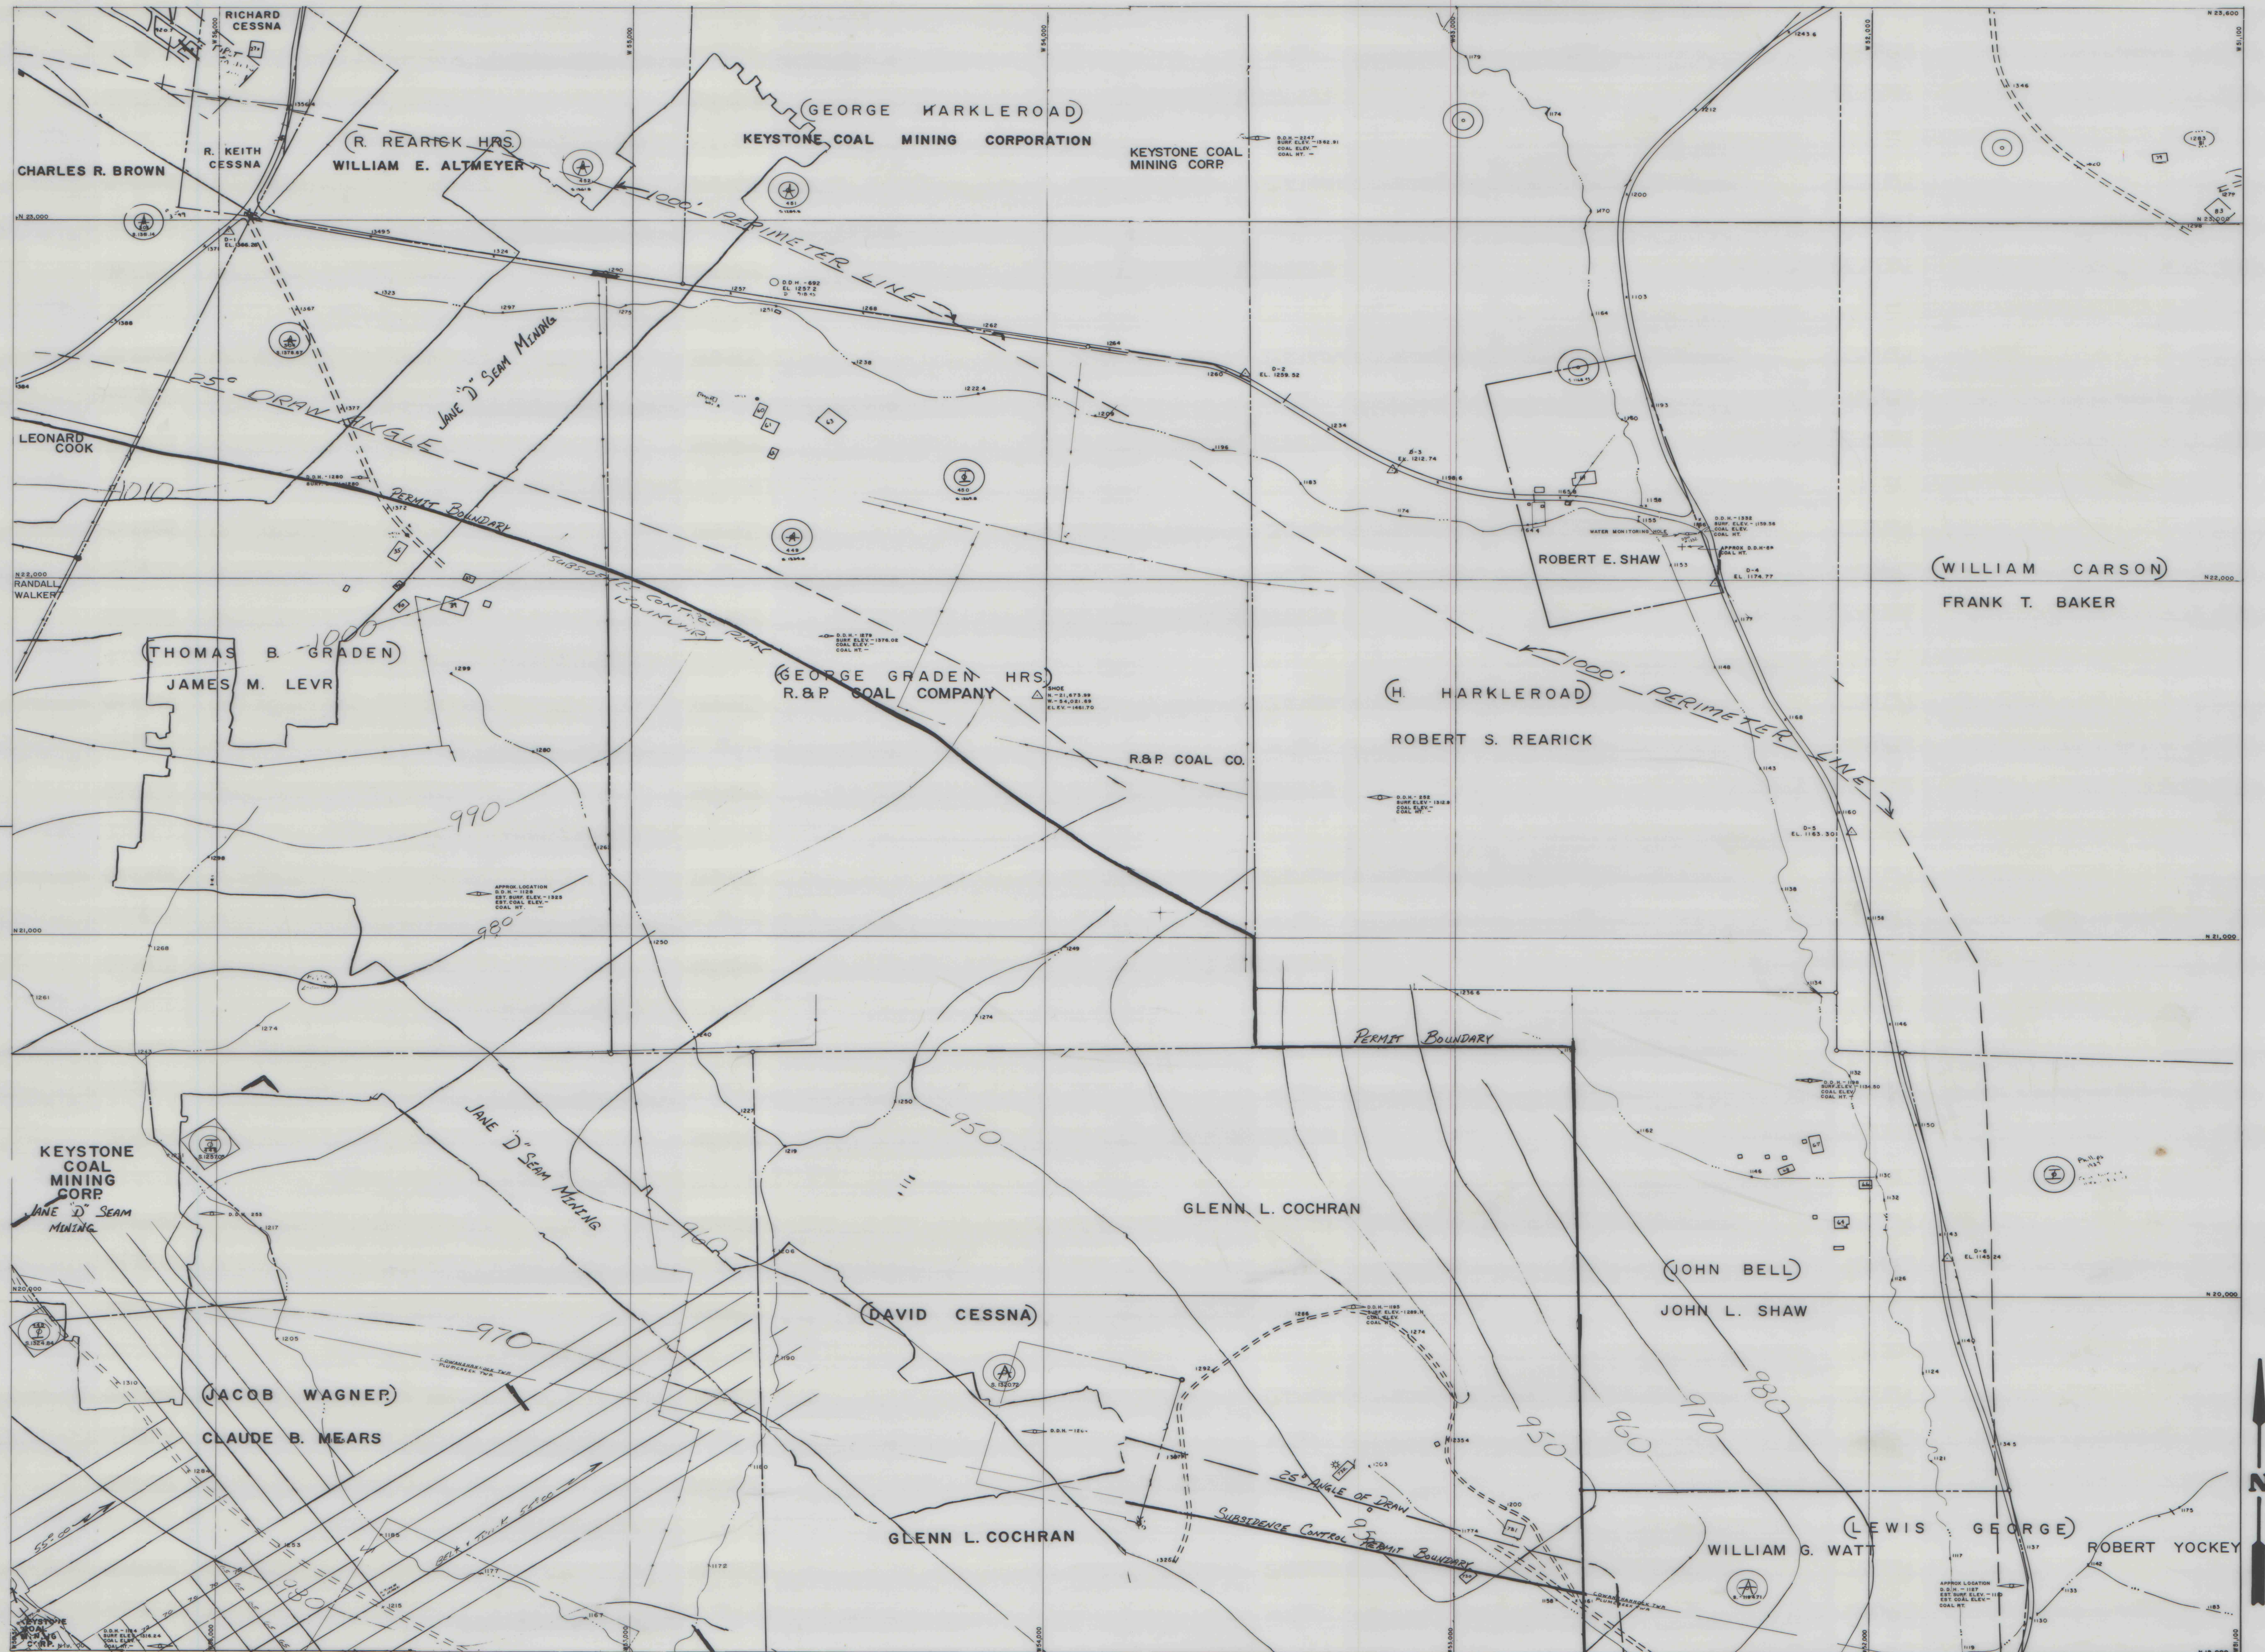

EMILIE No. 1 & 2 MINE
(UPPER FREEPORT COAL SEAM)
PLUMCEEK & SOUTH BEND TOWNSHIPS,
ARMSTRONG COUNTY

POSTING DATE - 1 - 19
200 0 200 400
feet
1"=200' scale