


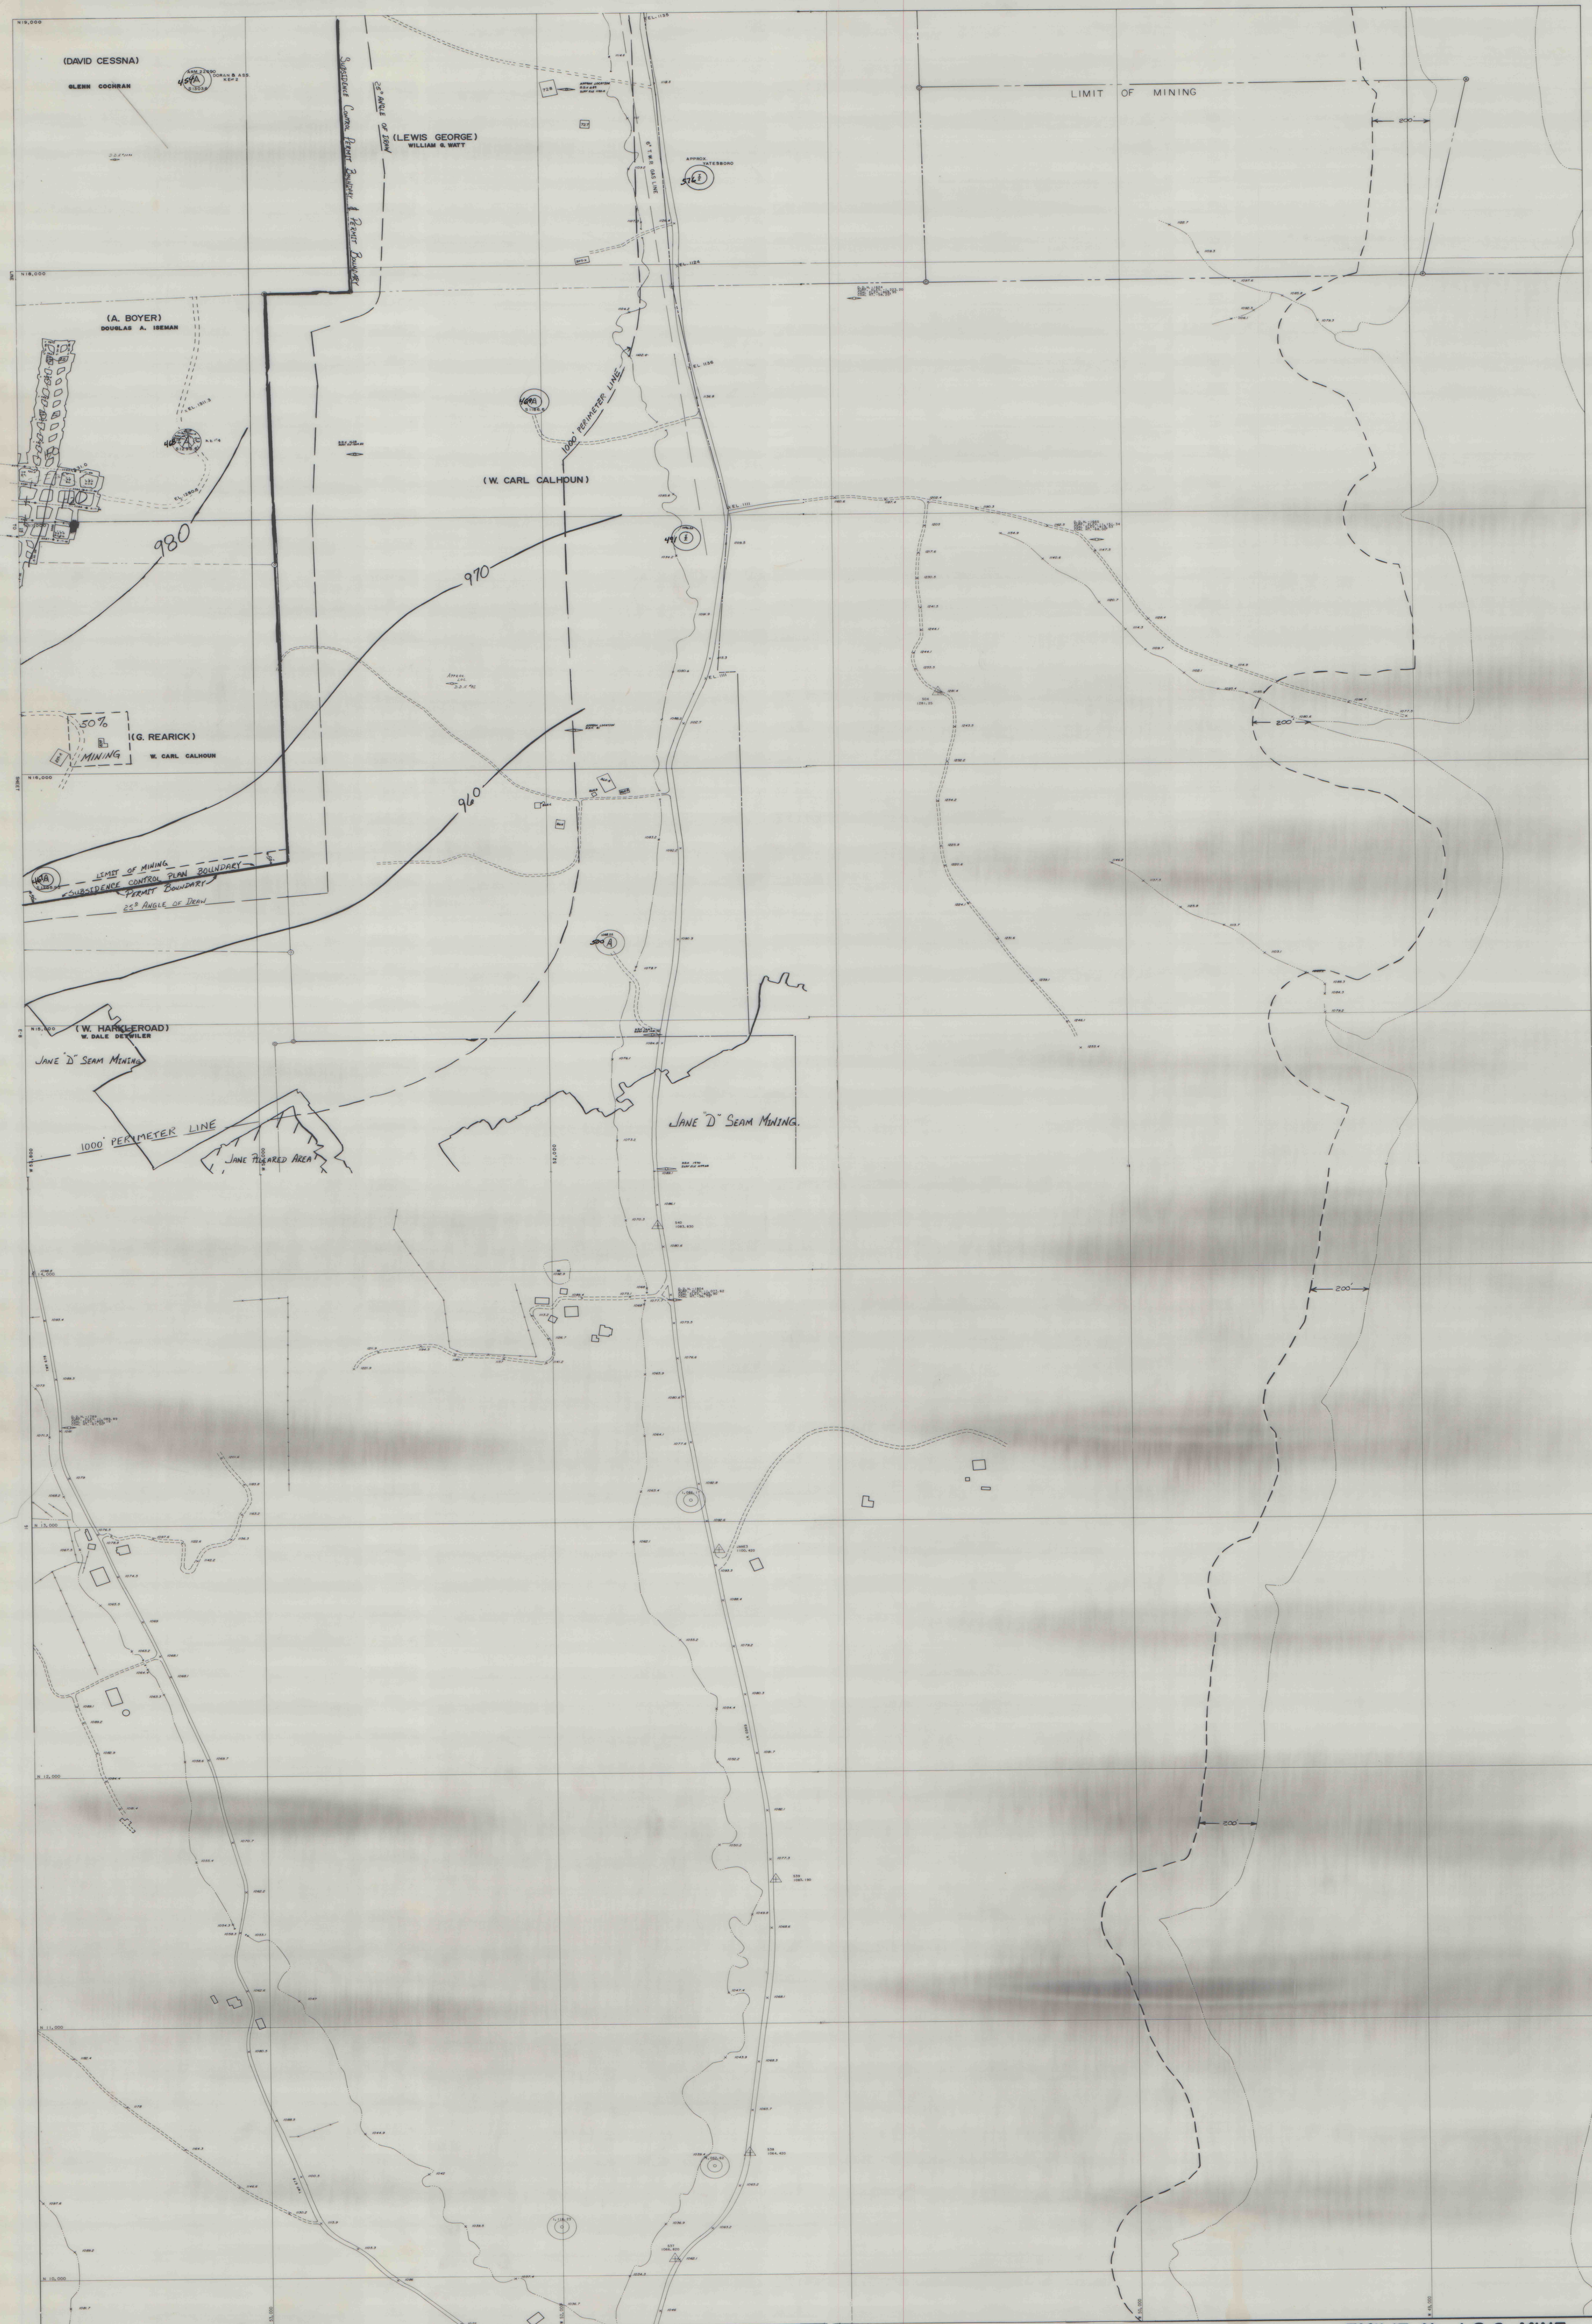

PLUMCEEK & SOUTH BEND TWPS.
ARMSTRONG COUNTY

EMILIE No. 1 & 2 MINE
(UPPER FREEPORT COAL SEAM)

POSTING DATE 7-1-1950

200 0 200 400
feet

1"=200'
Scale