


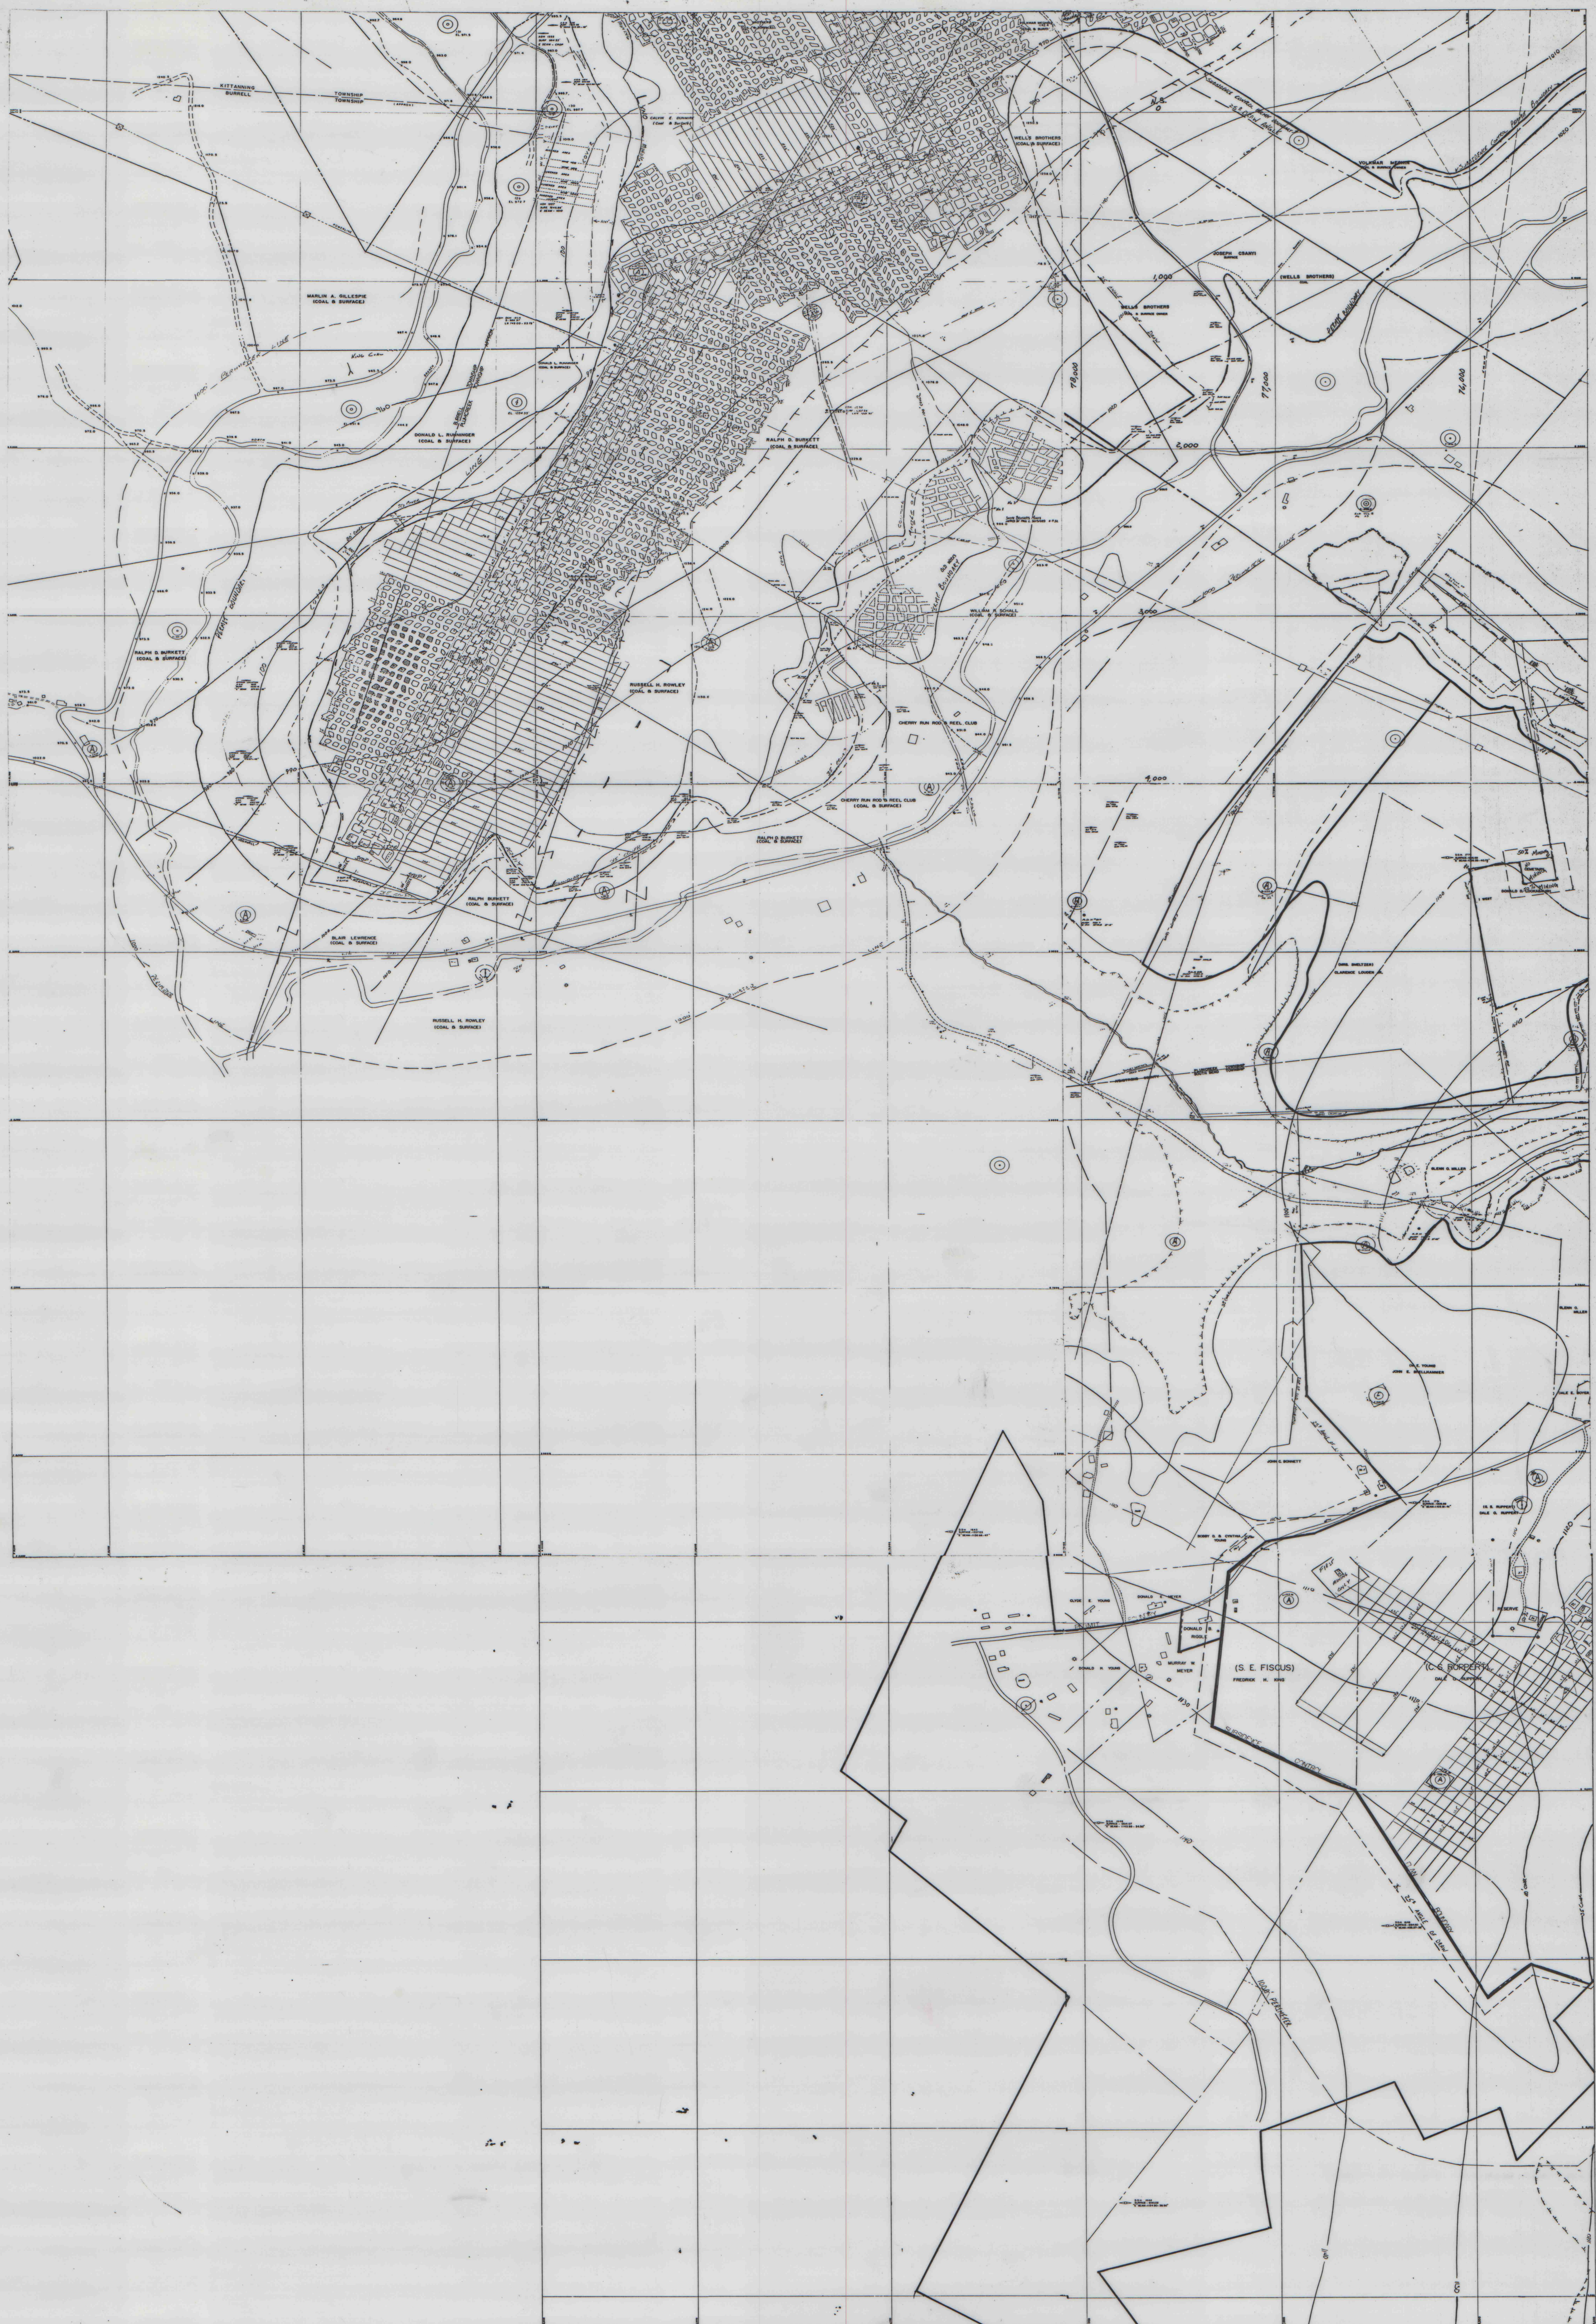

PLUM CREEK & SOUTH BEND TOWNSHIPS.
ARMSTRONG COUNTY

MARGARET No. 11
(UPPER FREEPORT COAL SEAM)

