


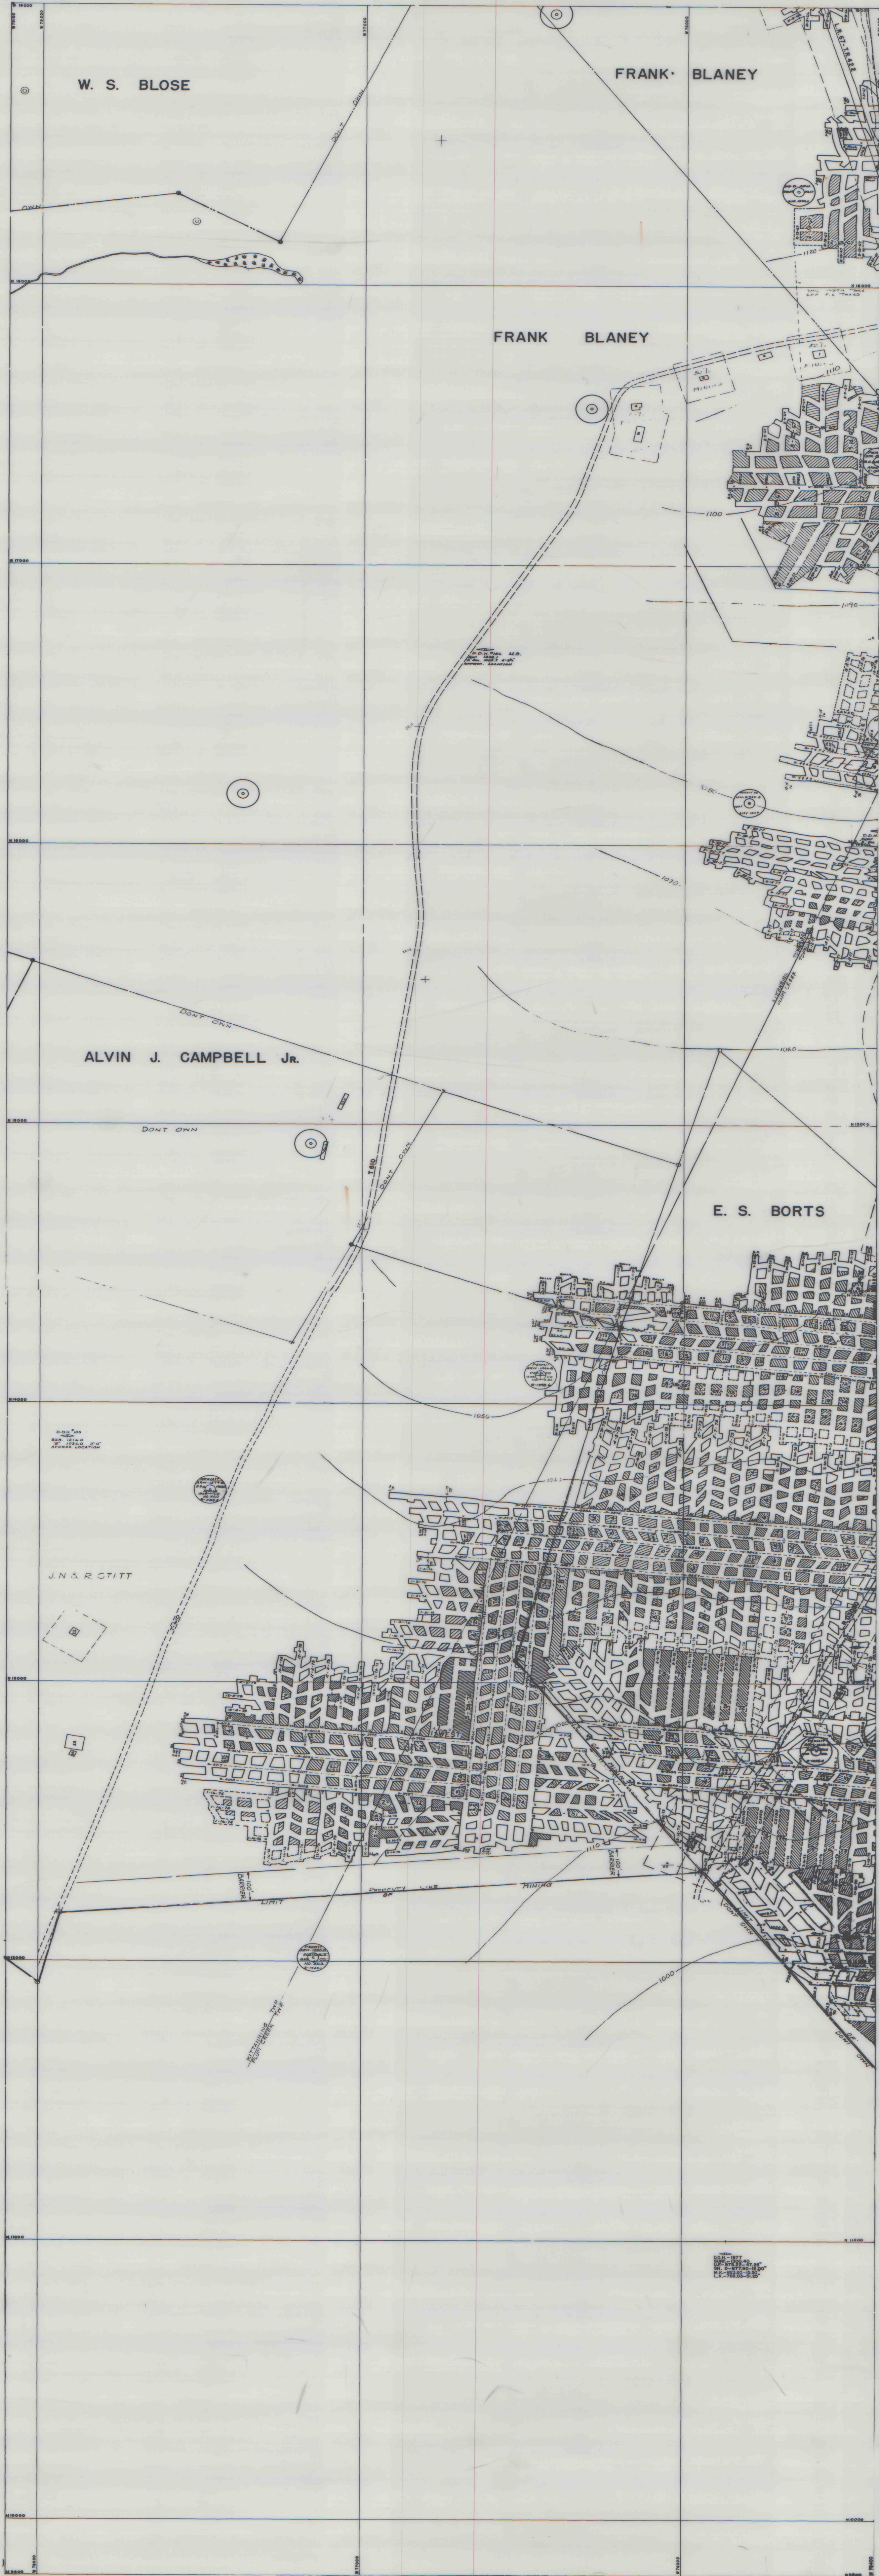

PLUMCREEK & SOUTH BEND TWPS.
ARMSTRONG COUNTY

MARGARET No. 11
(UPPER FREEPORT COAL SEAM)

POSTING DATE 1-1-1986

