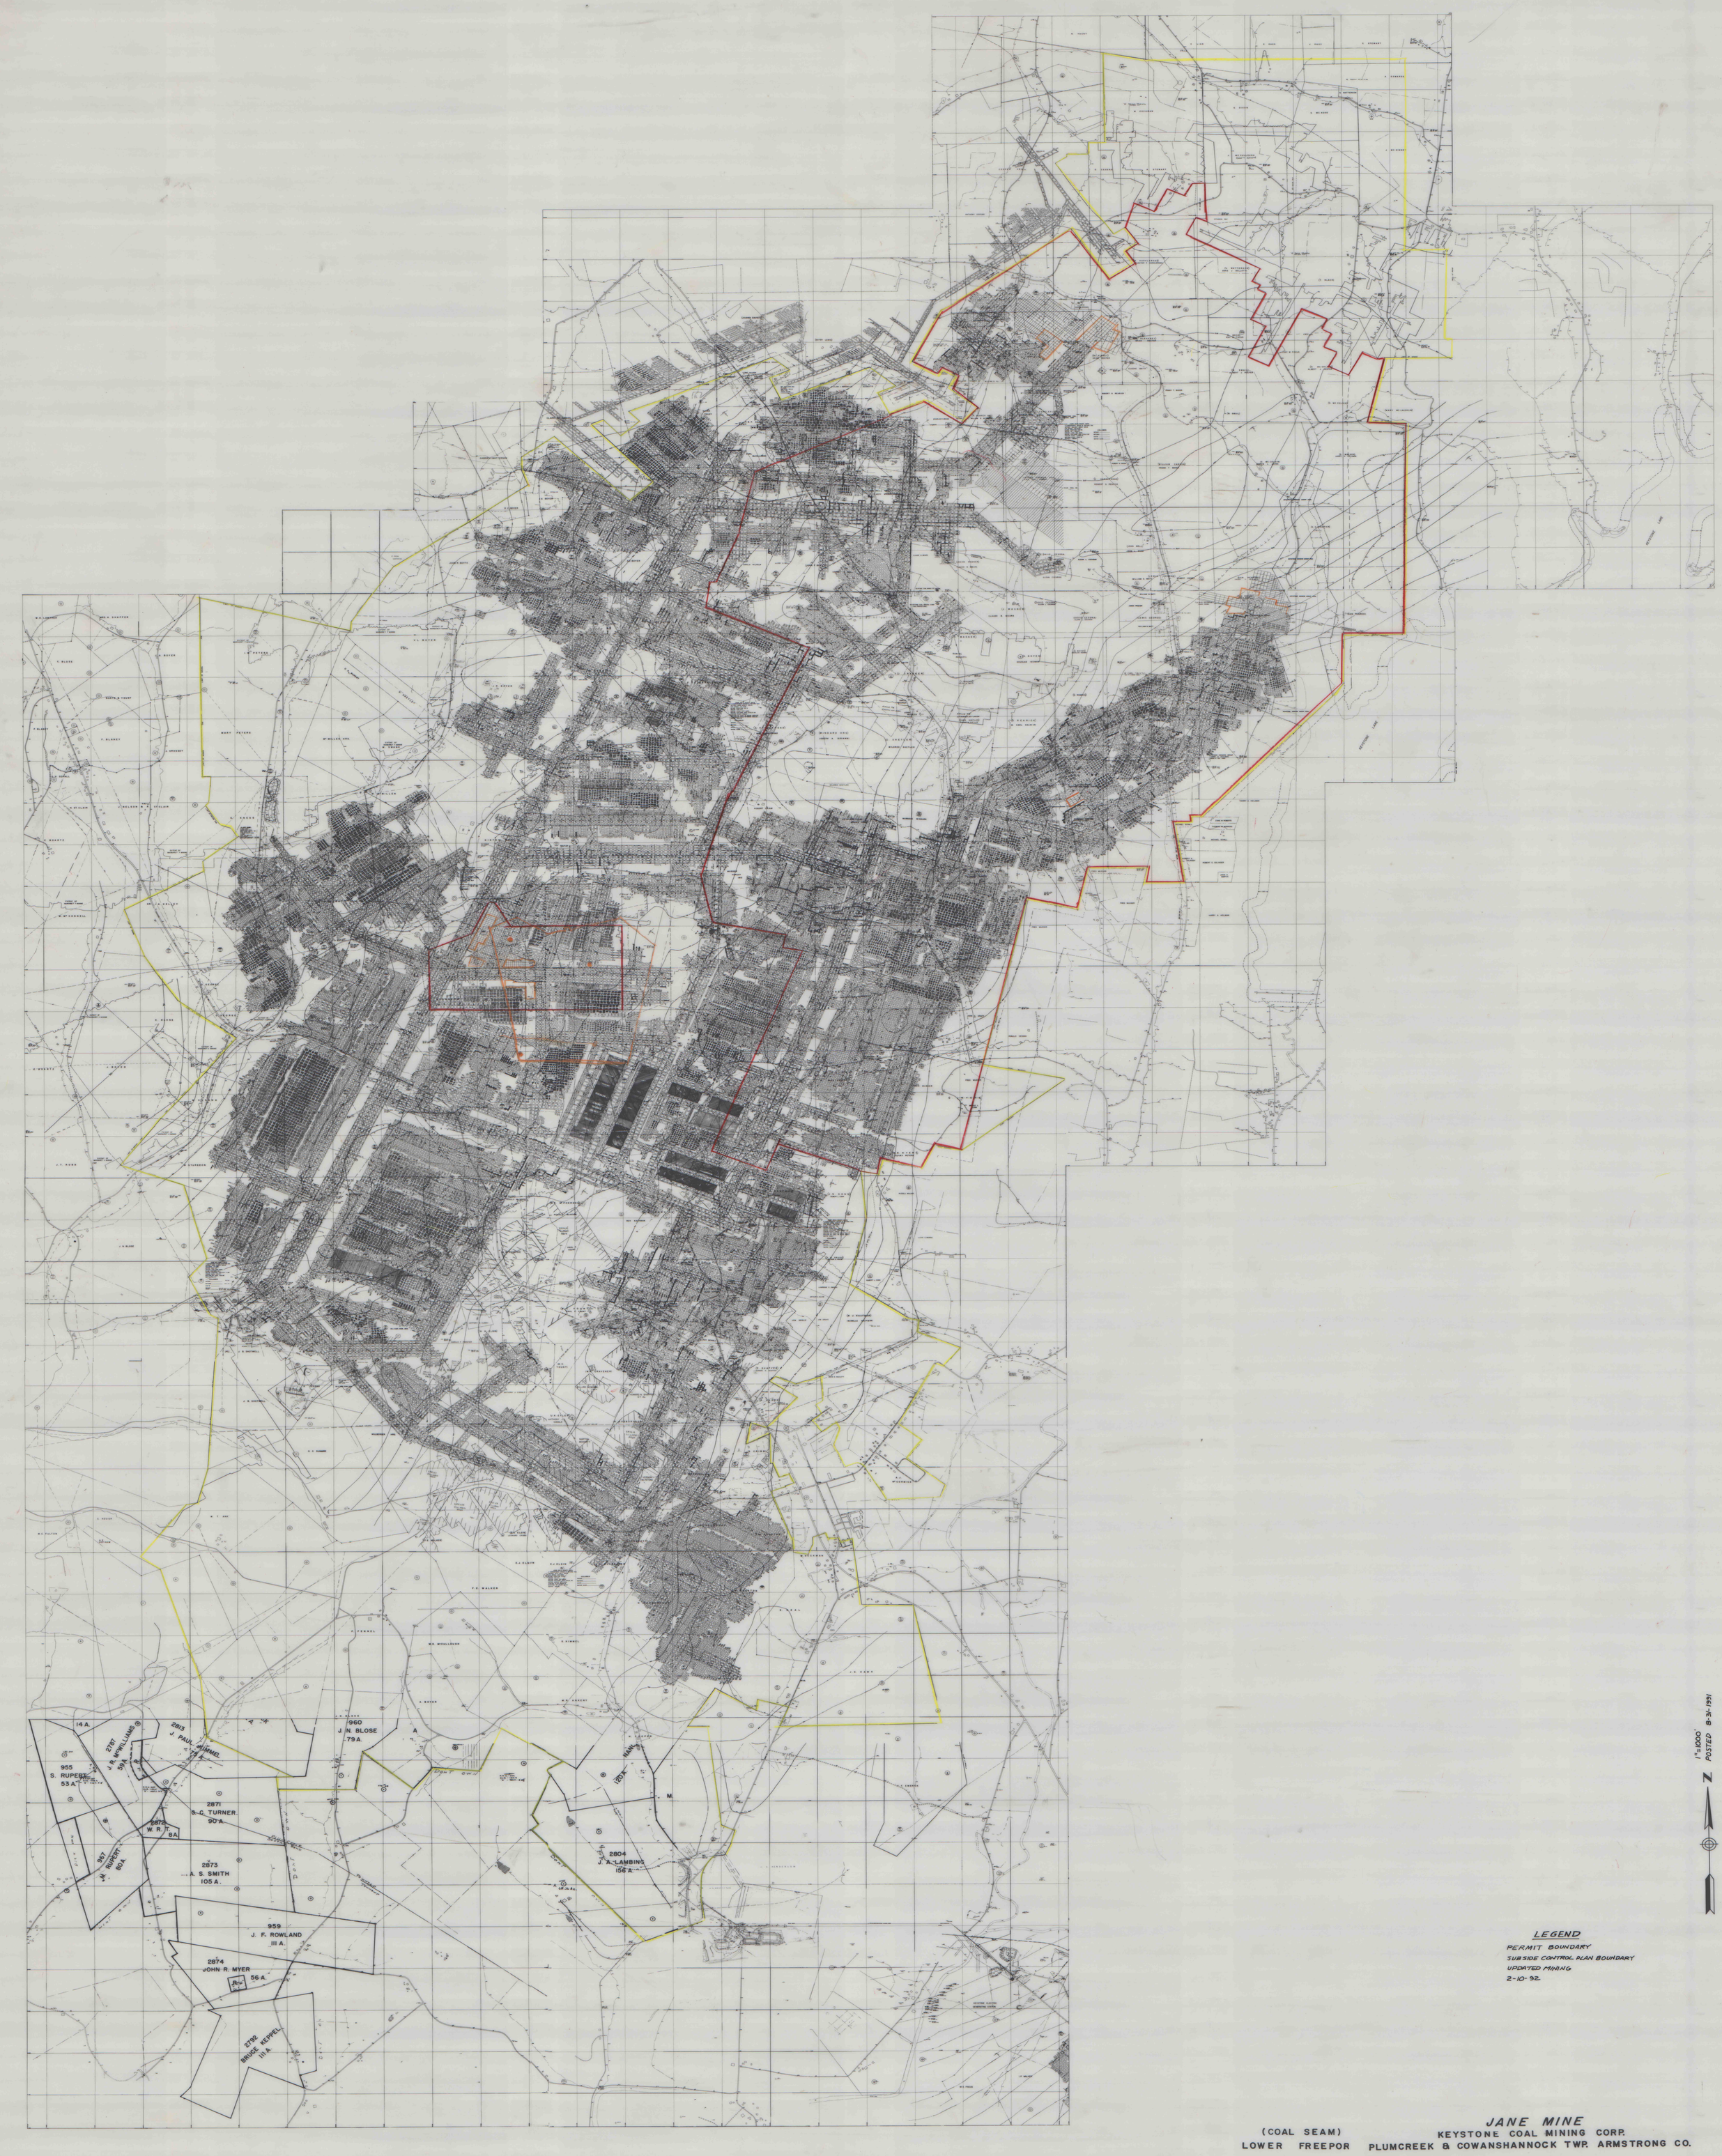

LEGEND

PERMIT BOUNDARY

SUBSIDE CONTROL PLAN BOUNDARY

UPDATED MINING

2-10-92

(COAL SEAM)

LOWER FREEPORT

JANE MINE

KEYSTONE COAL MINING CORP.

PLUMCREEK & COWANSHANNOCK TWP. ARMSTRONG CO.