


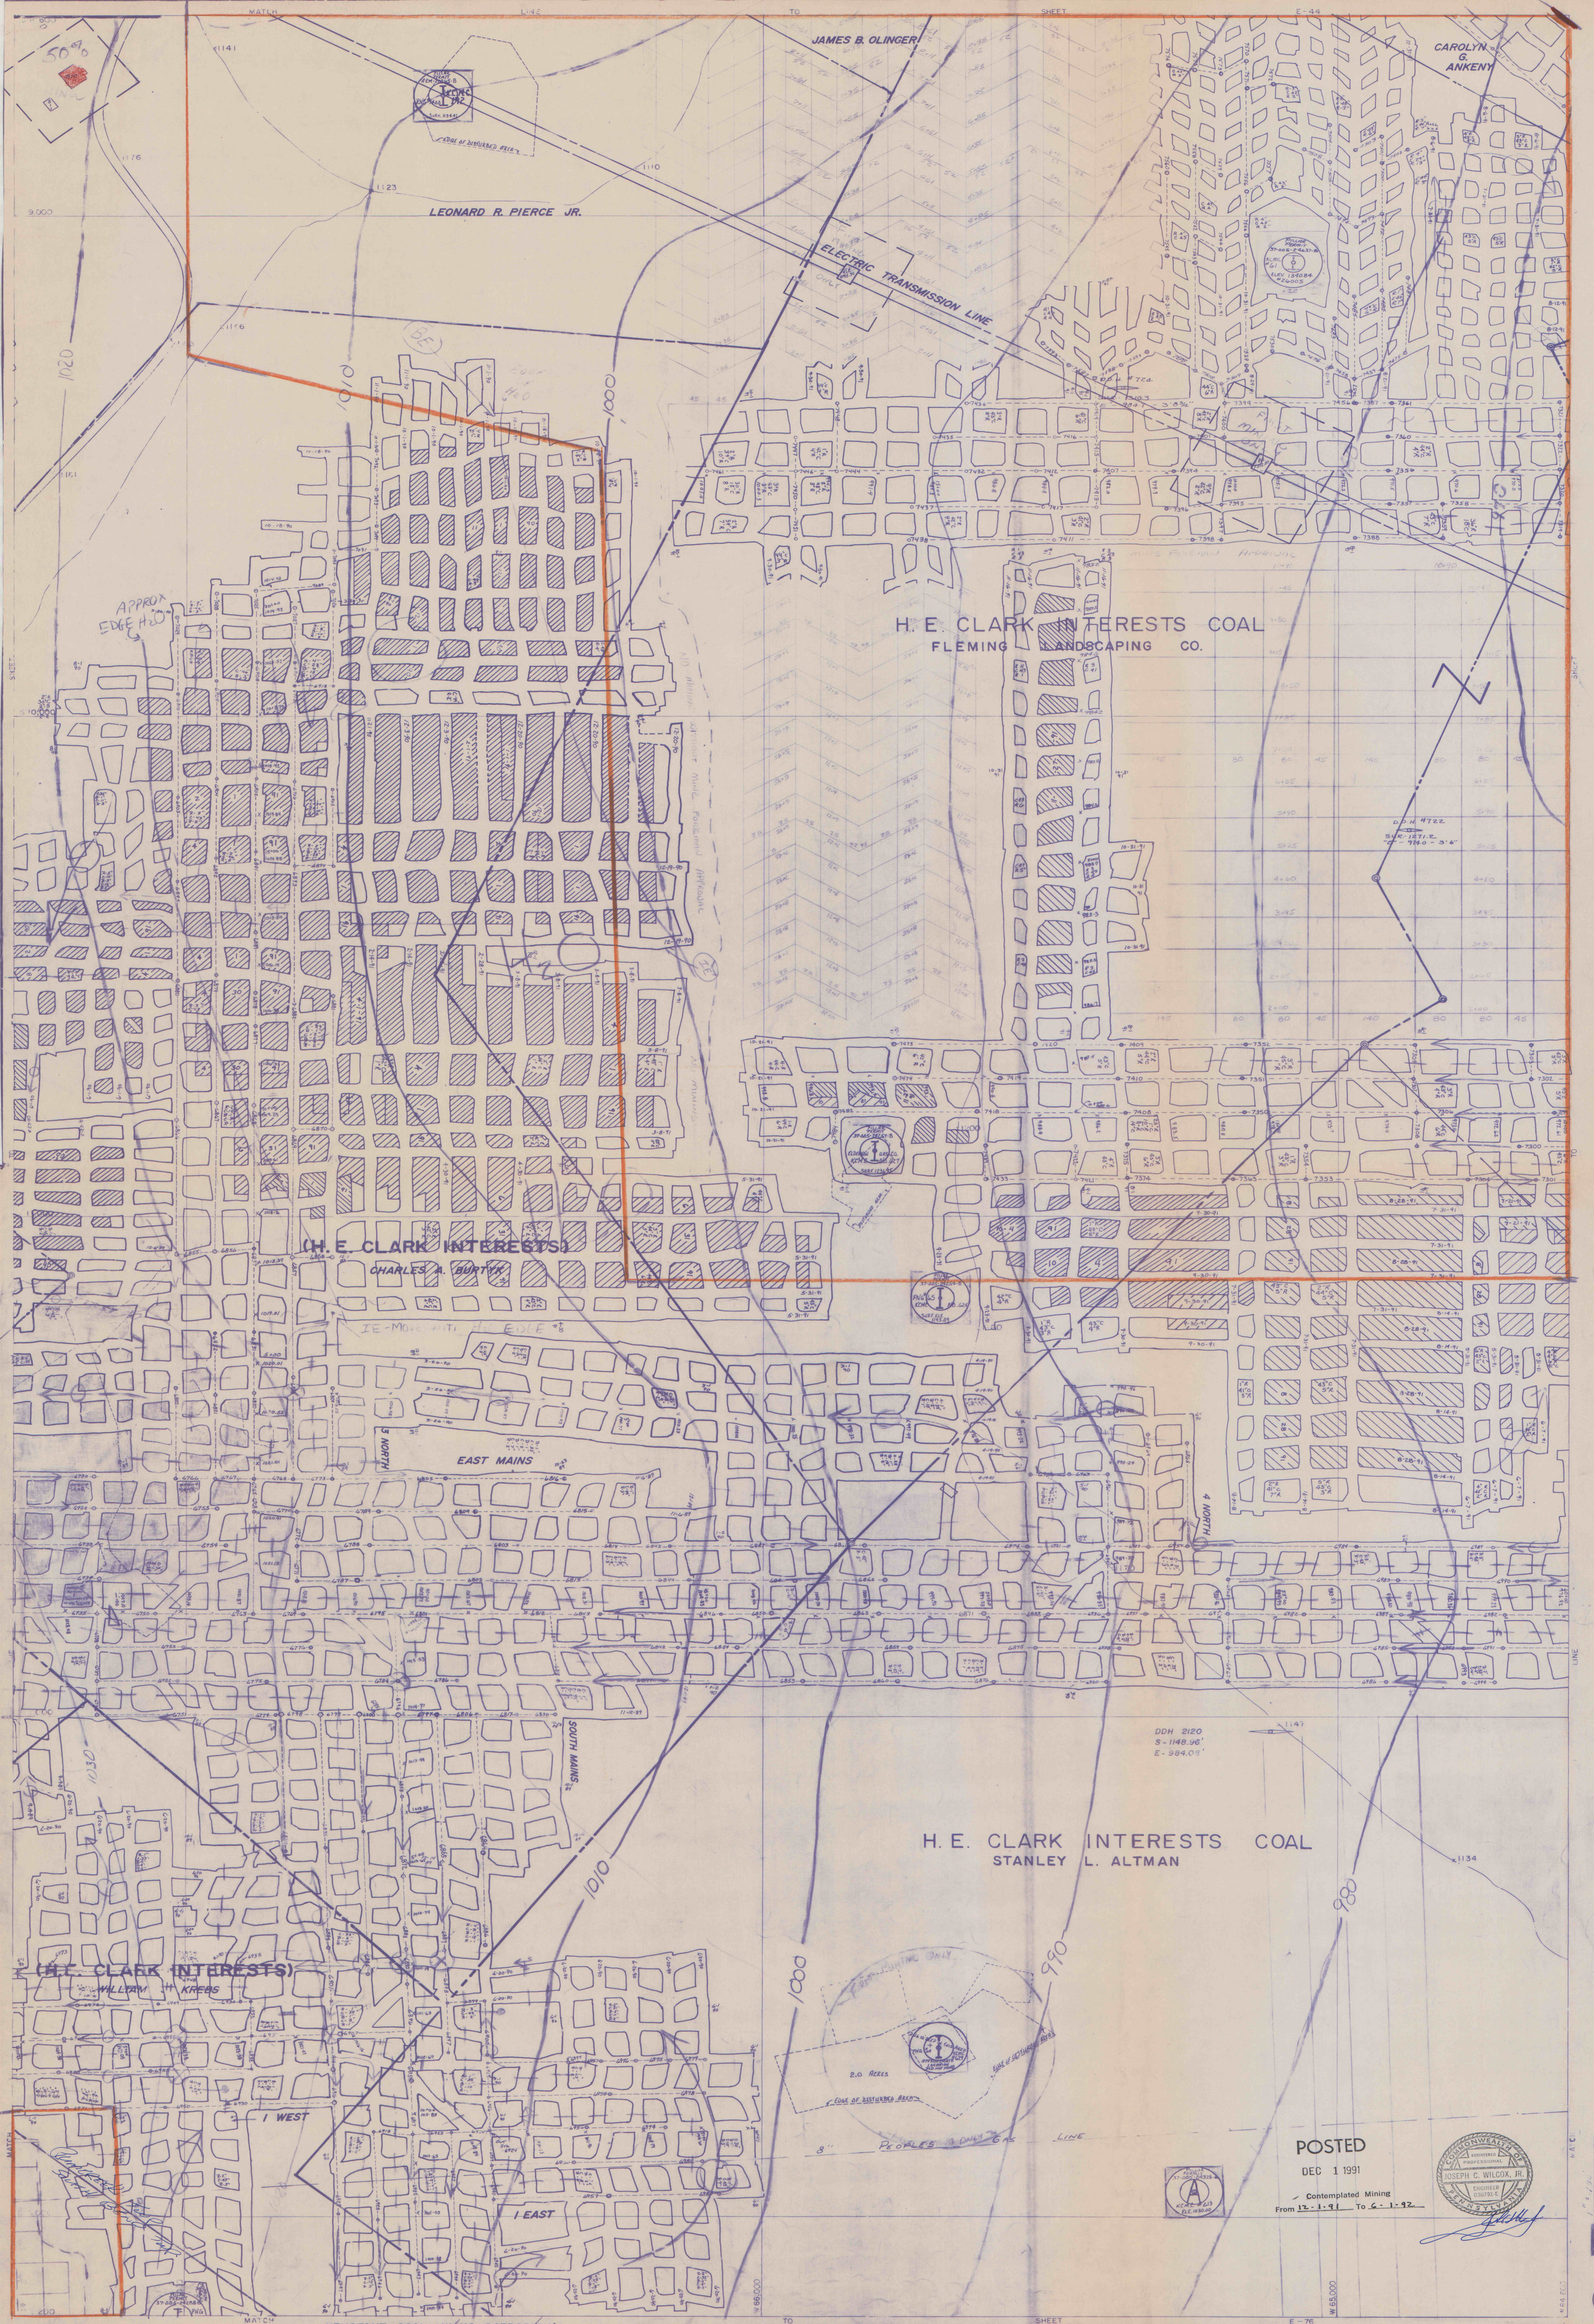

POSTED
DEC 1 1991

Contemplated Mining
From 12-1-91 To 6-1-92

