


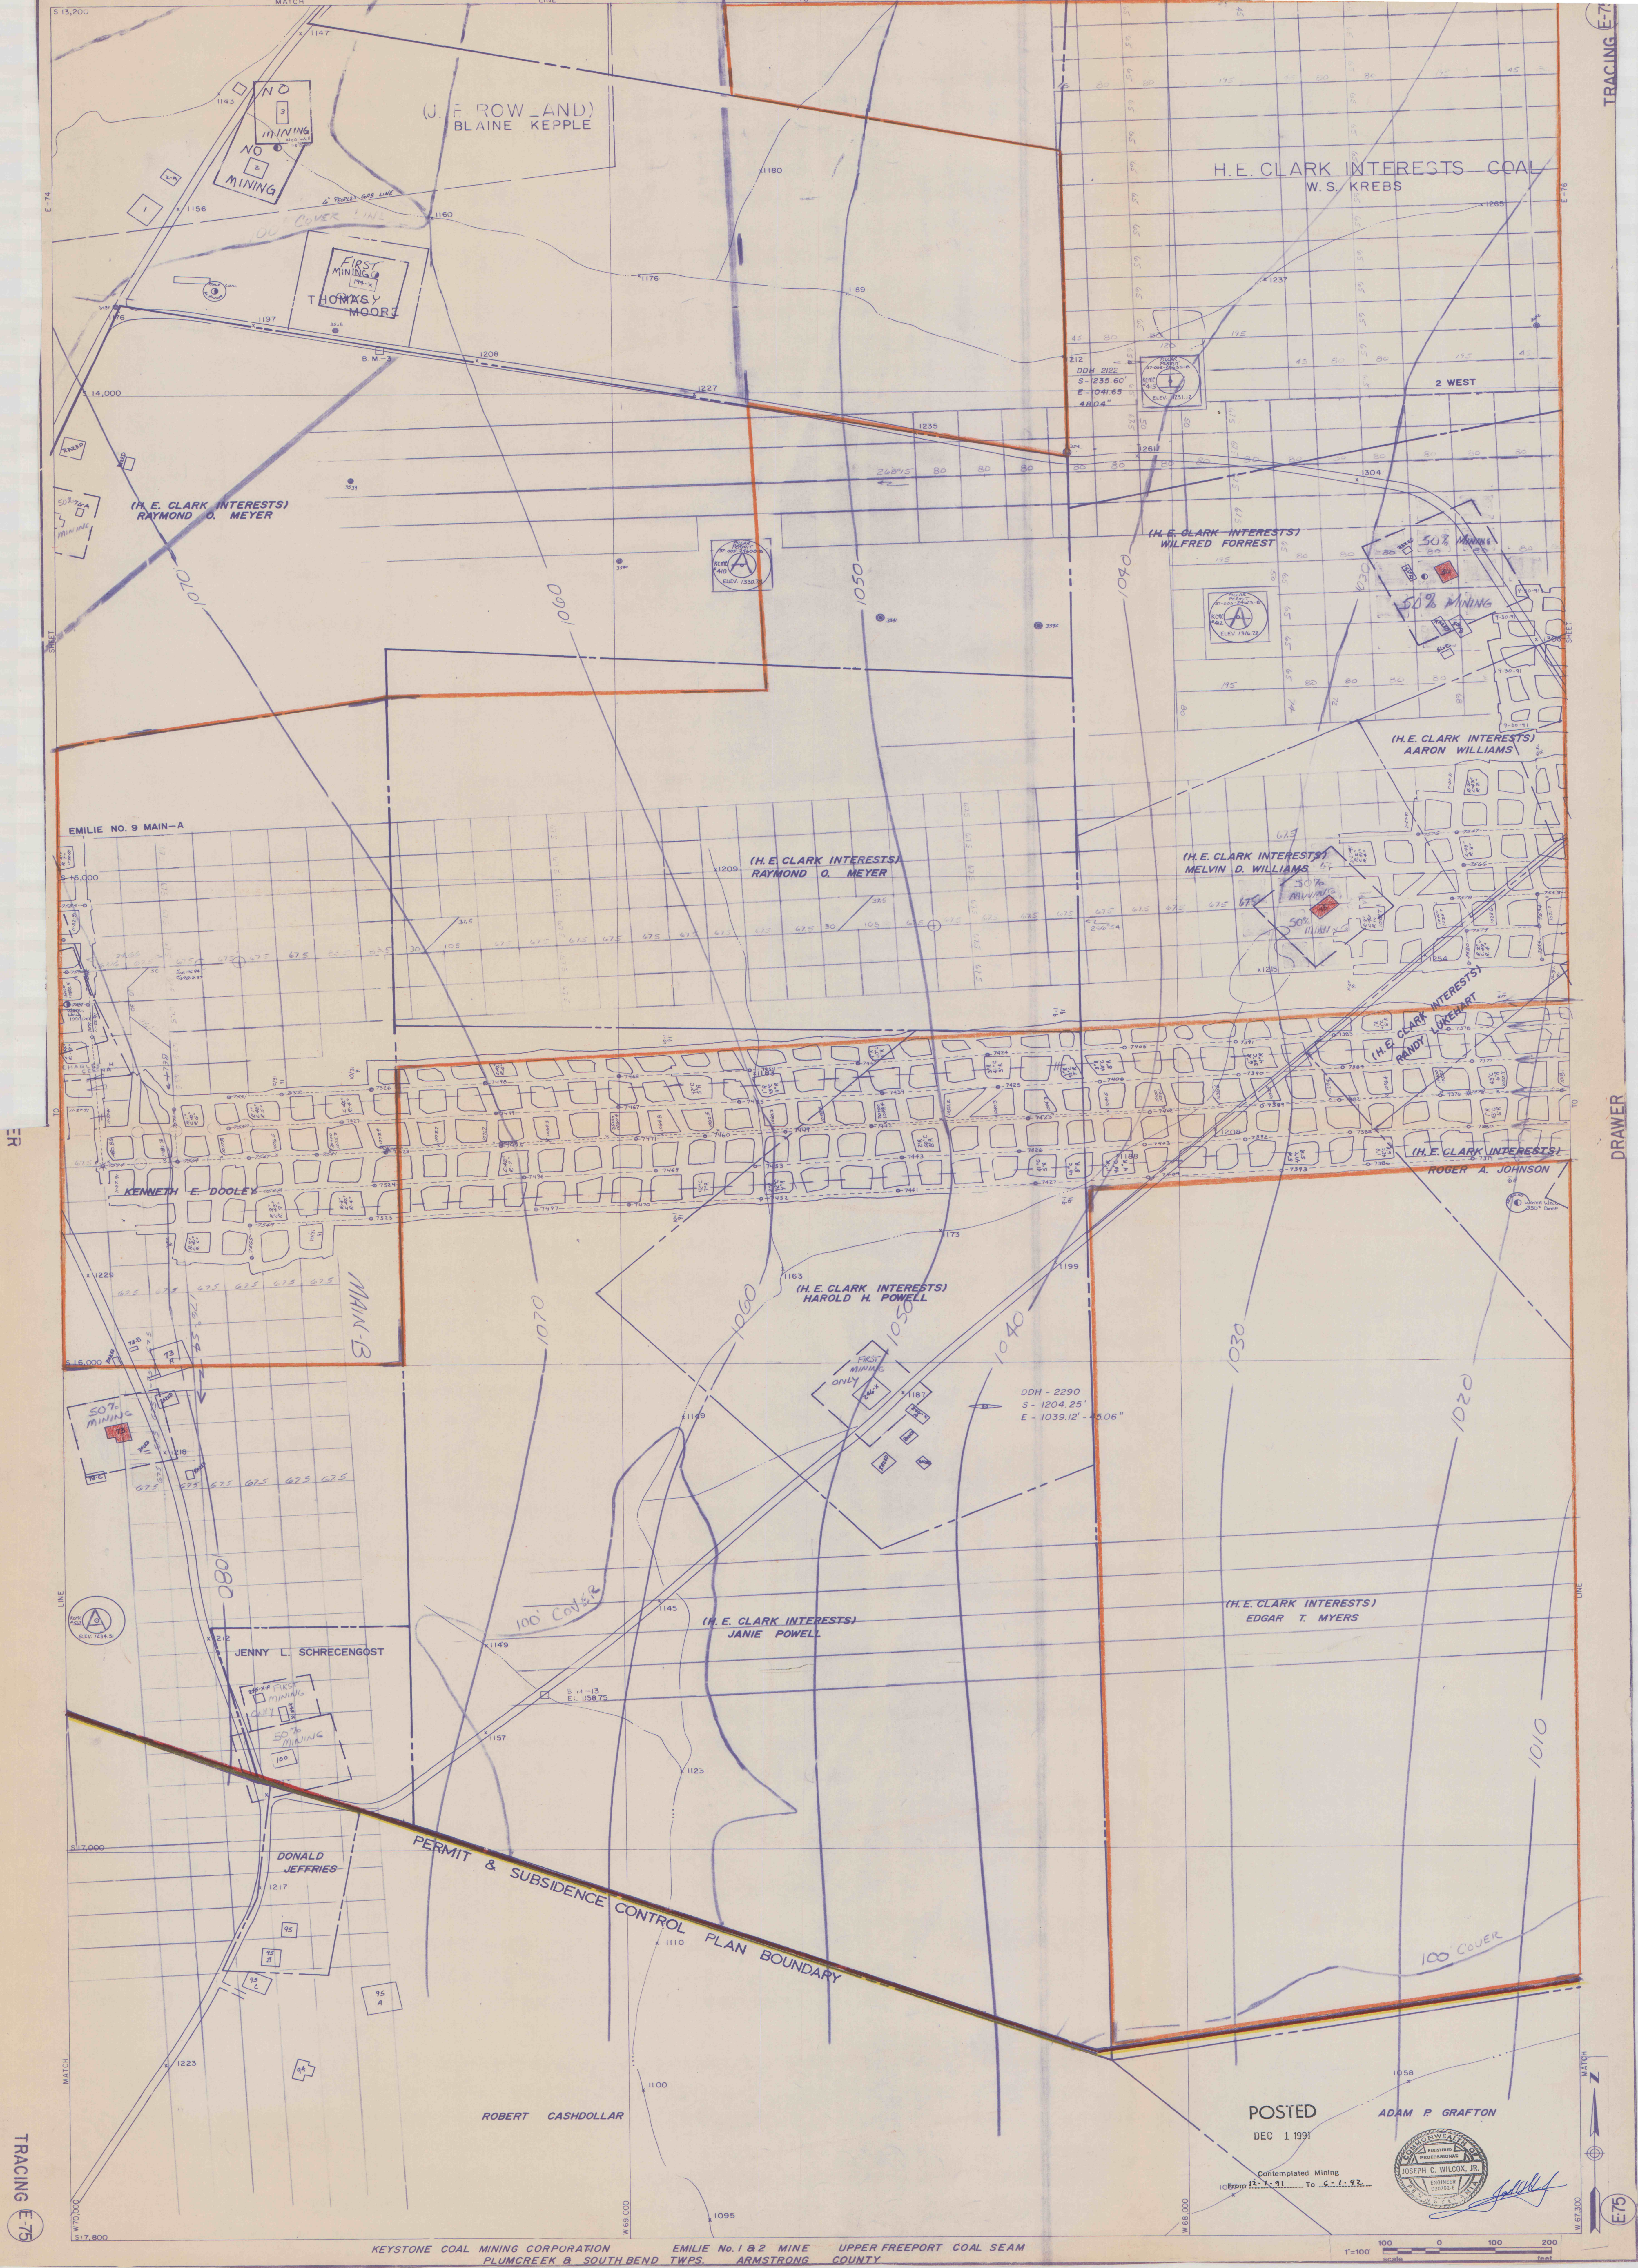


TRACING E-7

DRAWER

TRACING E-75

POSTED
DEC 1 1991

ADAM P. GRAFTON

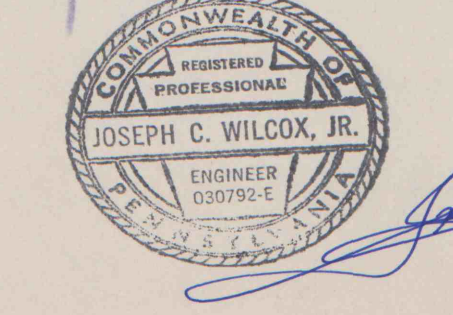

Contemplated Mining
From 12-1-91 To 6-1-92

