



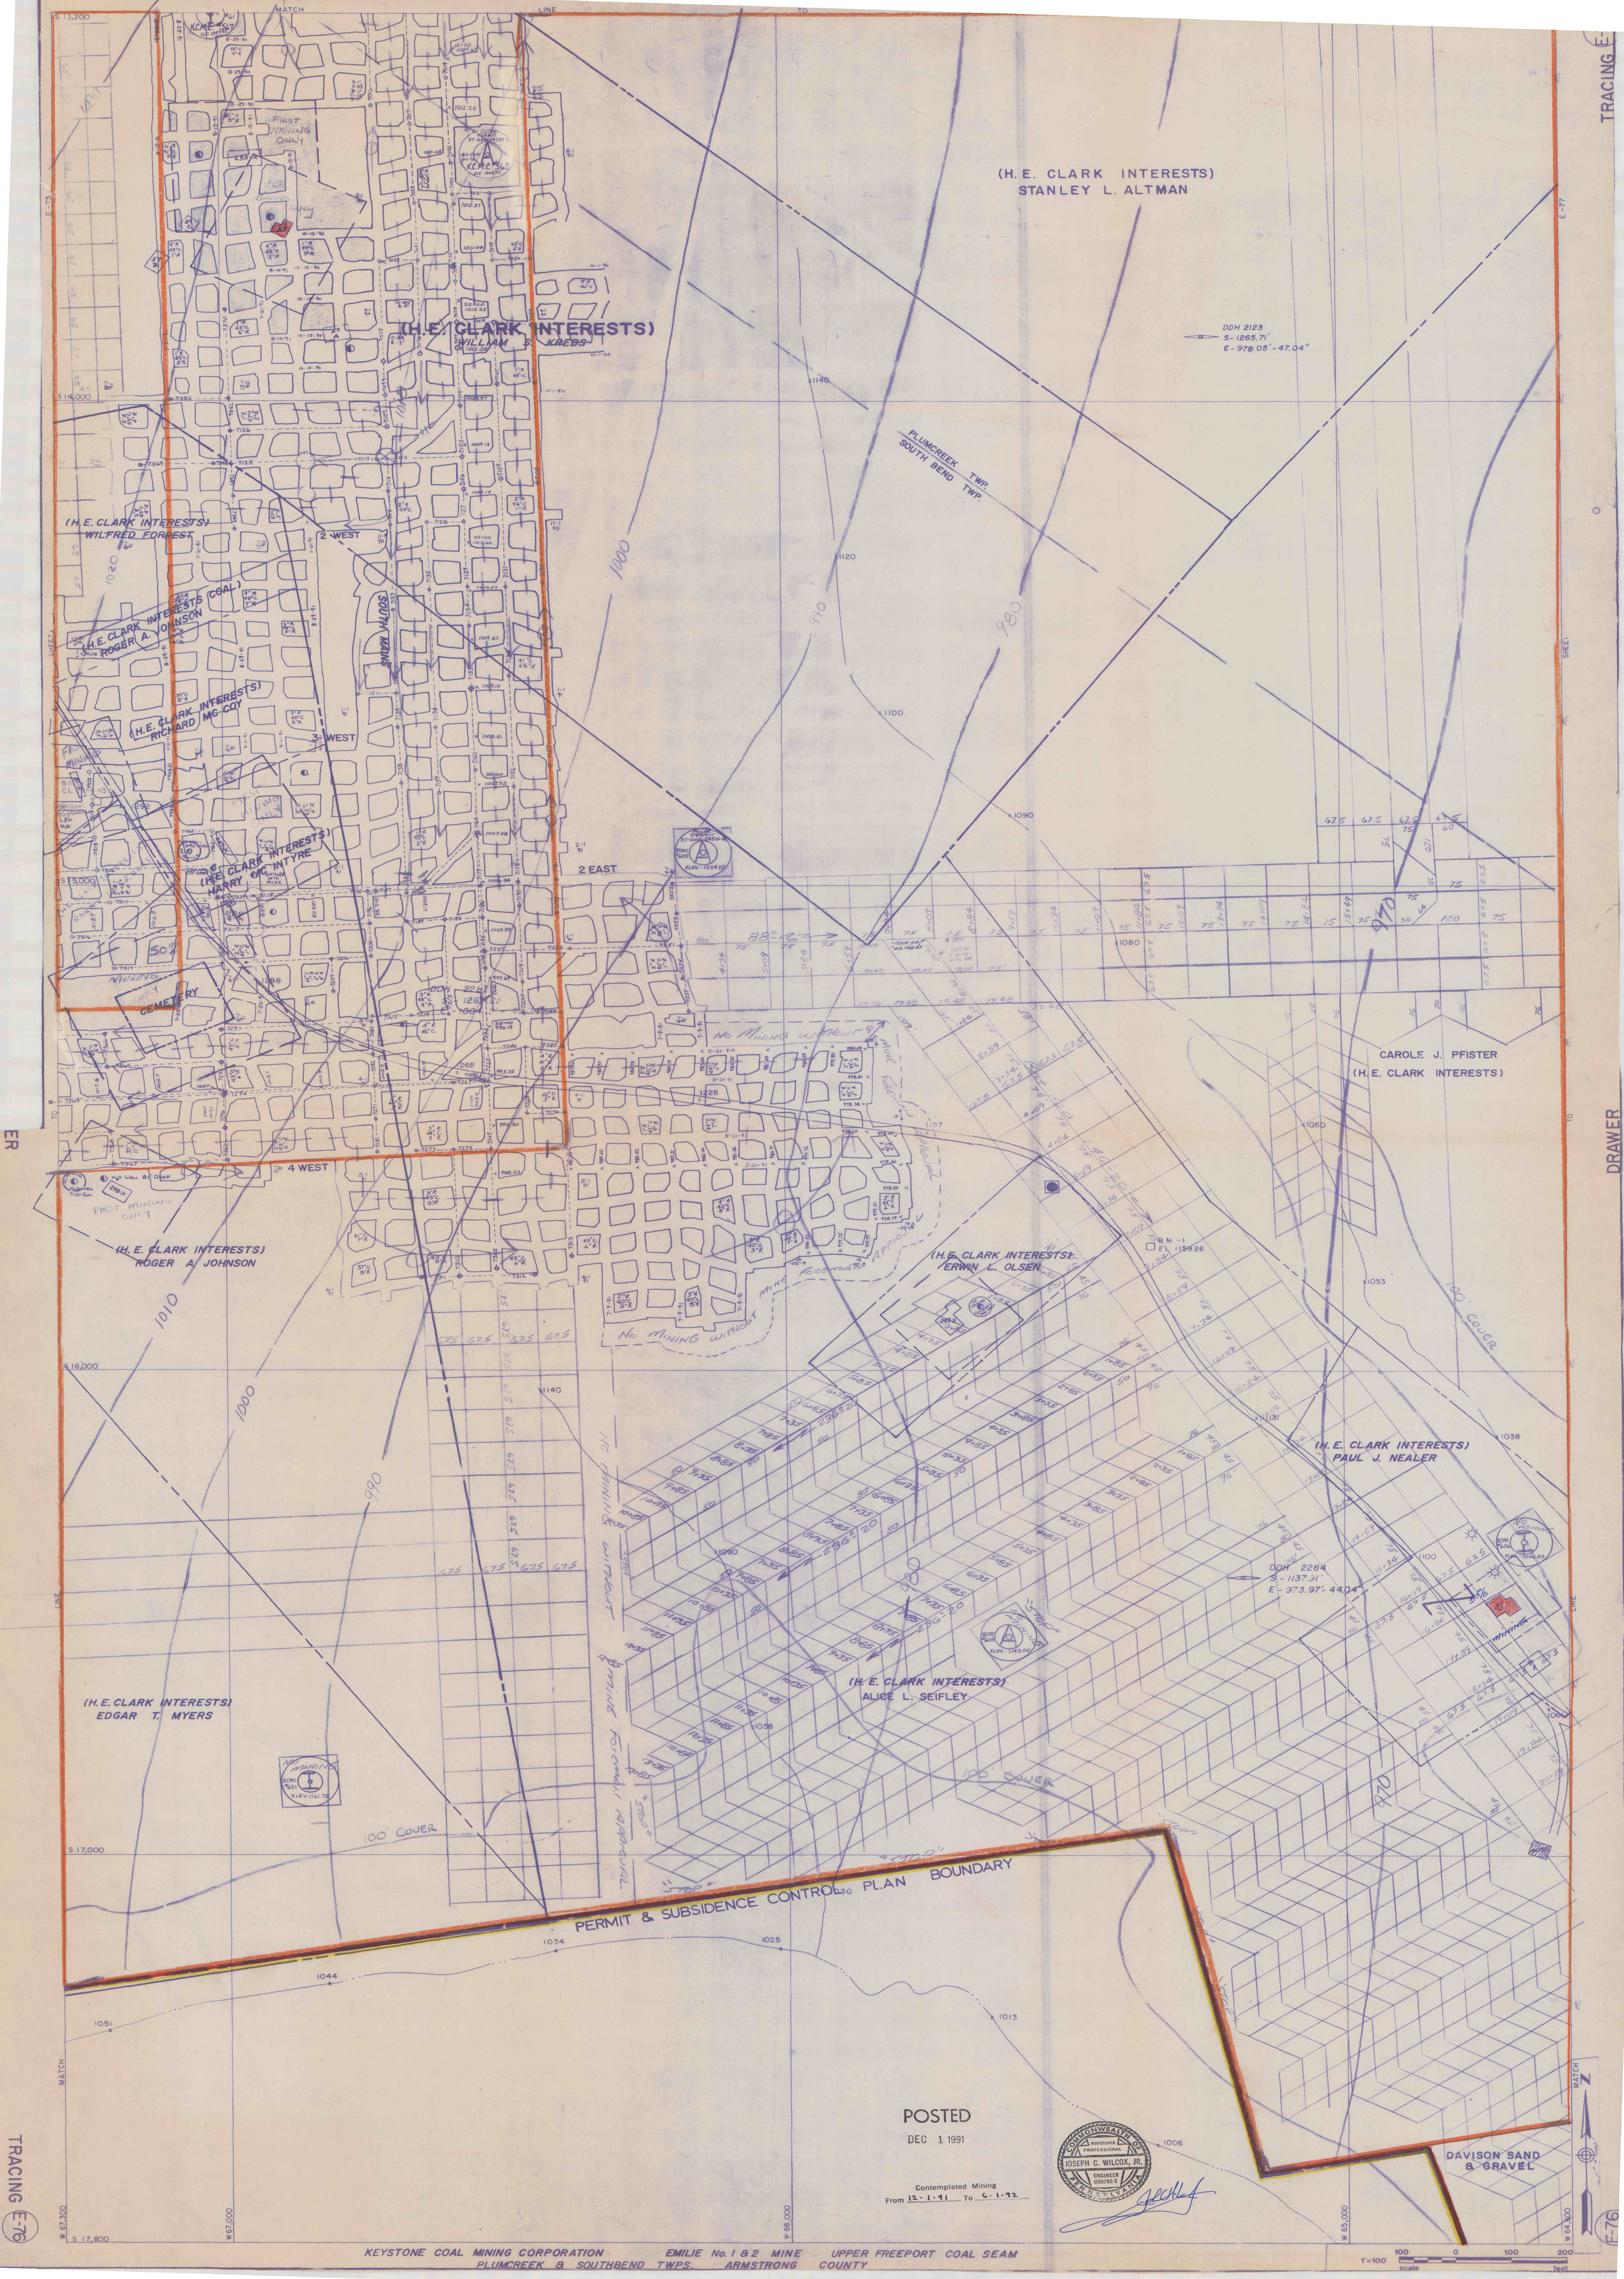

POSTED
DEC 1 1991

Contemplated Mining
From 12-1-91 To 6-1-92

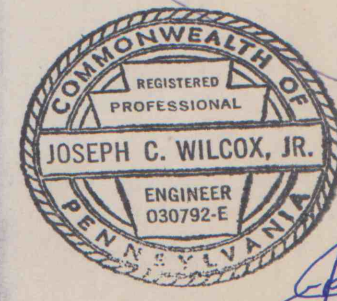

DAVISON SAND
& GRAVEL

KEYSTONE COAL MINING CORPORATION EMILIE No. 1 & 2 MINE UPPER FREEPORT COAL SEAM
PLUMCREEK & SOUTHBEND TWPS. ARMSTRONG COUNTY