


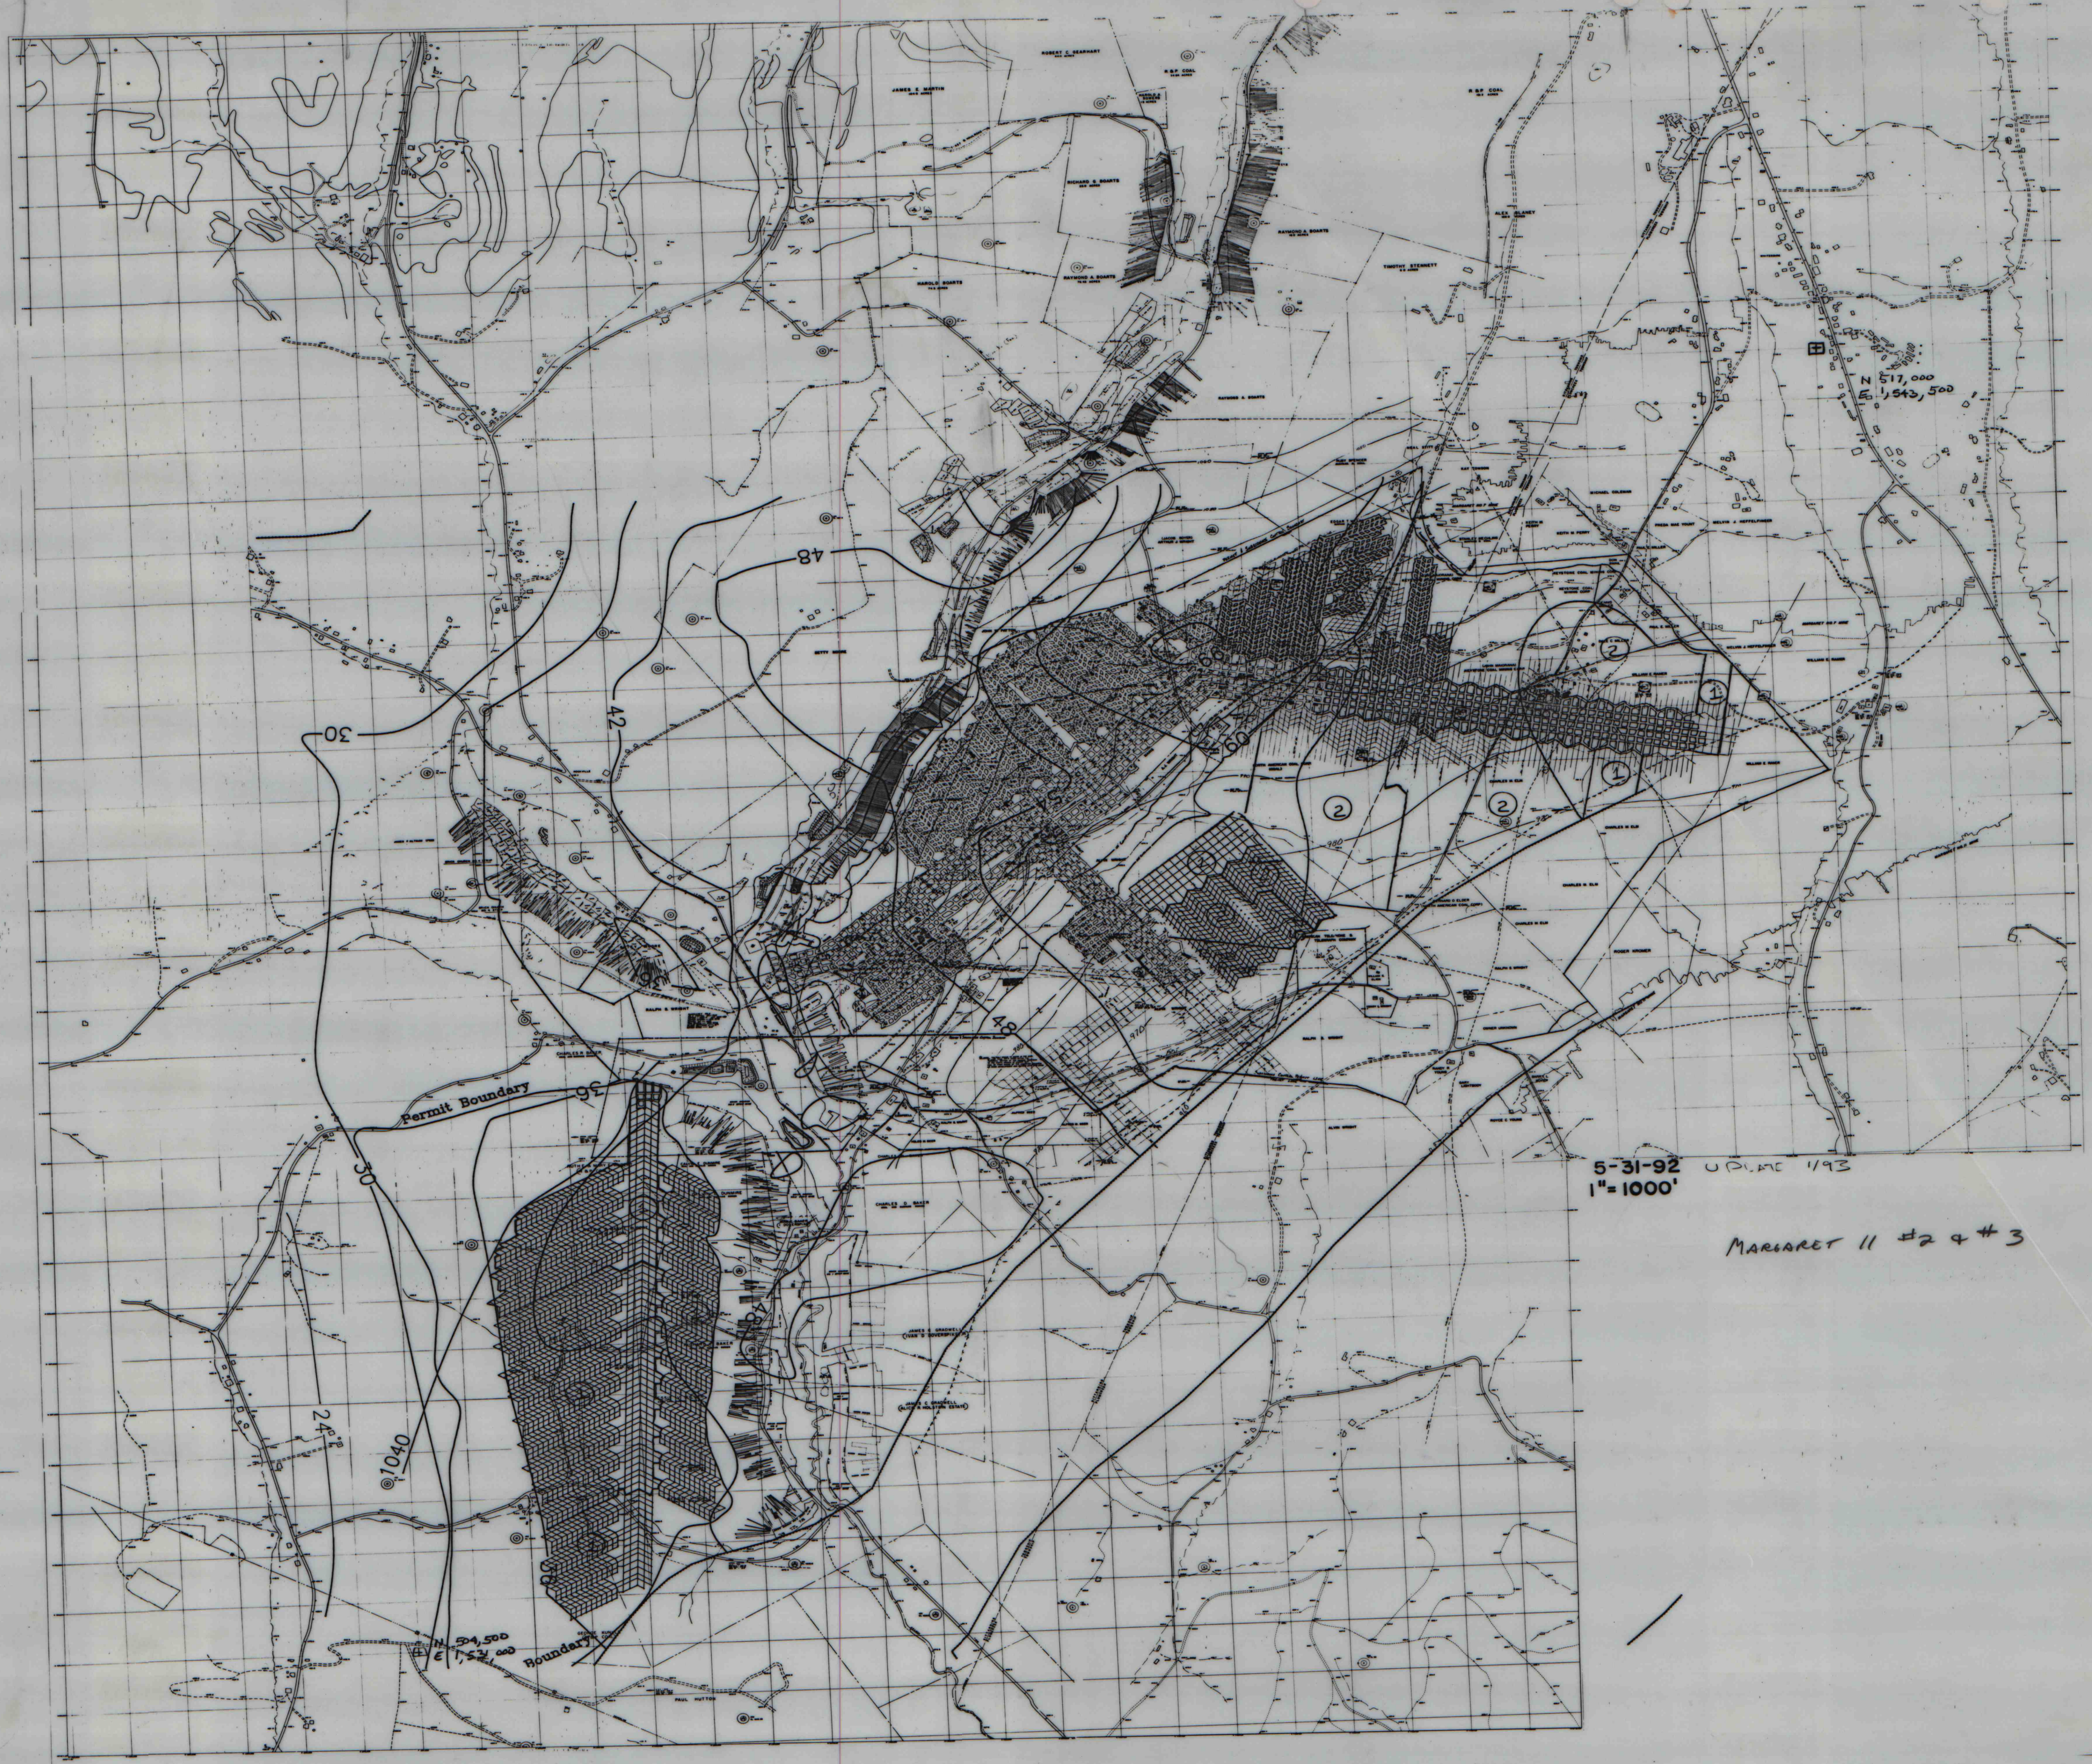

5-31-92 U.D.M.C. 1/93
1" = 1000'

MARGARET II #2 & #3