
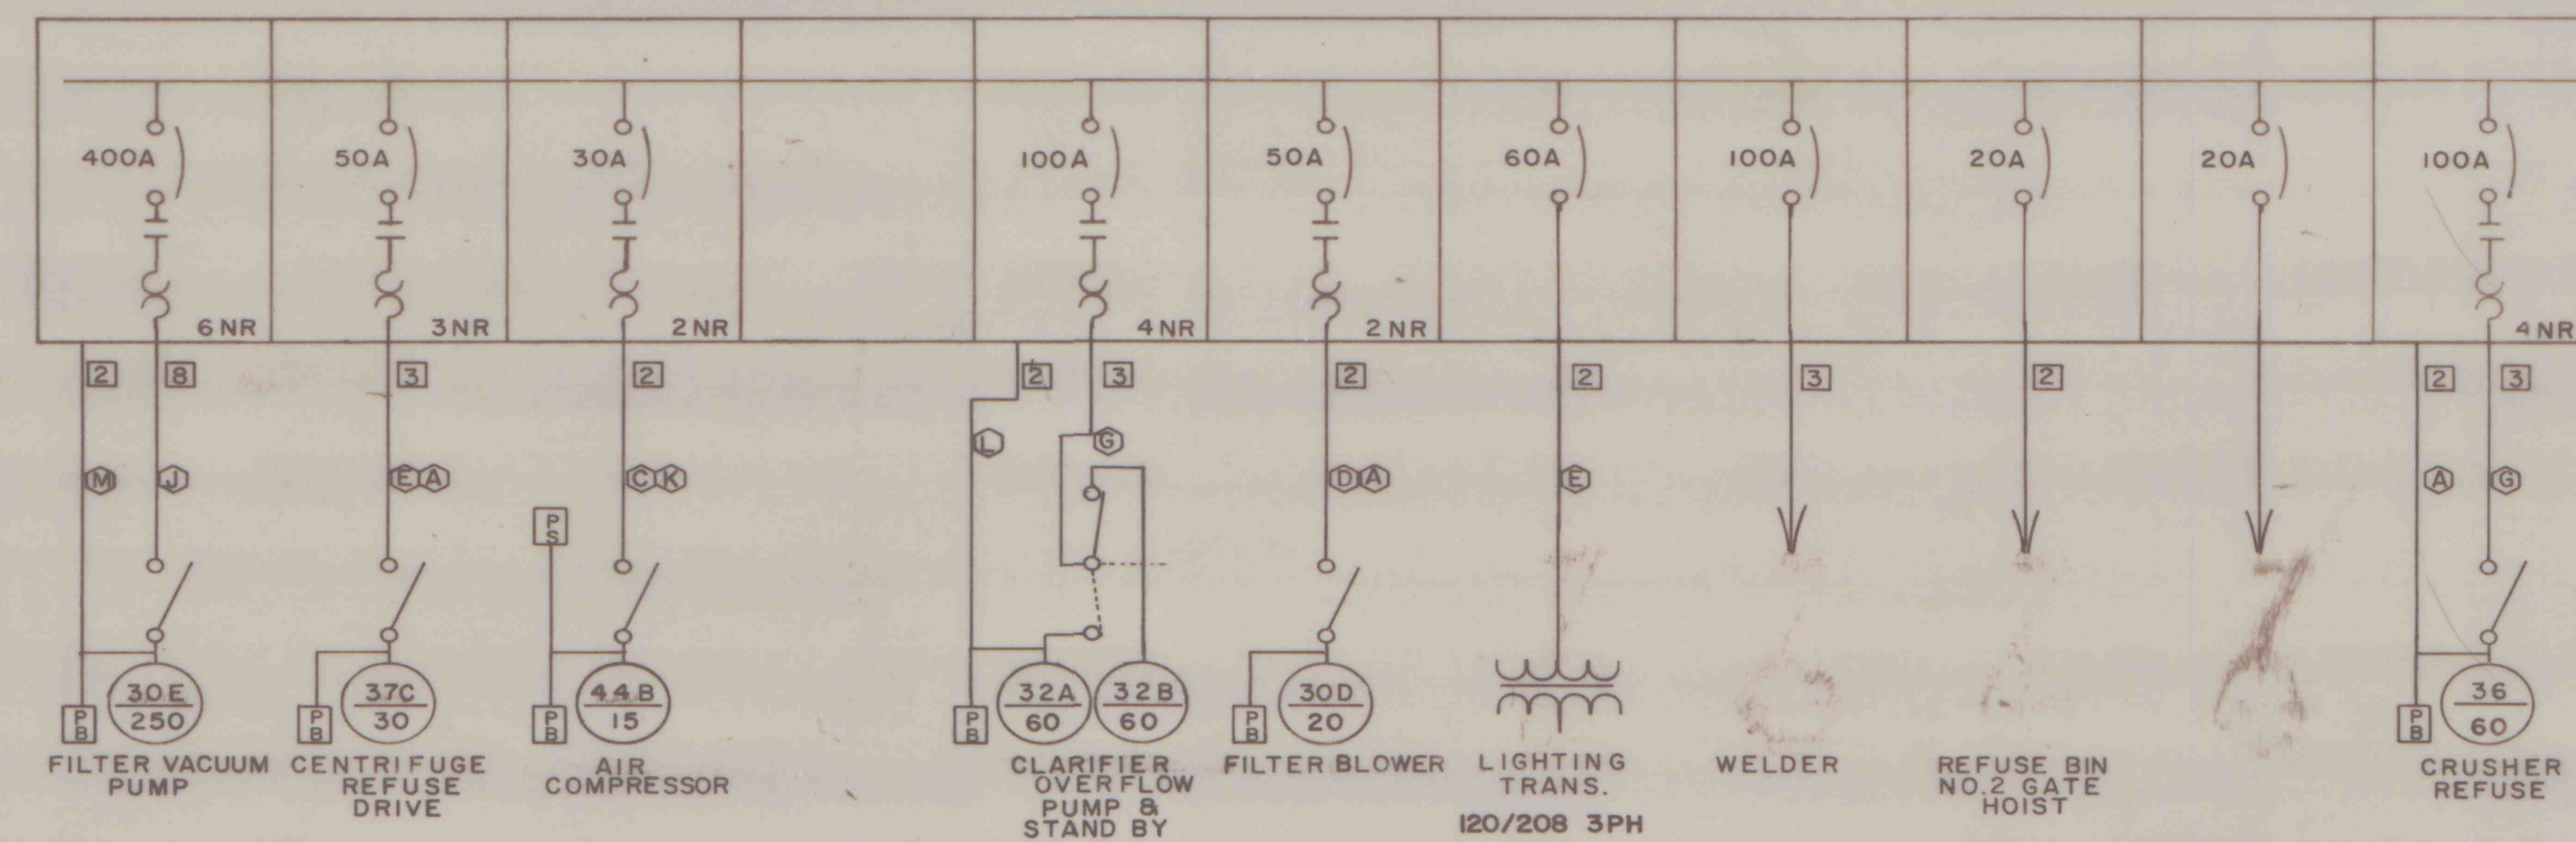


MCC NO. P2

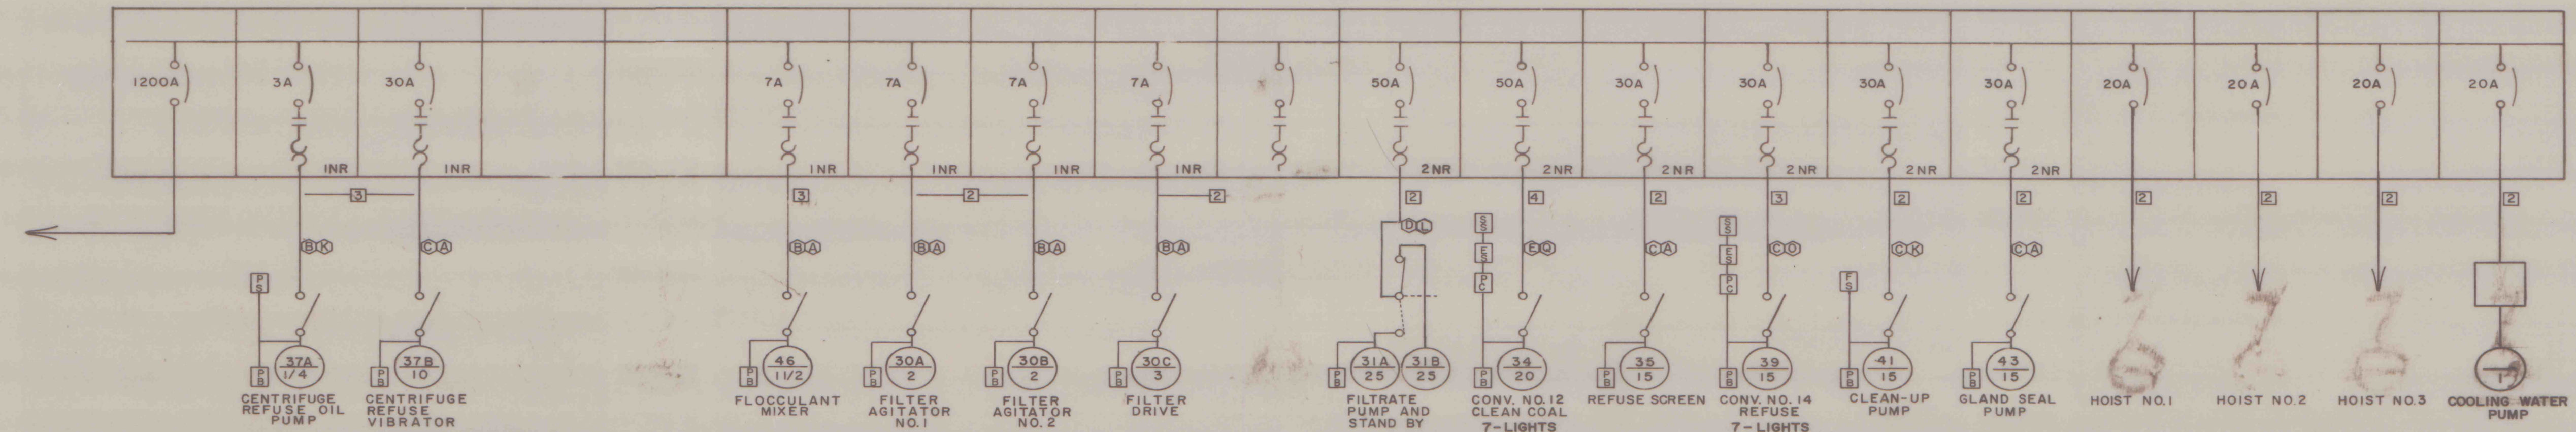

WIRE & CONDUIT SCHEDULE

A-3 NO. 14	2- 3/4"
B-3 NO. 12	3- 1"
C-3 NO. 10	4- 1 1/4"
D-3 NO. 8	5- 1 1/2"
E-3 NO. 6	6- 2"
F-3 NO. 4	7- 2 1/2"
G-3 NO. 2	8- 3"
H-3 NO. 2/0	
I-3 NO. 350	
J-3 NO. 500	
K-4 NO. 14	
L-5 NO. 14	
M-6 NO. 14	
N-7 NO. 14	
O-8 NO. 14	
P-6 NO. 12	
Q-9 NO. 12	

REVISION		1	5/13/83	LJM
FOR APPROVAL		2	5/4/82	JK
DWG. NO.	REFERENCE	NO.	DATE	BY
BLAIRELECTRIC SERVICE CO. BELLWOOD, PENNSYLVANIA R&P COAL CO.-KEYSTONE PLANT MCC P2 ONE-LINE				
DRAWN JK	DATE 3/2/82	ORDER NO. W 7478		
CHECKED	DATE	SCALE		
APPROVED	DATE	DWG. NO. E-3		