



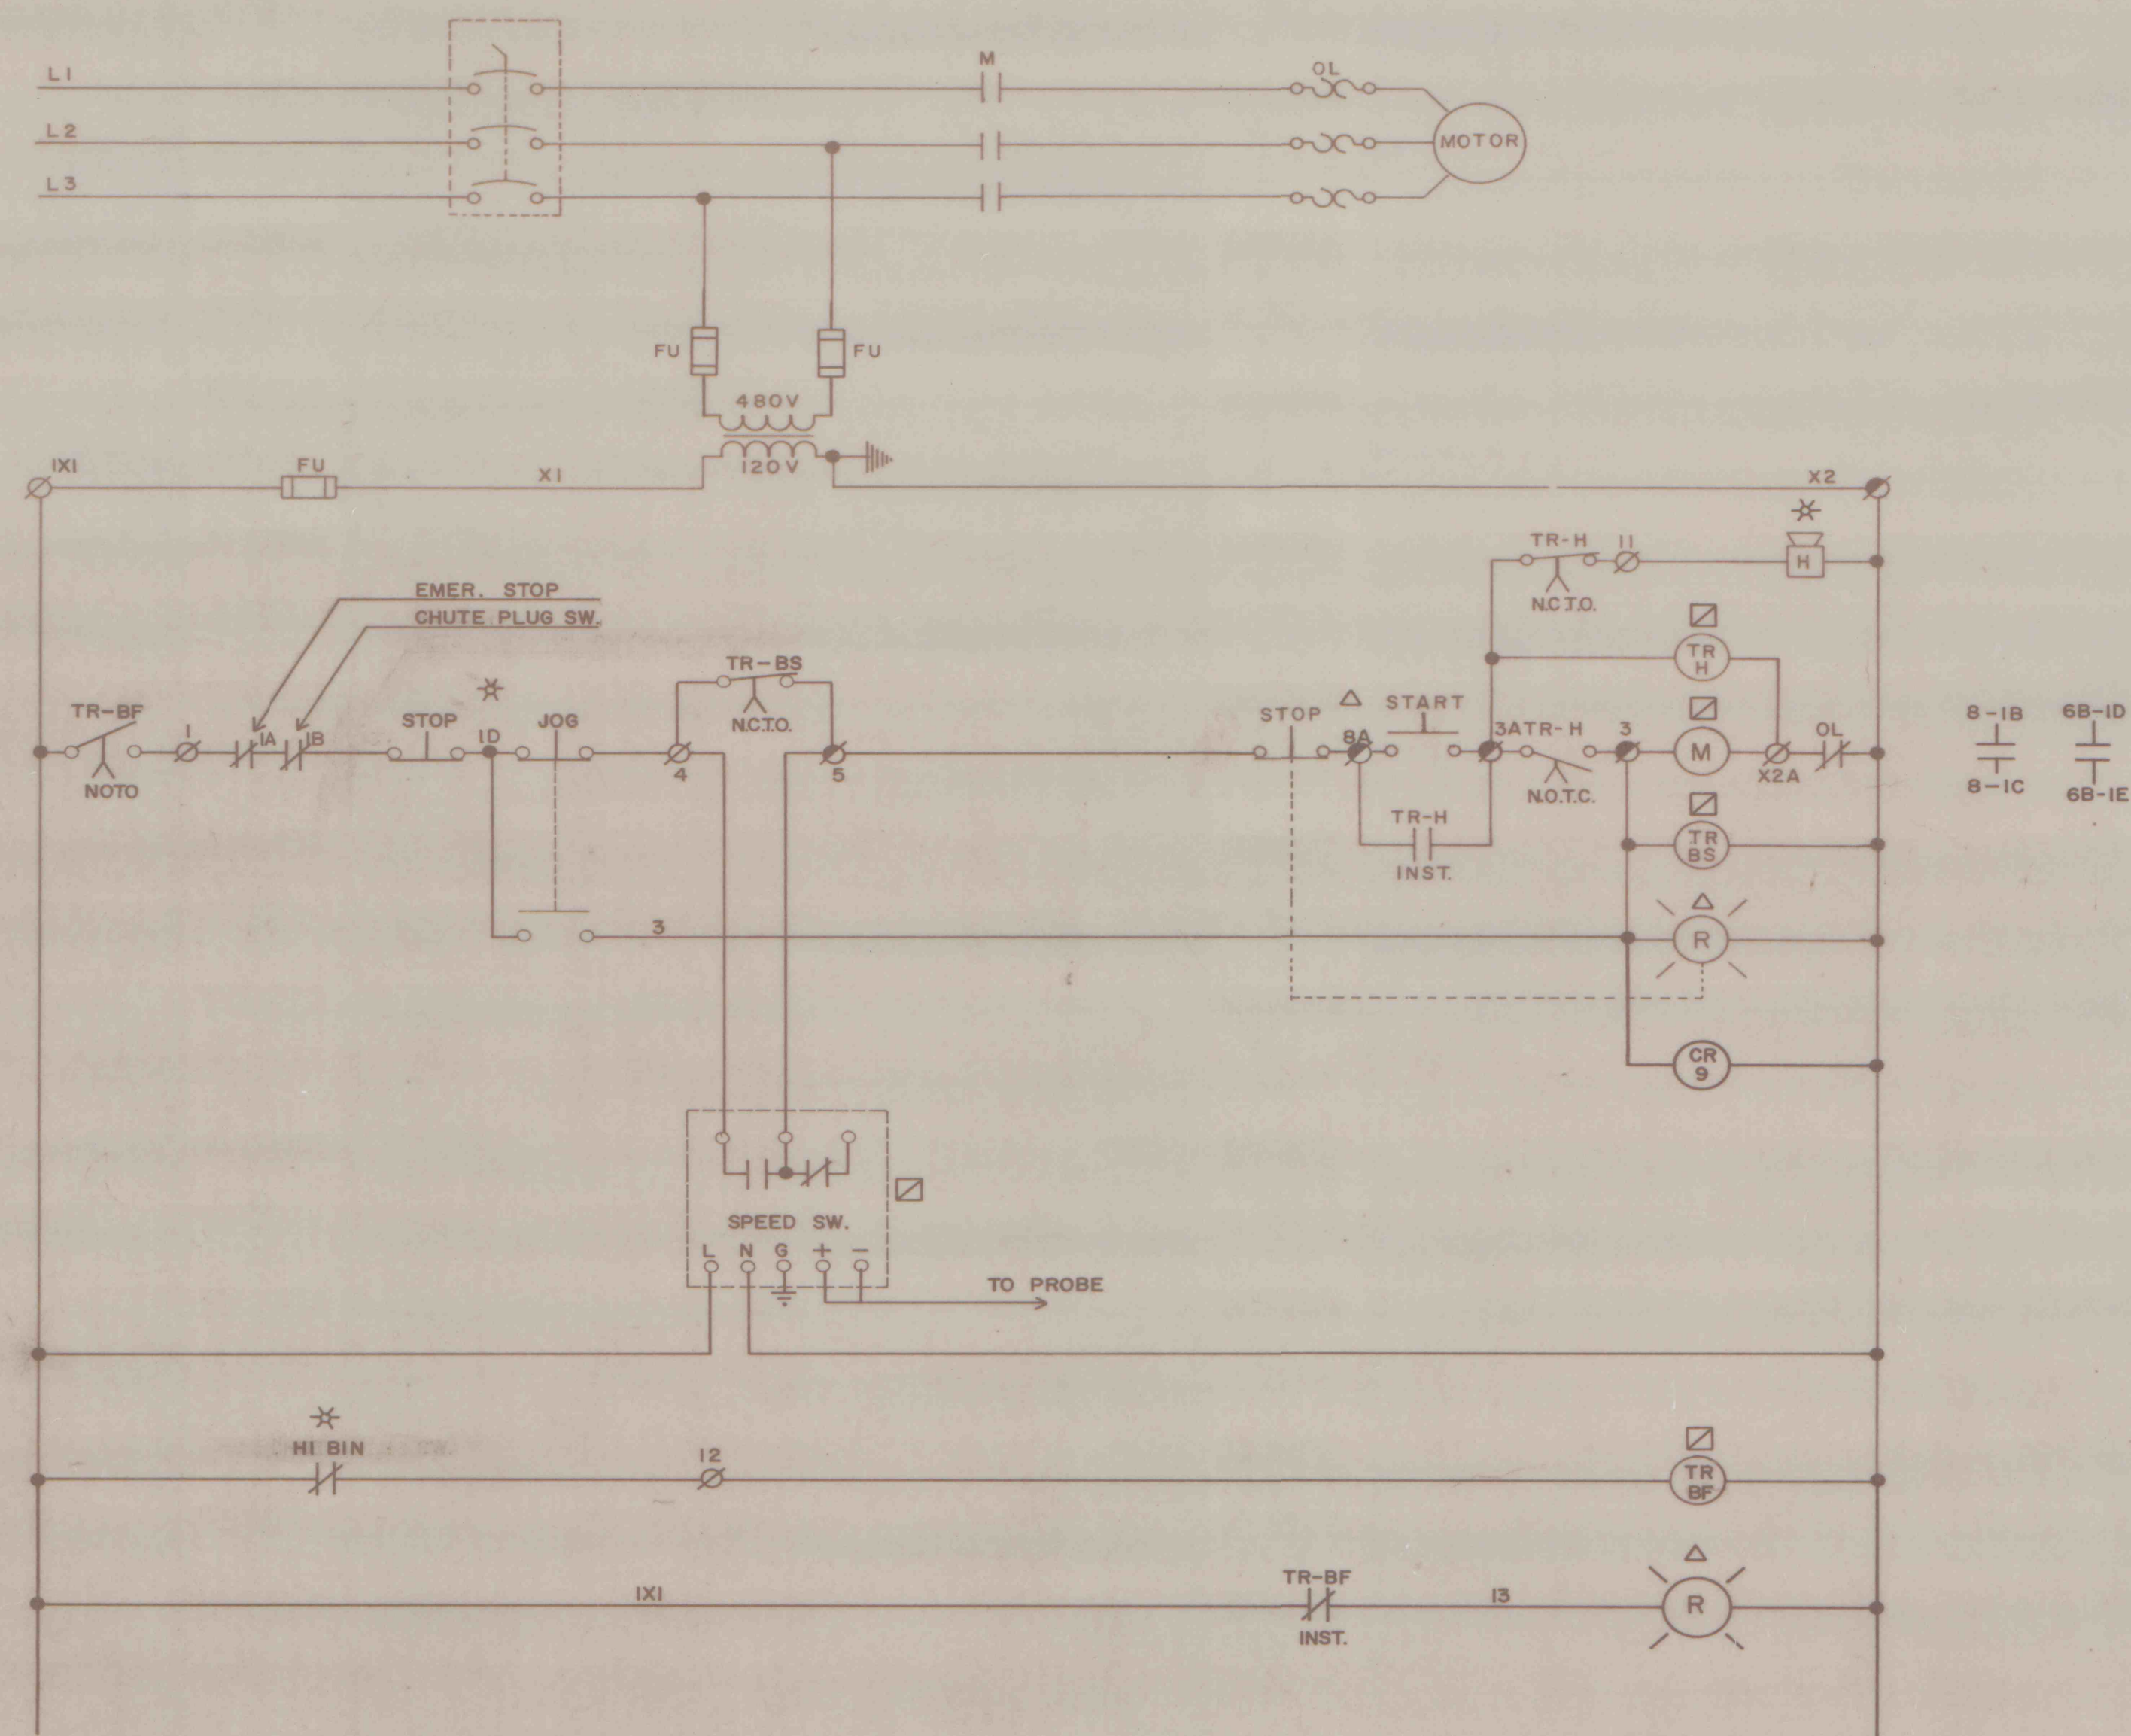

UNIT	DESCRIPTION	HP	MCC
9	REFUSE CONVEYOR NO. 2	10	SH-1

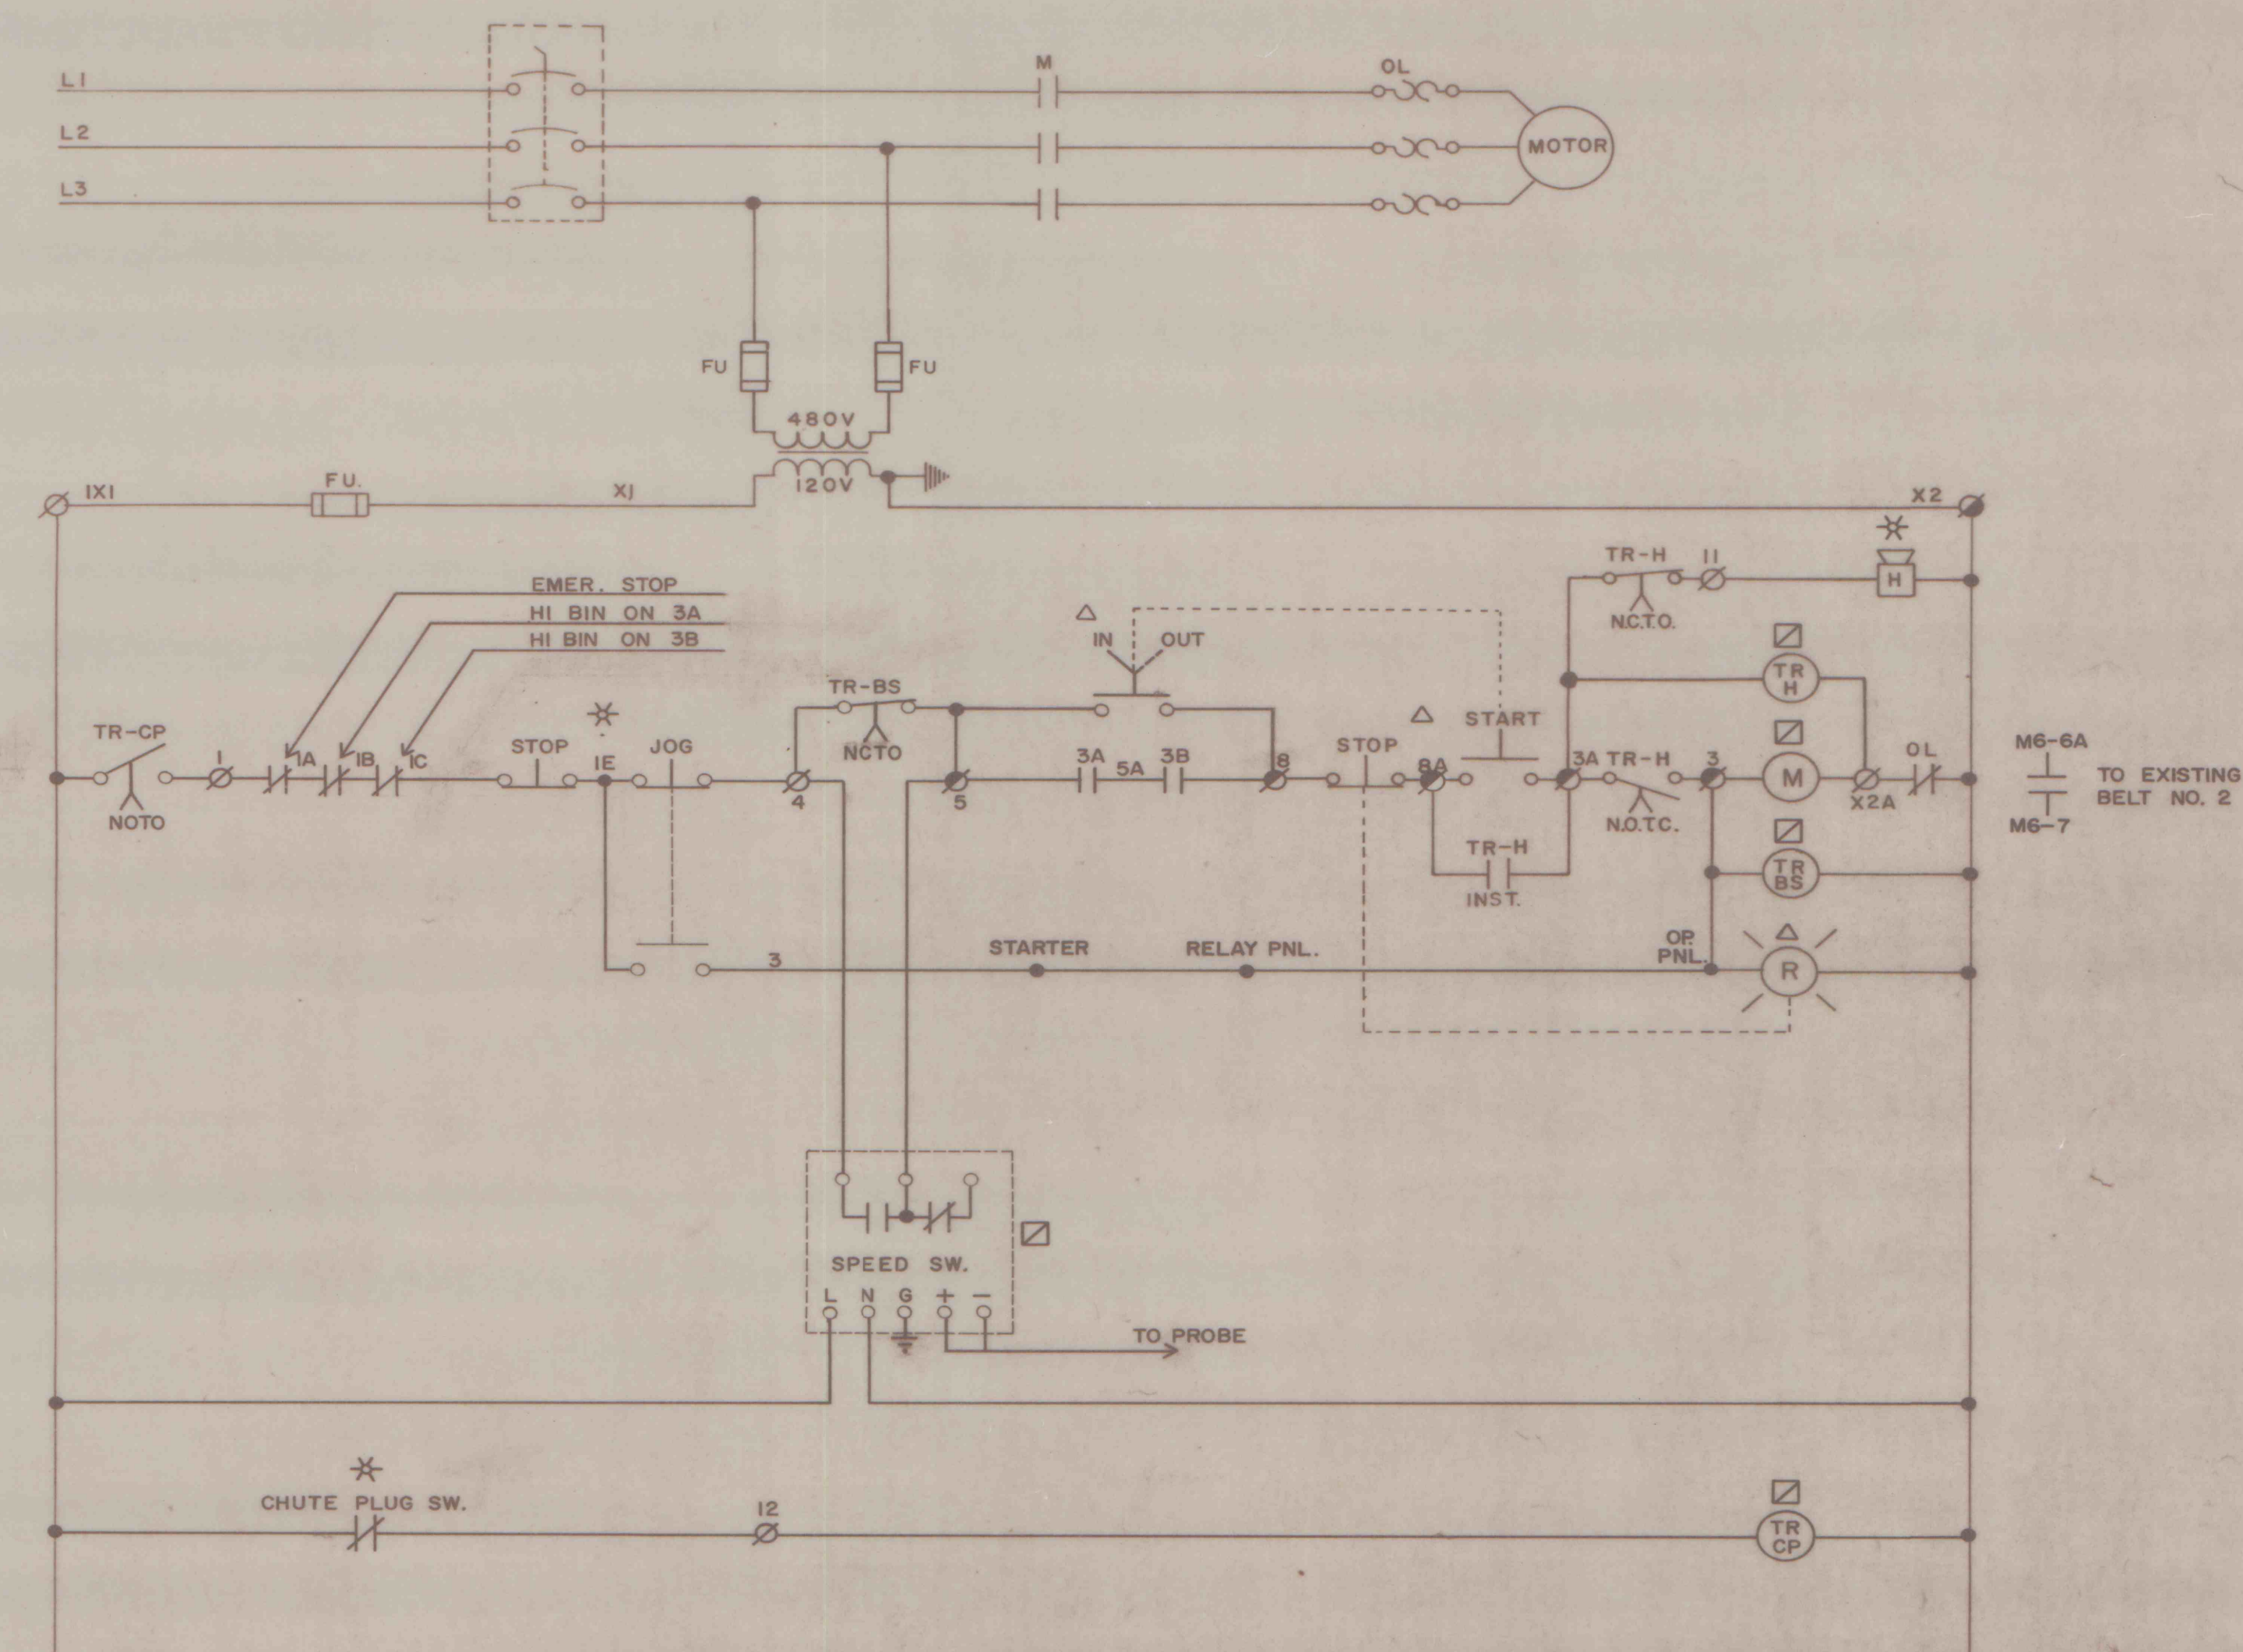

UNIT	DESCRIPTION	HP	MCC
2	RAW COAL CONVEYOR NO. 1	75	SH-1

E-13	REVISION AS PER FIELD CHANGES	3	7-14-83	LDM
E-13	DELETE INTERLOCK IN DISC. SW.	1	7-15-82	LDM
E-13	REVISION	2	5/19/83	LDM
E-13	FOR APPROVAL	0	5-13-82	LDM
DWG. NO.	REFERENCE	NO.	DATE	BY
BLAIR ELECTRIC SERVICE CO.				
BELLWOOD, PENNSYLVANIA				
R & P COAL CO. - KEYSTONE PLANT				
SCHEMATIC DIAGRAMS				
DRAWN JK	DATE	CHECKED	DATE	SCALE
APPROVED	DATE	DWG. NO. - E-13		