




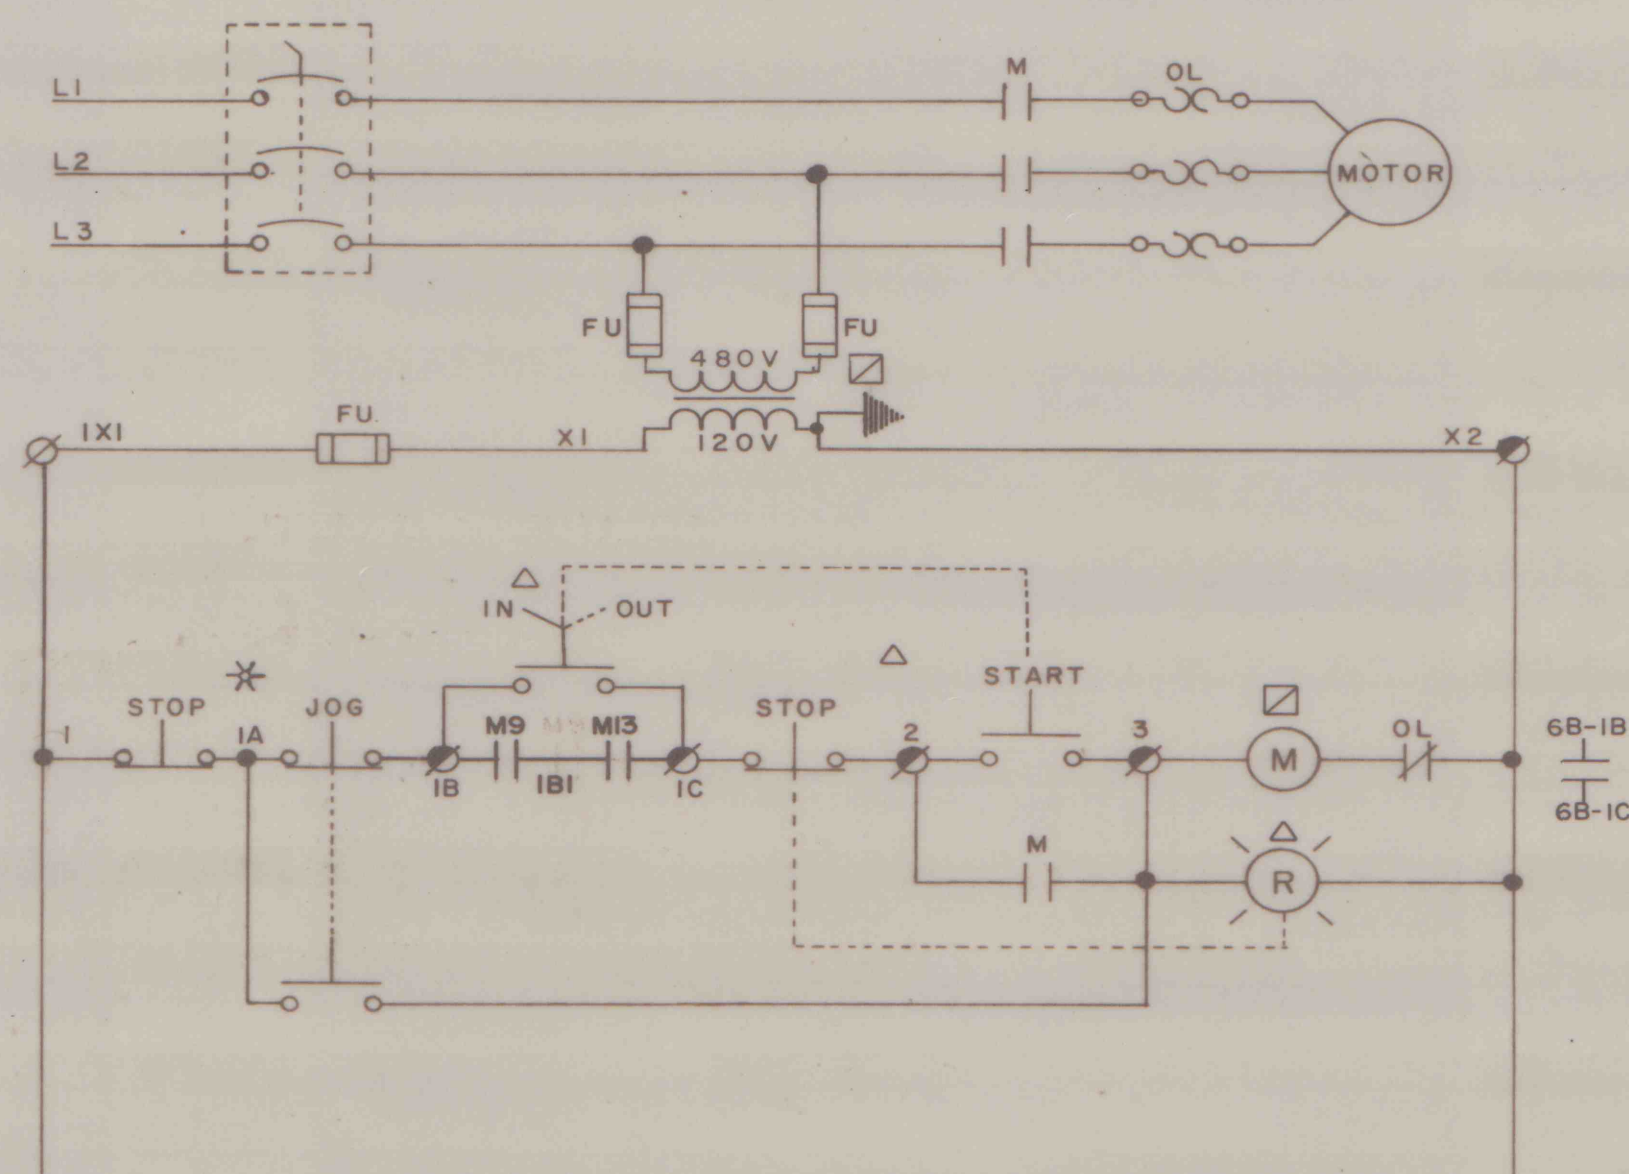


UNIT	DESCRIPTION	HP	MCC
8	REFUSE SCREEN 1"XO	3	SH-1

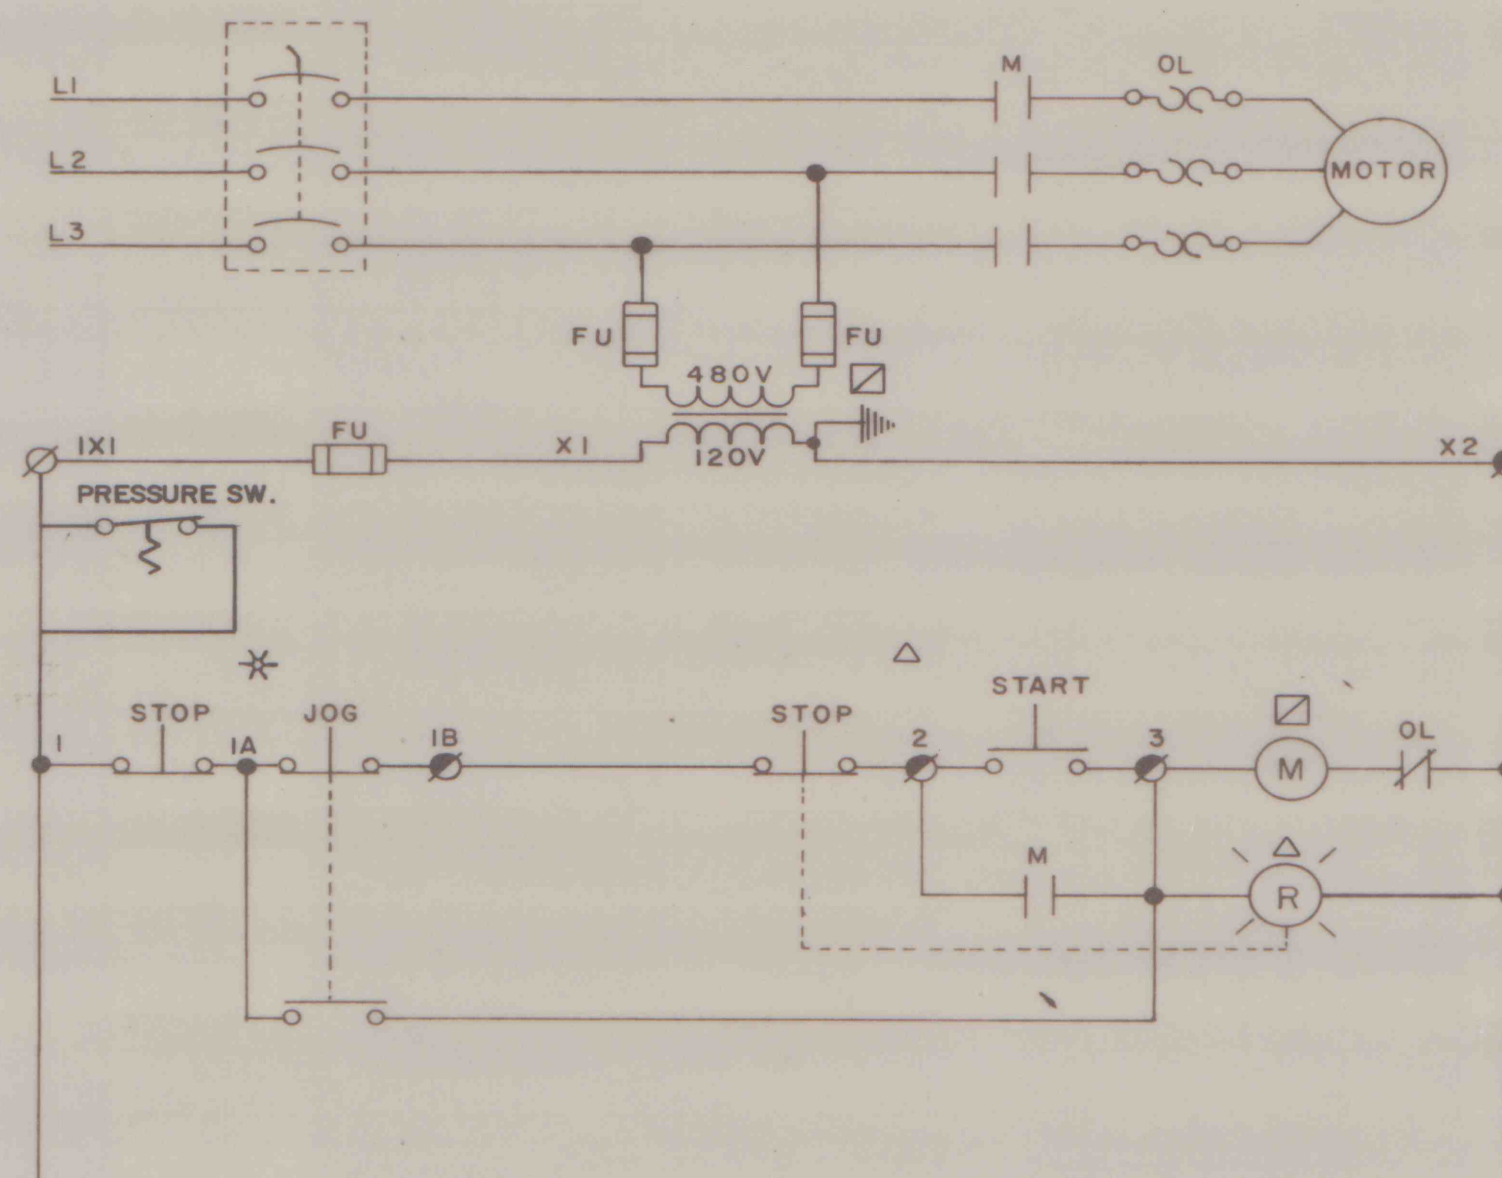


UNIT	DESCRIPTION	HP	MCC
15C	DUST COLLECTOR BLOWER EXHAUST	100	SH-1

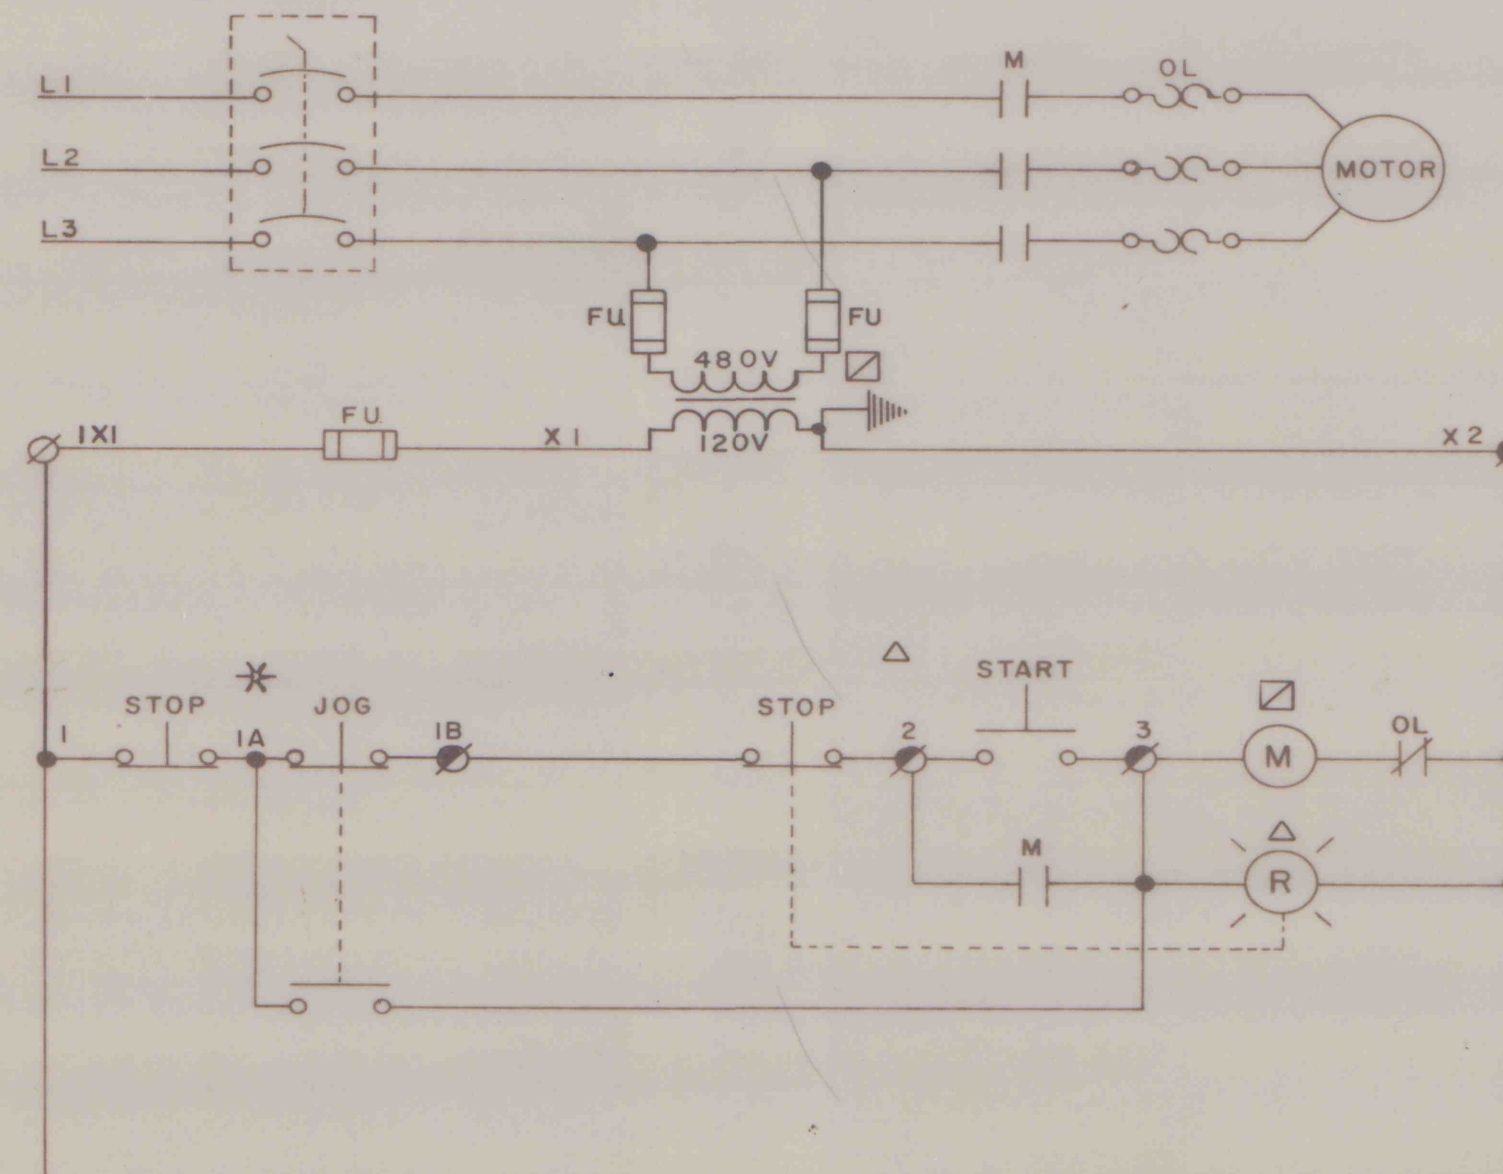


UNIT	DESCRIPTION	HP	MCC
15A	DUST COLLECTOR SCREW CONVEYOR	3	SH-1

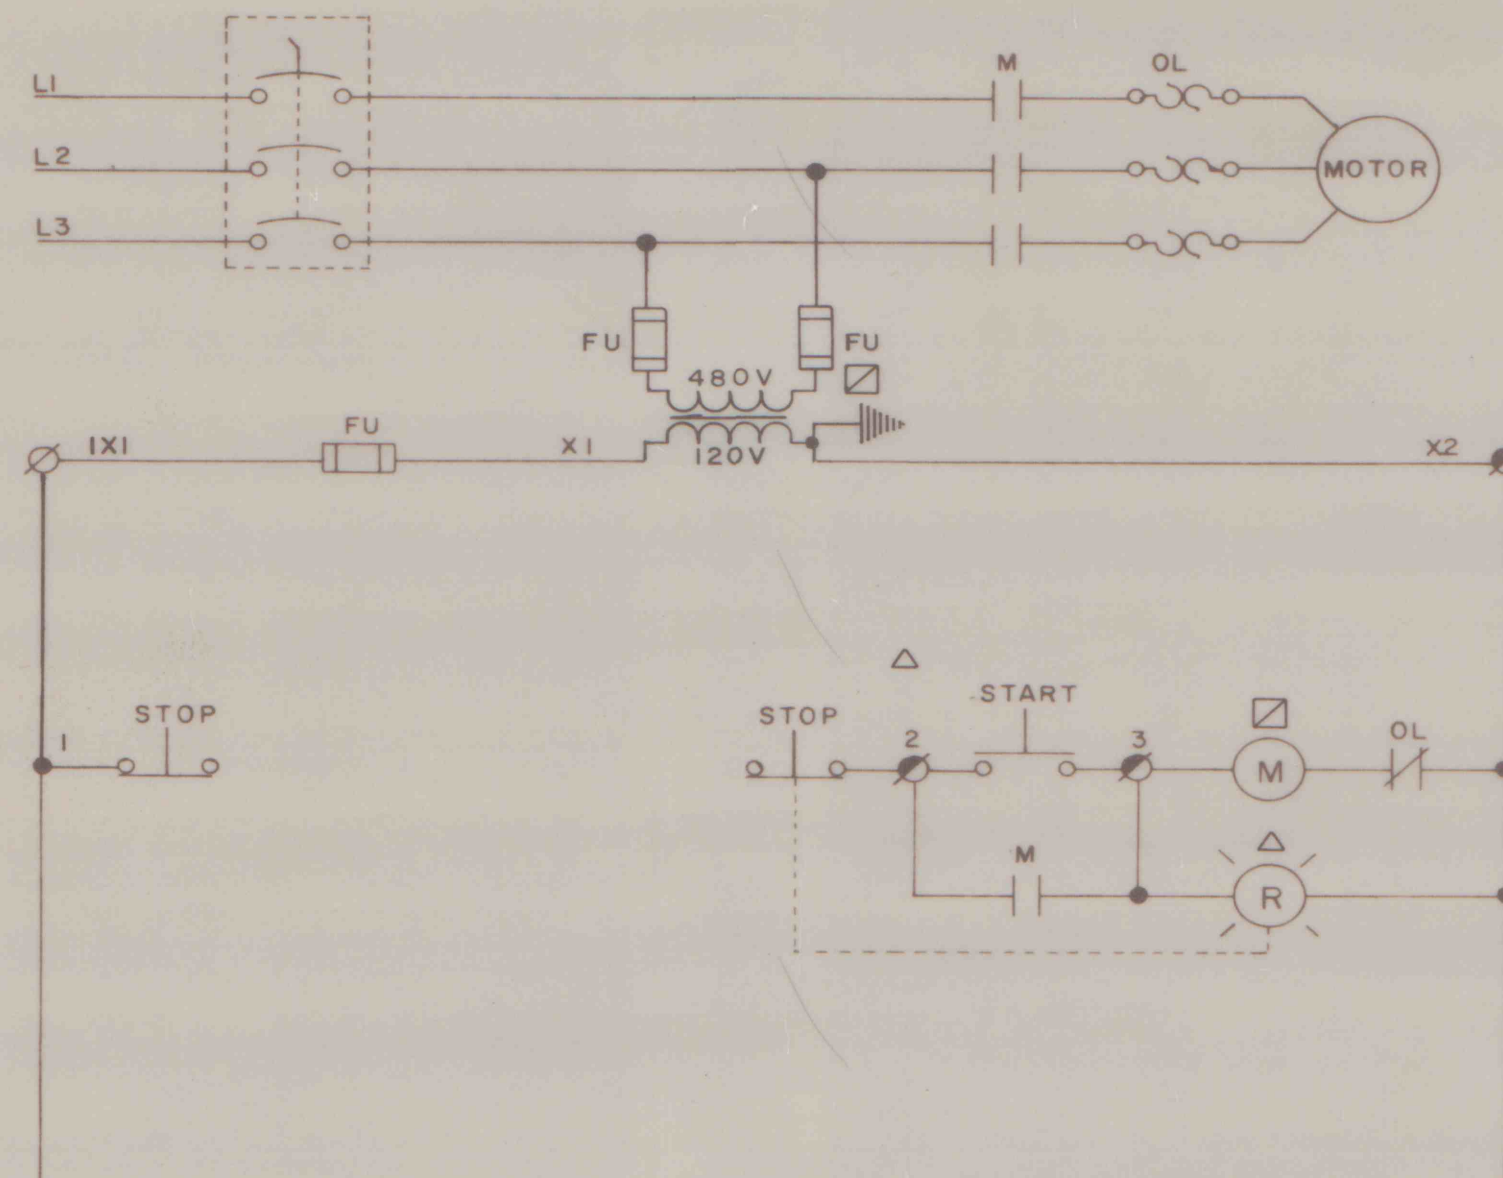


UNIT	DESCRIPTION	HP	MCC

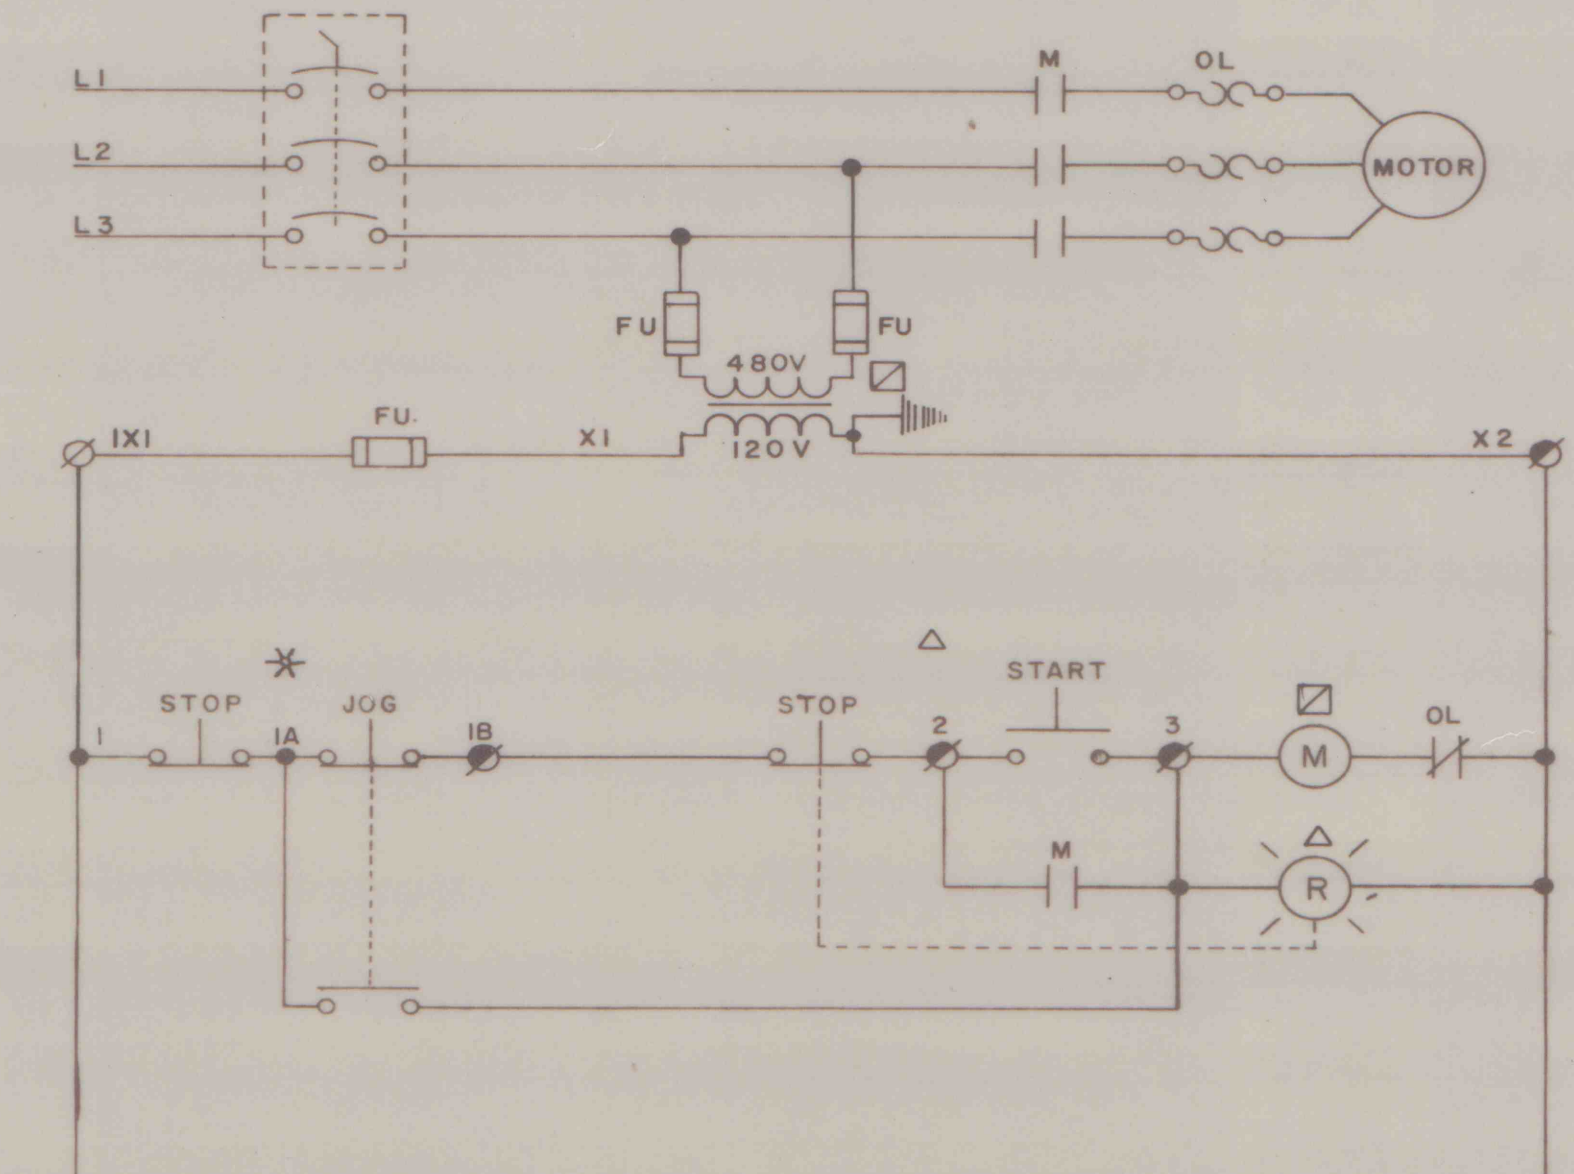

UNIT	DESCRIPTION	HP	MCC
15B	DUST COLLECTOR ROTARY AIR LOCK	1 1/2	SH-1

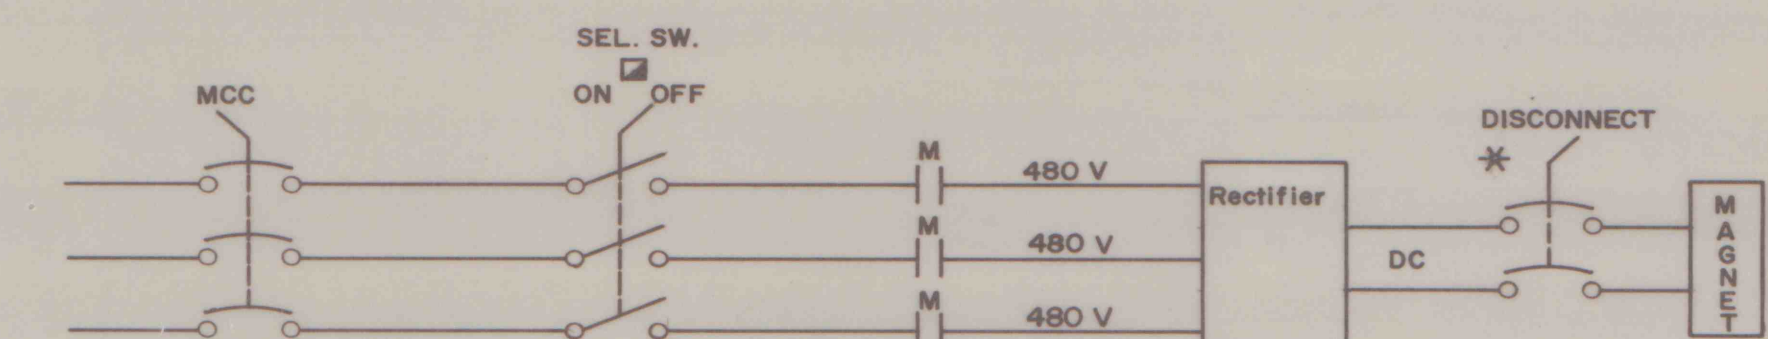

LIGHT PANEL CKT NO. 16

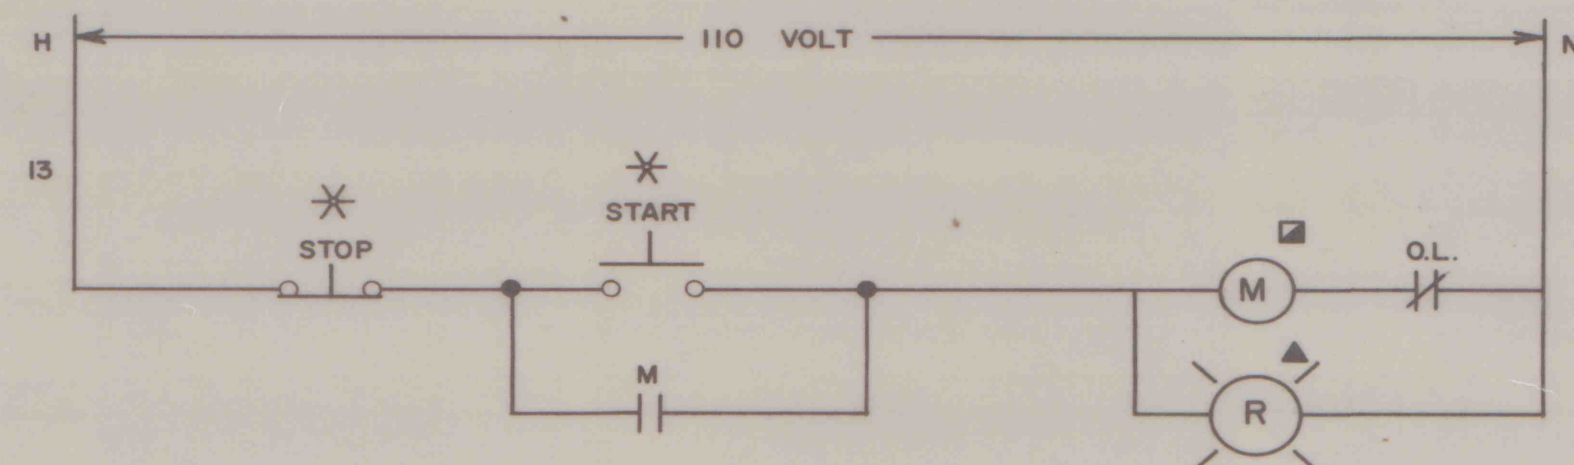

UNIT	DESCRIPTION	HP	MCC
1	MAGNET	SKW	SH

E-15	DELETE INTERLOCK IN DISC. SW.	1	7-15-82	LM
	REVISION	2	5/16/83	LM
	FOR APPROVAL		4/22/82	JK
DWG. NO.	REFERENCE	NO.	DATE	BY
BLAIR ELECTRIC SERVICE CO. BELLWOOD, PENNSYLVANIA R & P COAL CO. - KEYSTONE PLANT SCHEMATIC DIAGRAMS DRAWN JK DATE 1/14/82 ORDER NO. W-7478 CHECKED DATE SCALE APPROVED DATE				
DWG. NO. E-15 12303-71				