

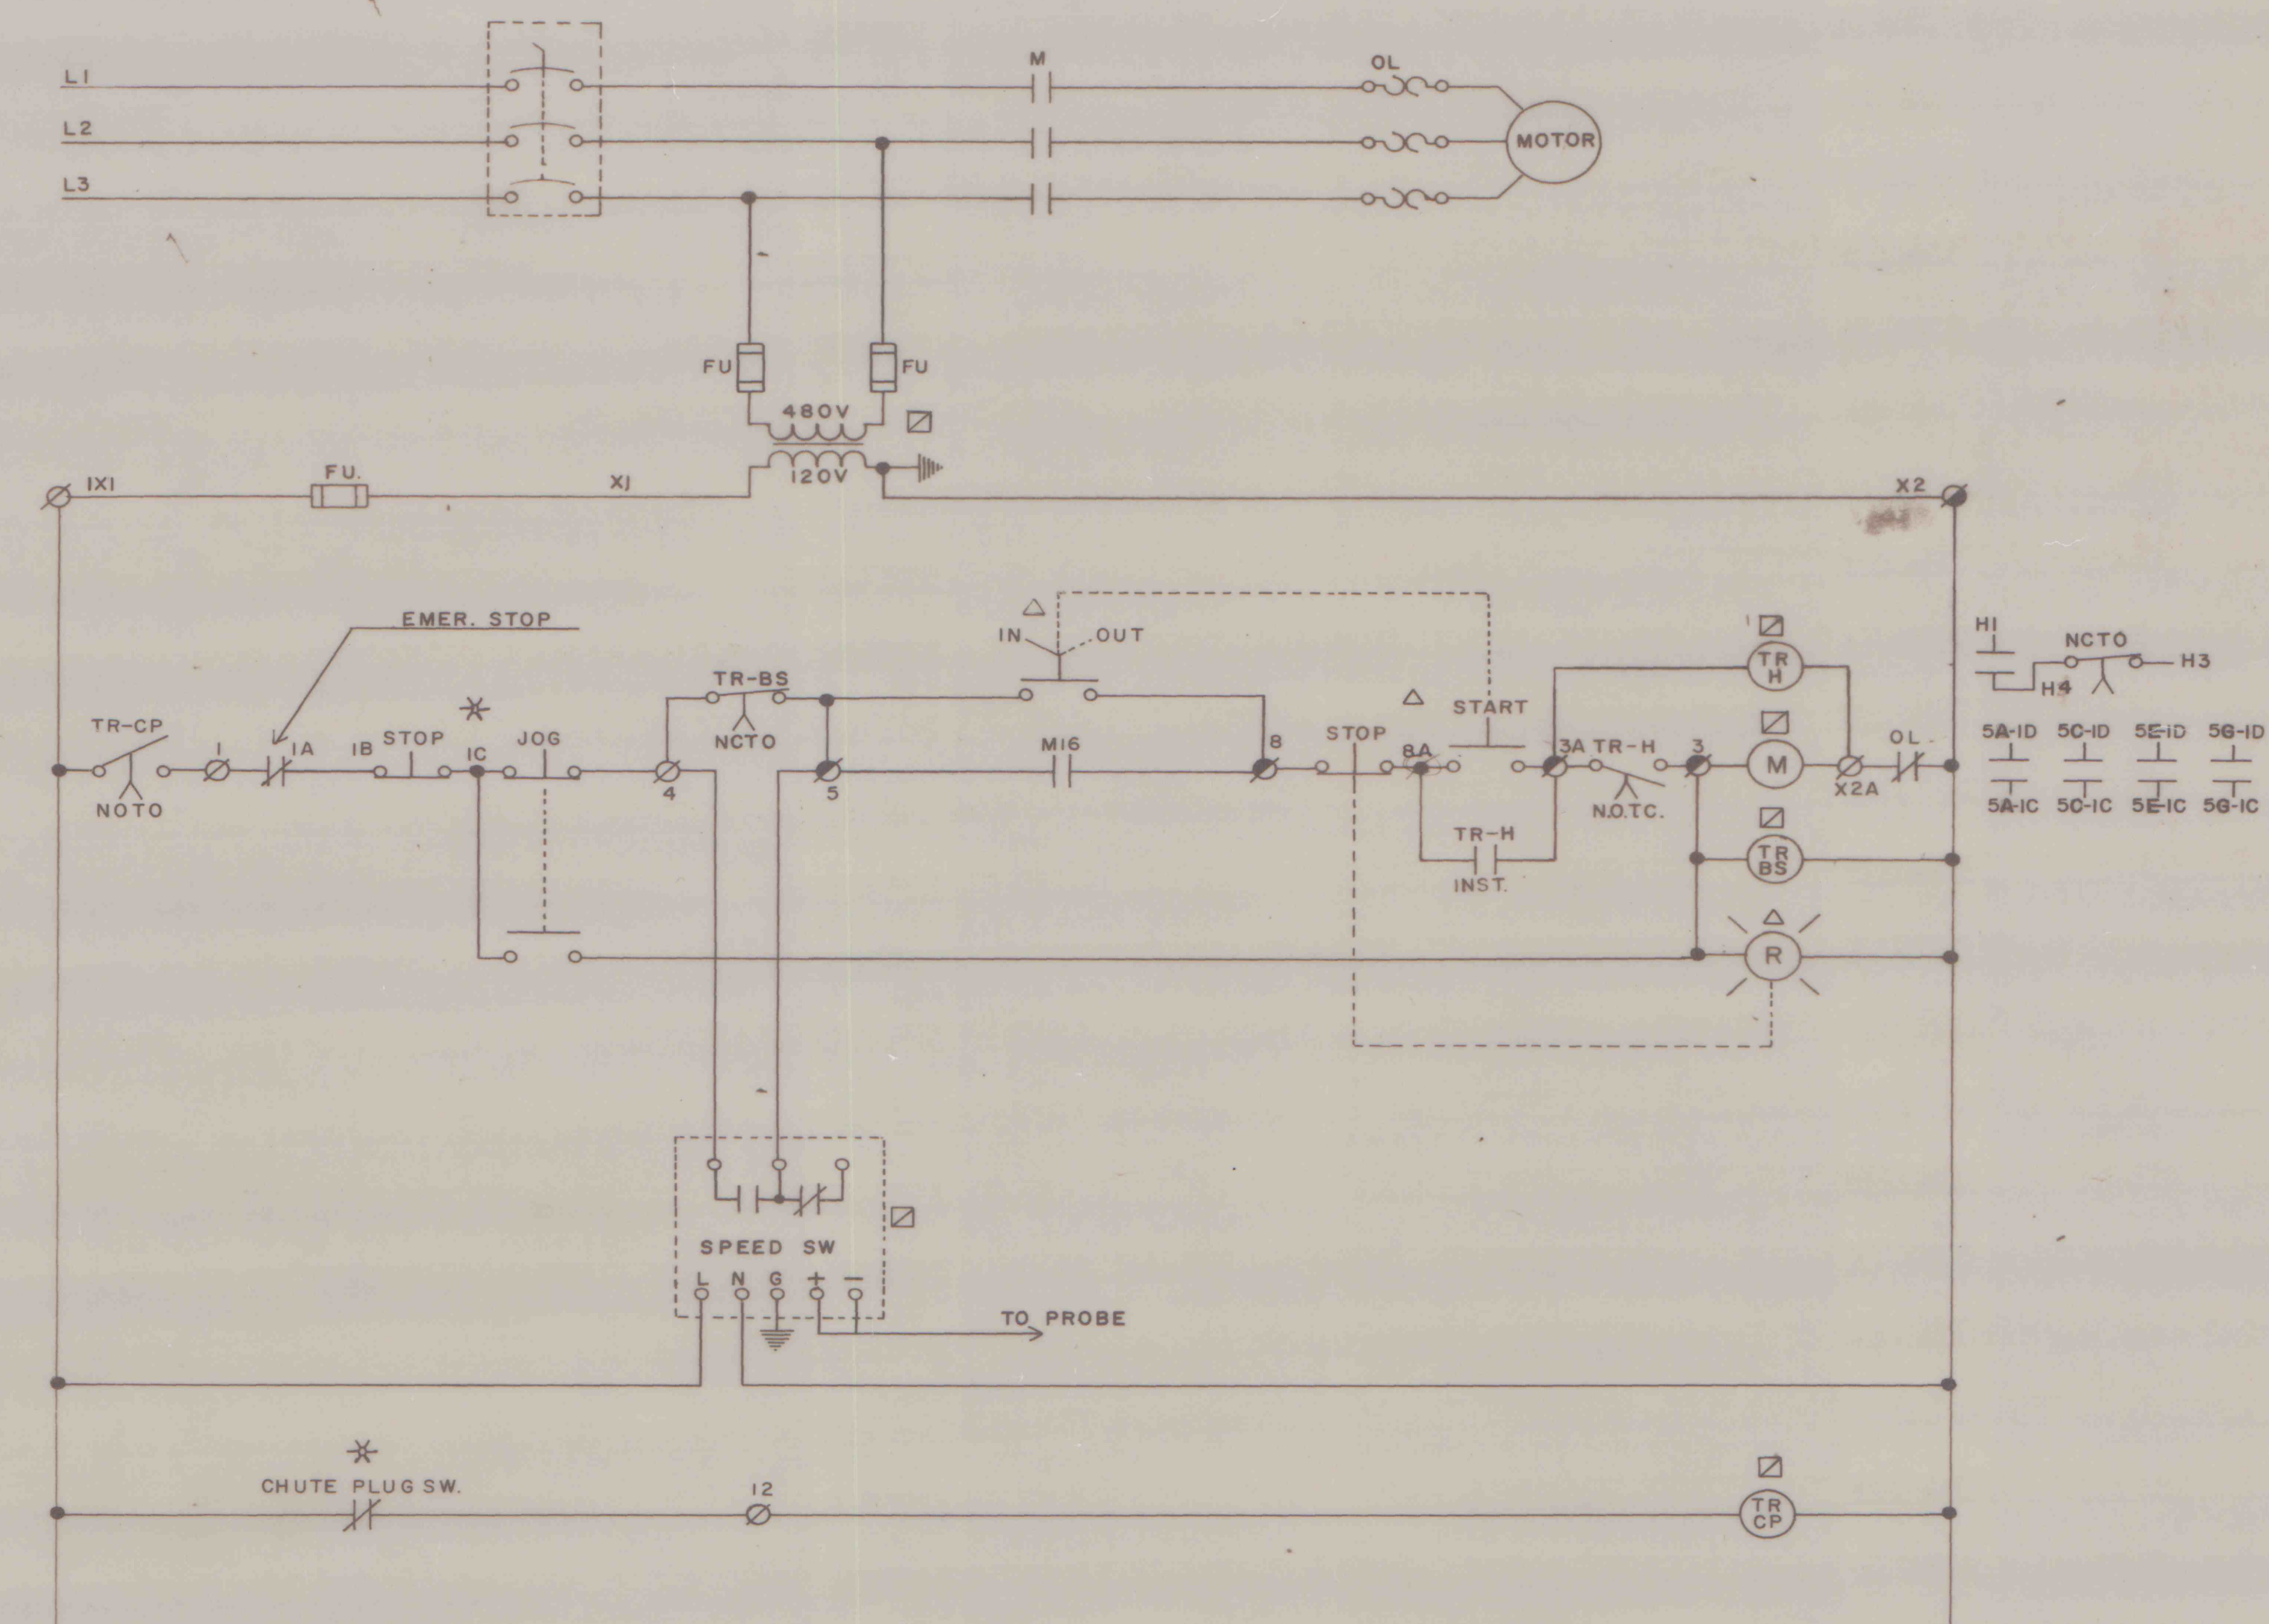


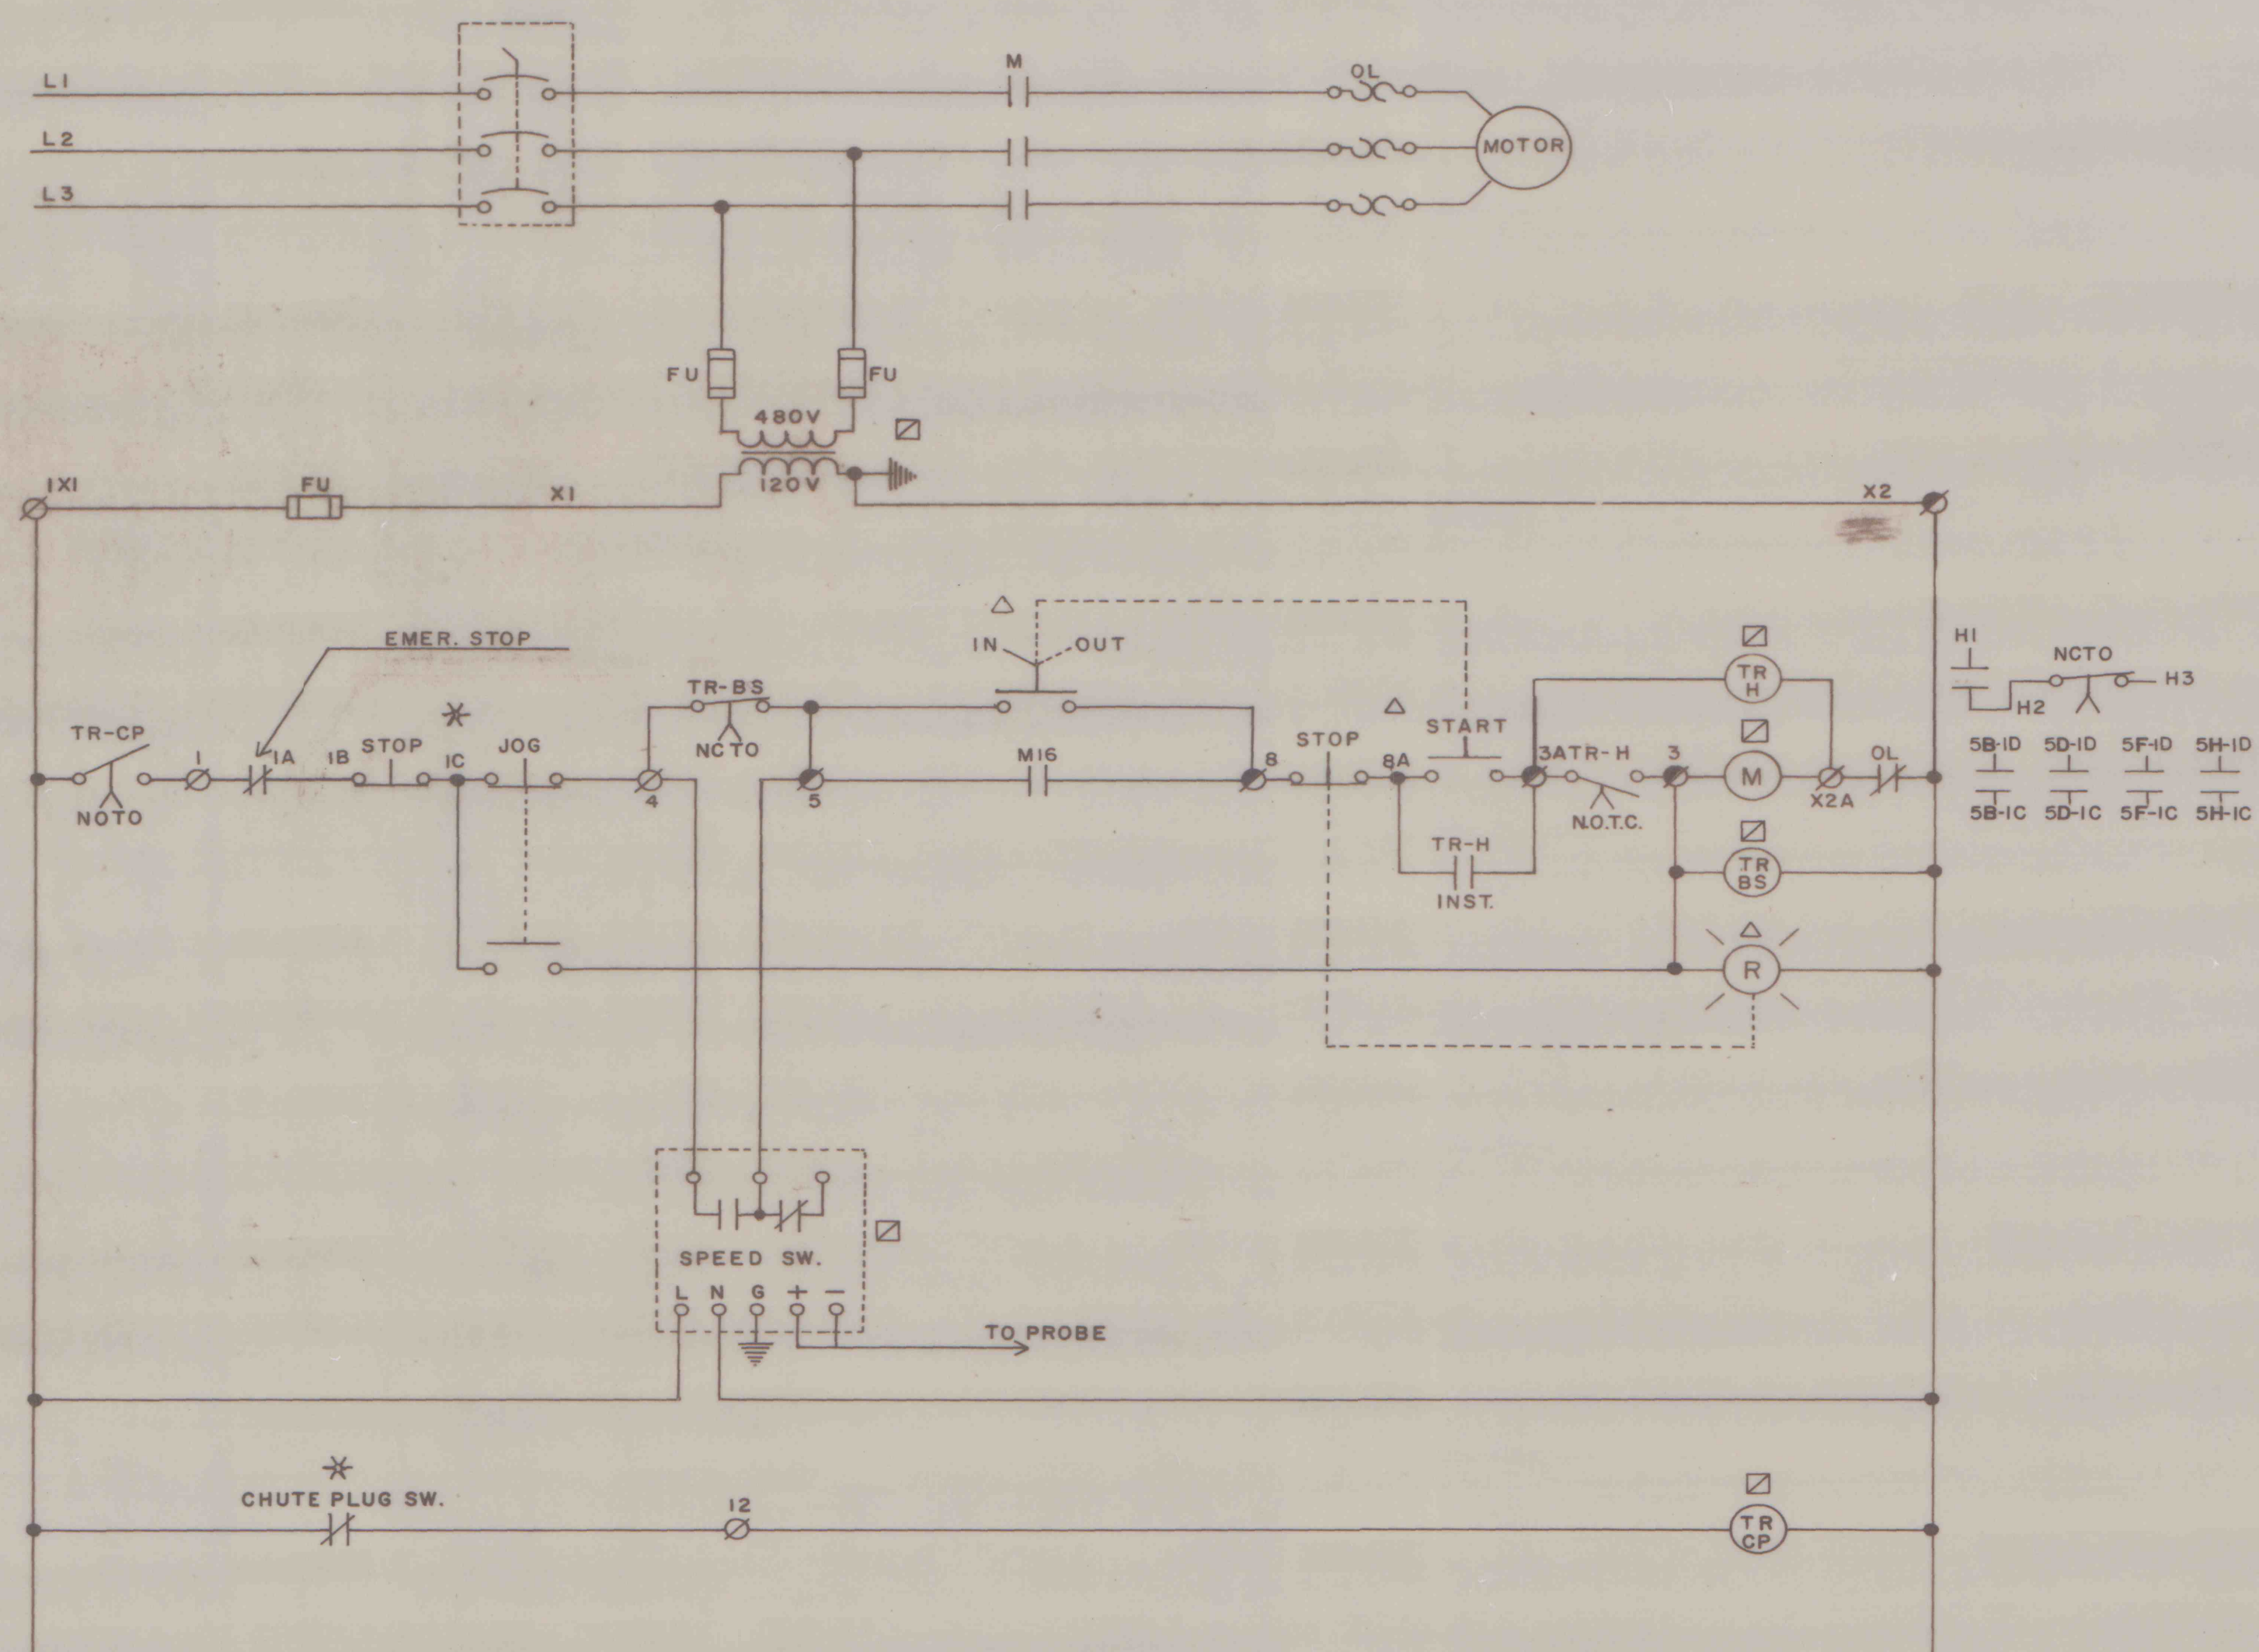

UNIT	DESCRIPTION	HP	MCC
11	FINES CONVEYOR NO. 3	10	SH-1

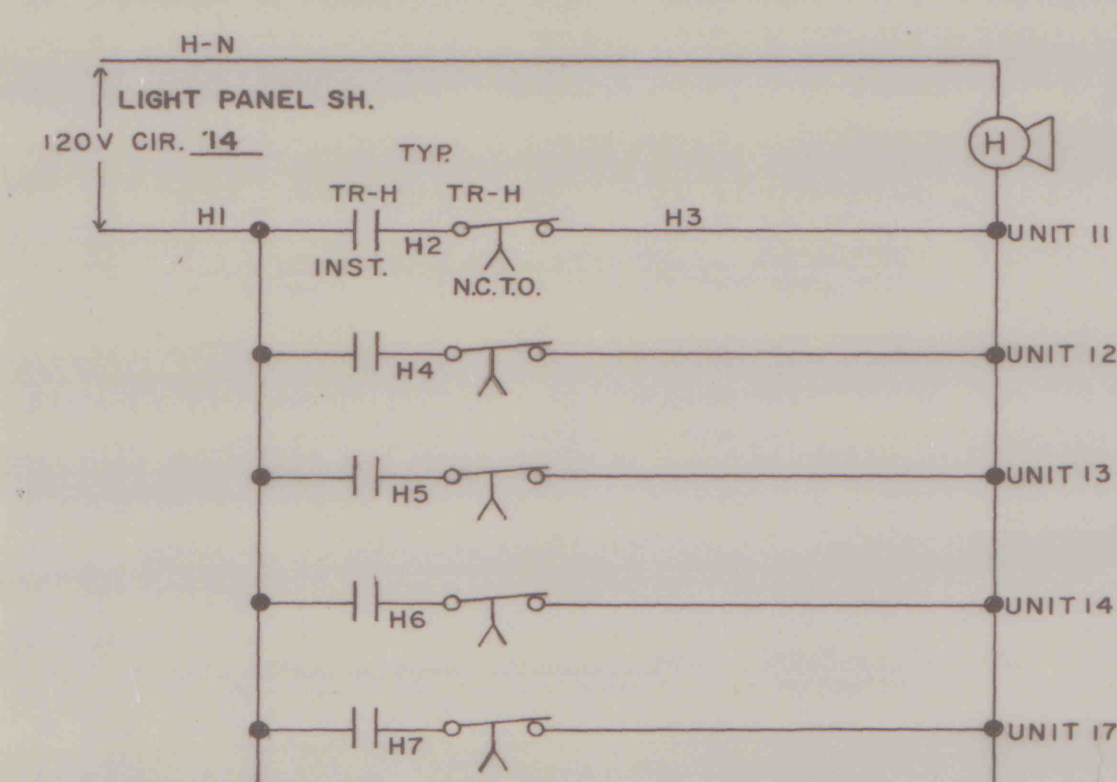

UNIT	DESCRIPTION	HP	MCC
12	FINES CONVEYOR NO. 5	10	SH-1

E - 18	DELETE INTERLOCK IN DISC. SW.	1	7-15-82	ldM
	REVISION	2	5/19/83	ldM
	FOR APPROVAL	(1)	4/25/82	JK
DWG. NO.	REFERENCE	NO.	DATE	BY
				attached
BLAIR ELECTRIC SERVICE CO.				
BELLWOOD, PENNSYLVANIA				
R & P COAL CO. - KEYSTONE PLANT				
SCHEMATIC DIAGRAMS				
DRAWN JK	DATE 1/14/82	ORDER NO.	W-7478	
CHECKED	DATE	SCALE	1/2	
APPROVED	DATE	DWG. NO. E-18		