


UNIT	DESCRIPTION	HP	MCC
18	PLANT FEED CONVEYOR NO.9	60	P3

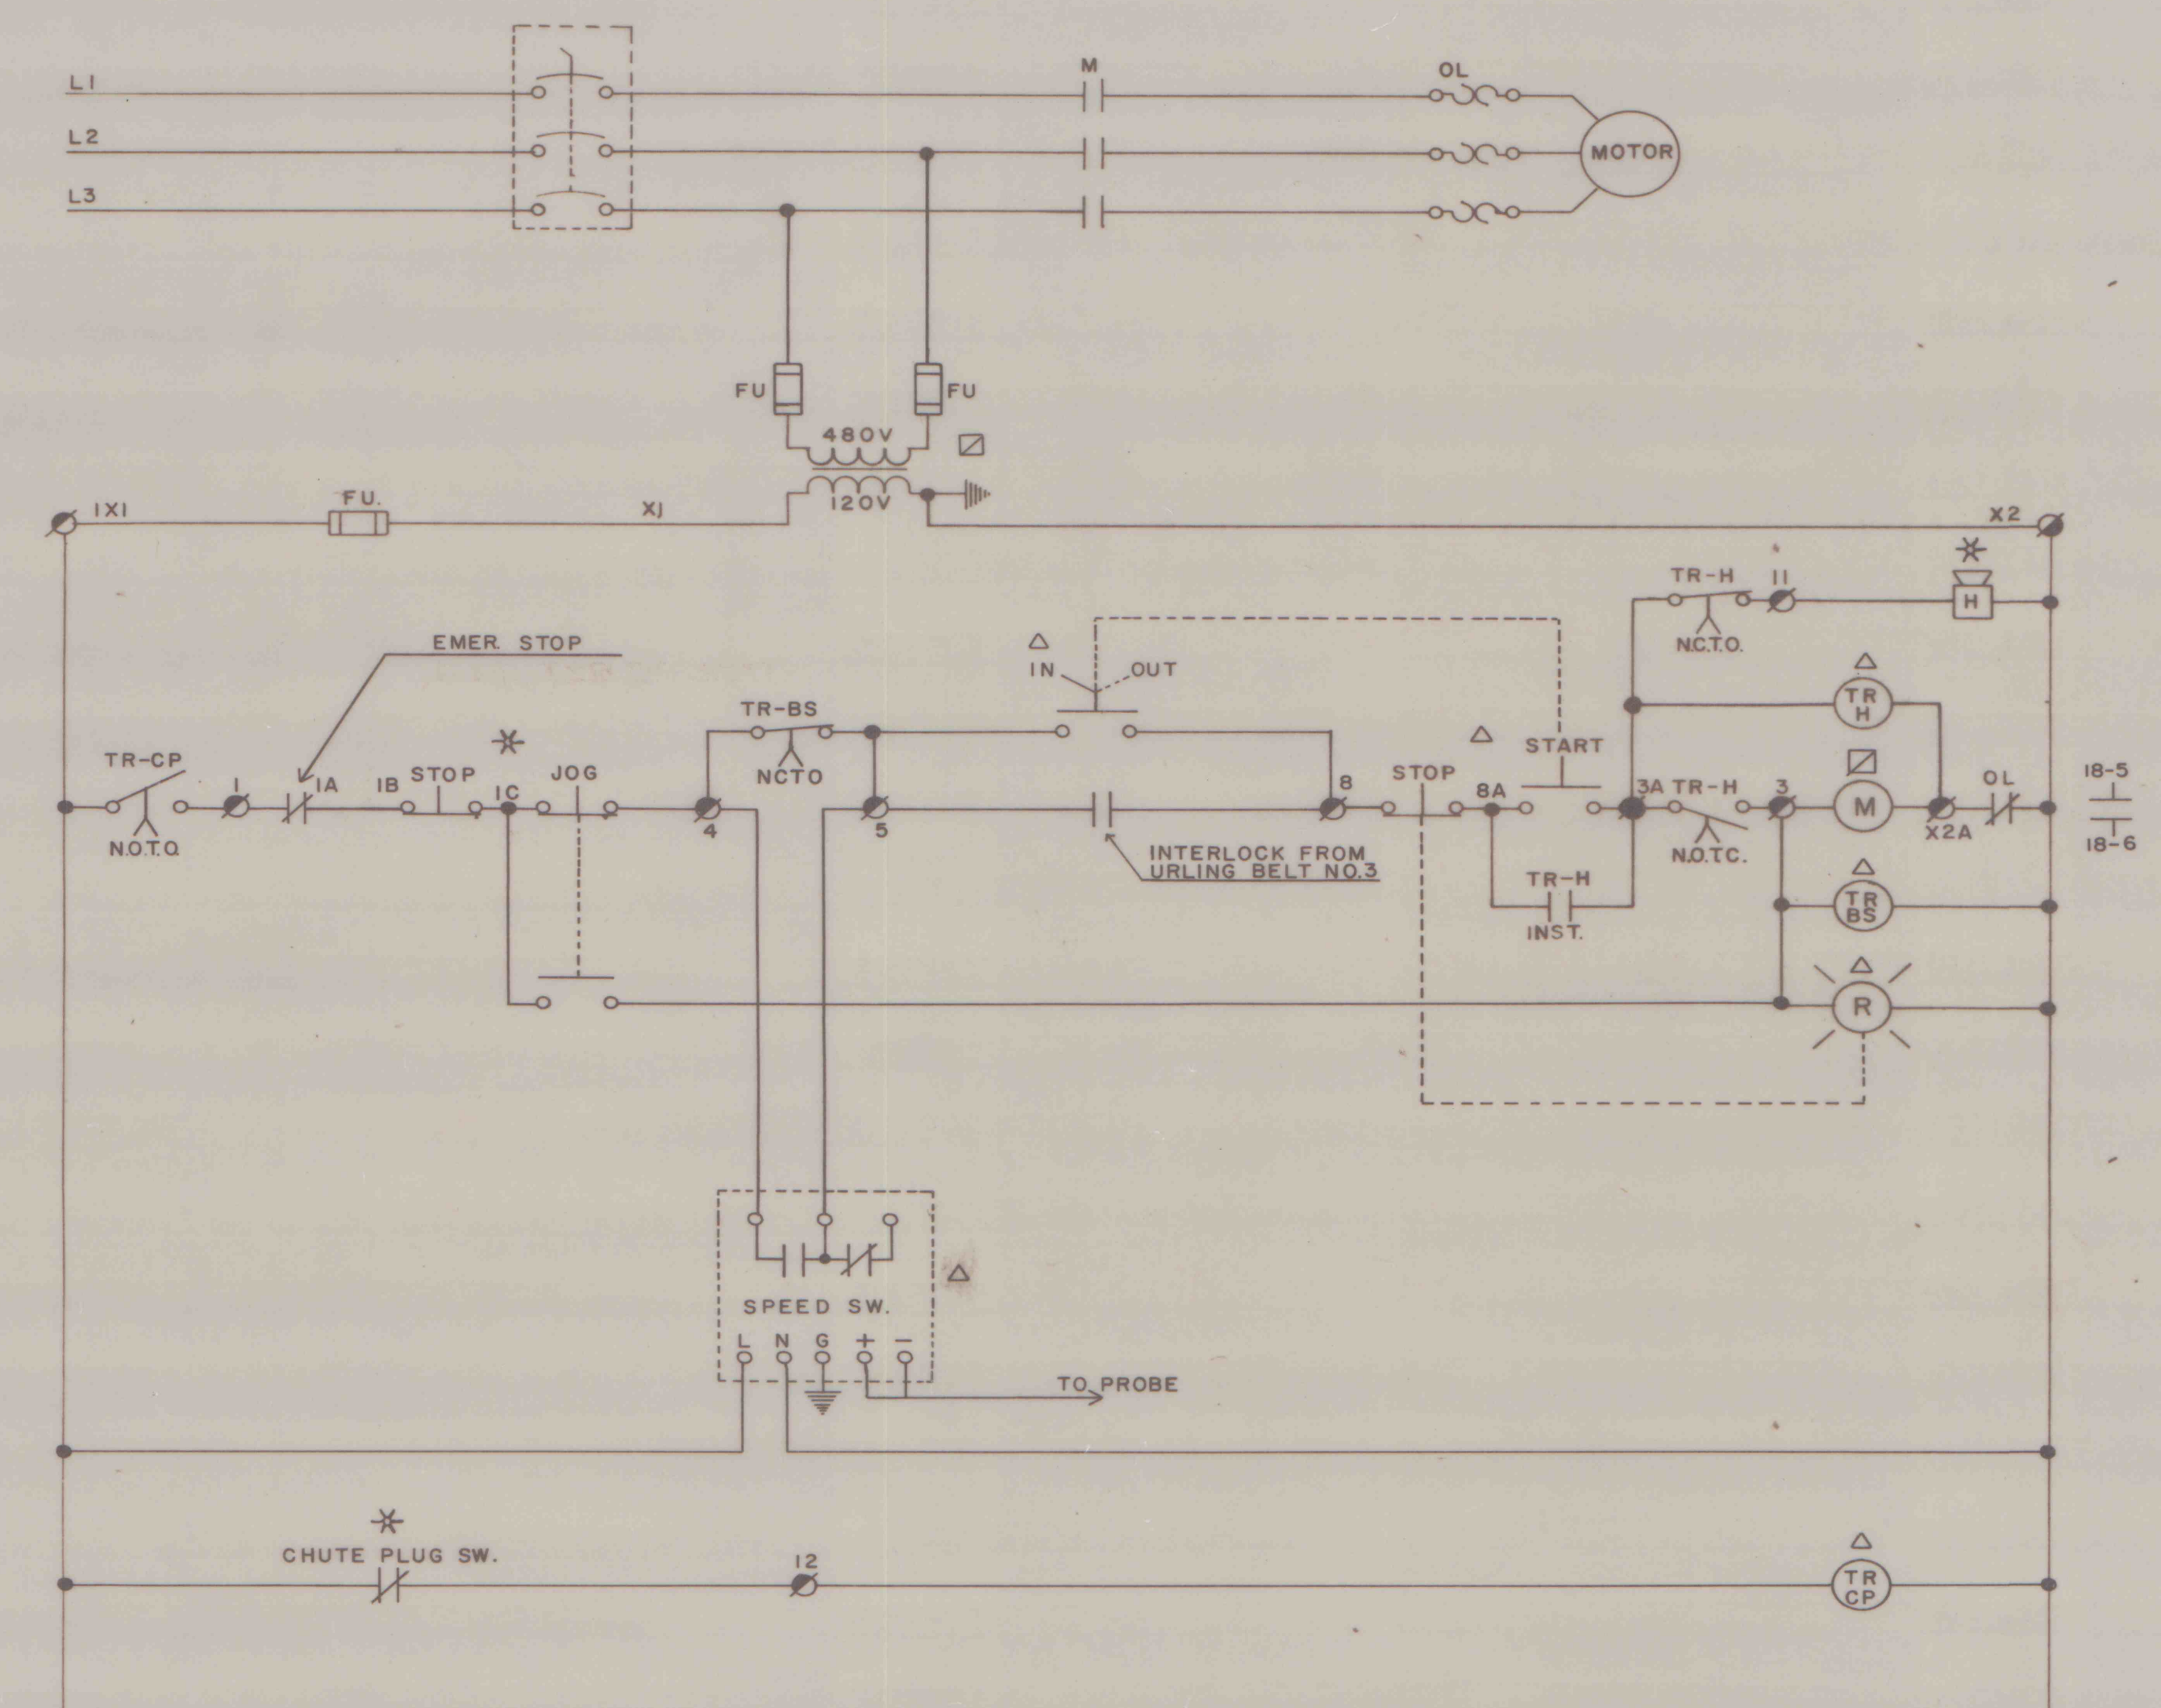

UNIT	DESCRIPTION	HP	MC
19	PLANT BY-PASS CONVEYOR NO.10	10	P3

E-24	DELETE INTERLOCK IN DISC. SW.	1	7-15-82	LDW
	REVISION	2	5/13/83	LDW
	FOR APPROVAL	①	5/5/82	JK
DWG. NO.	REFERENCE	NO.	DATE	BY

BLAIR ELECTRIC SERVICE CO.

BELLWOOD, PENNSYLVANIA

R & P COAL CO.—KEYSTONE PLANT

SCHEMATIC DIAGRAMS

DRAWN JK	DATE 1/14/82	ORDER NO. W-7478
CHECKED	DATE	SCALE 
APPROVED		
DATE		DWG. NO. E-24

12303-71