




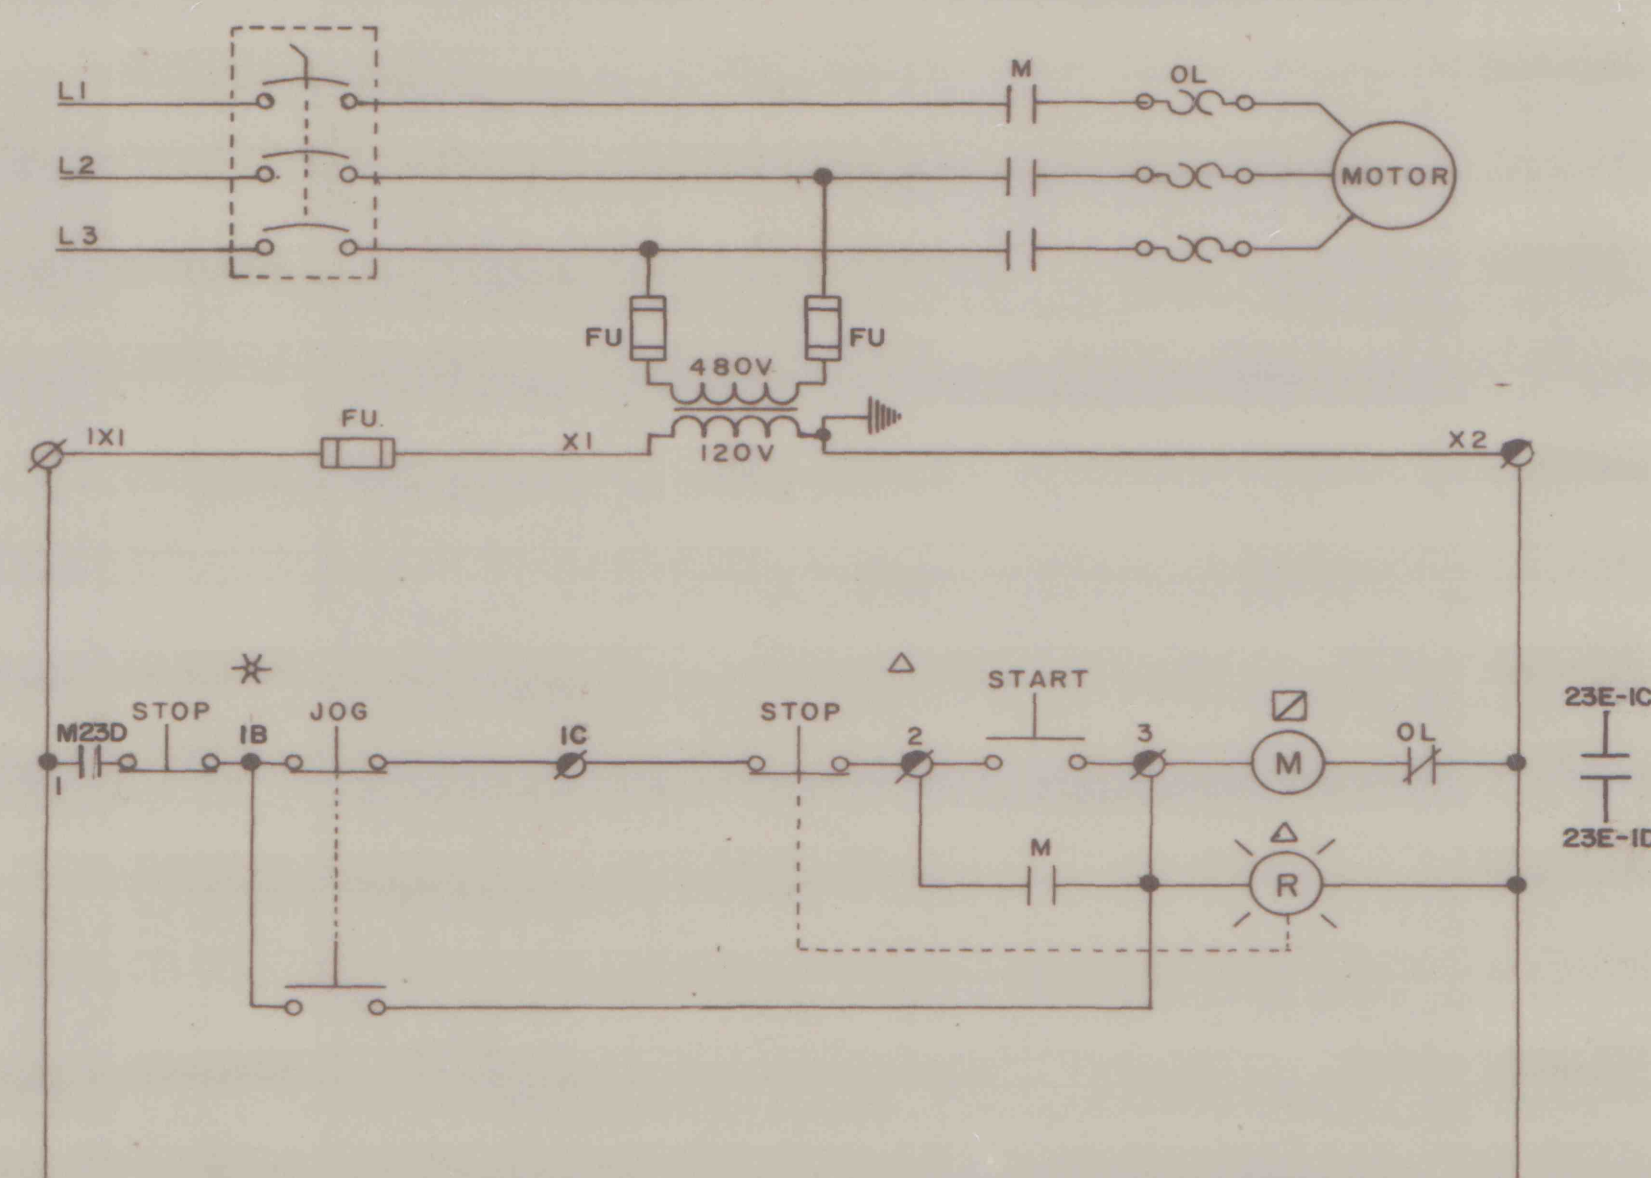


UNIT	DESCRIPTION	HP	MCC
23F	DRYER CENTRIFUGE NO. 2 DRIVE	30	P3

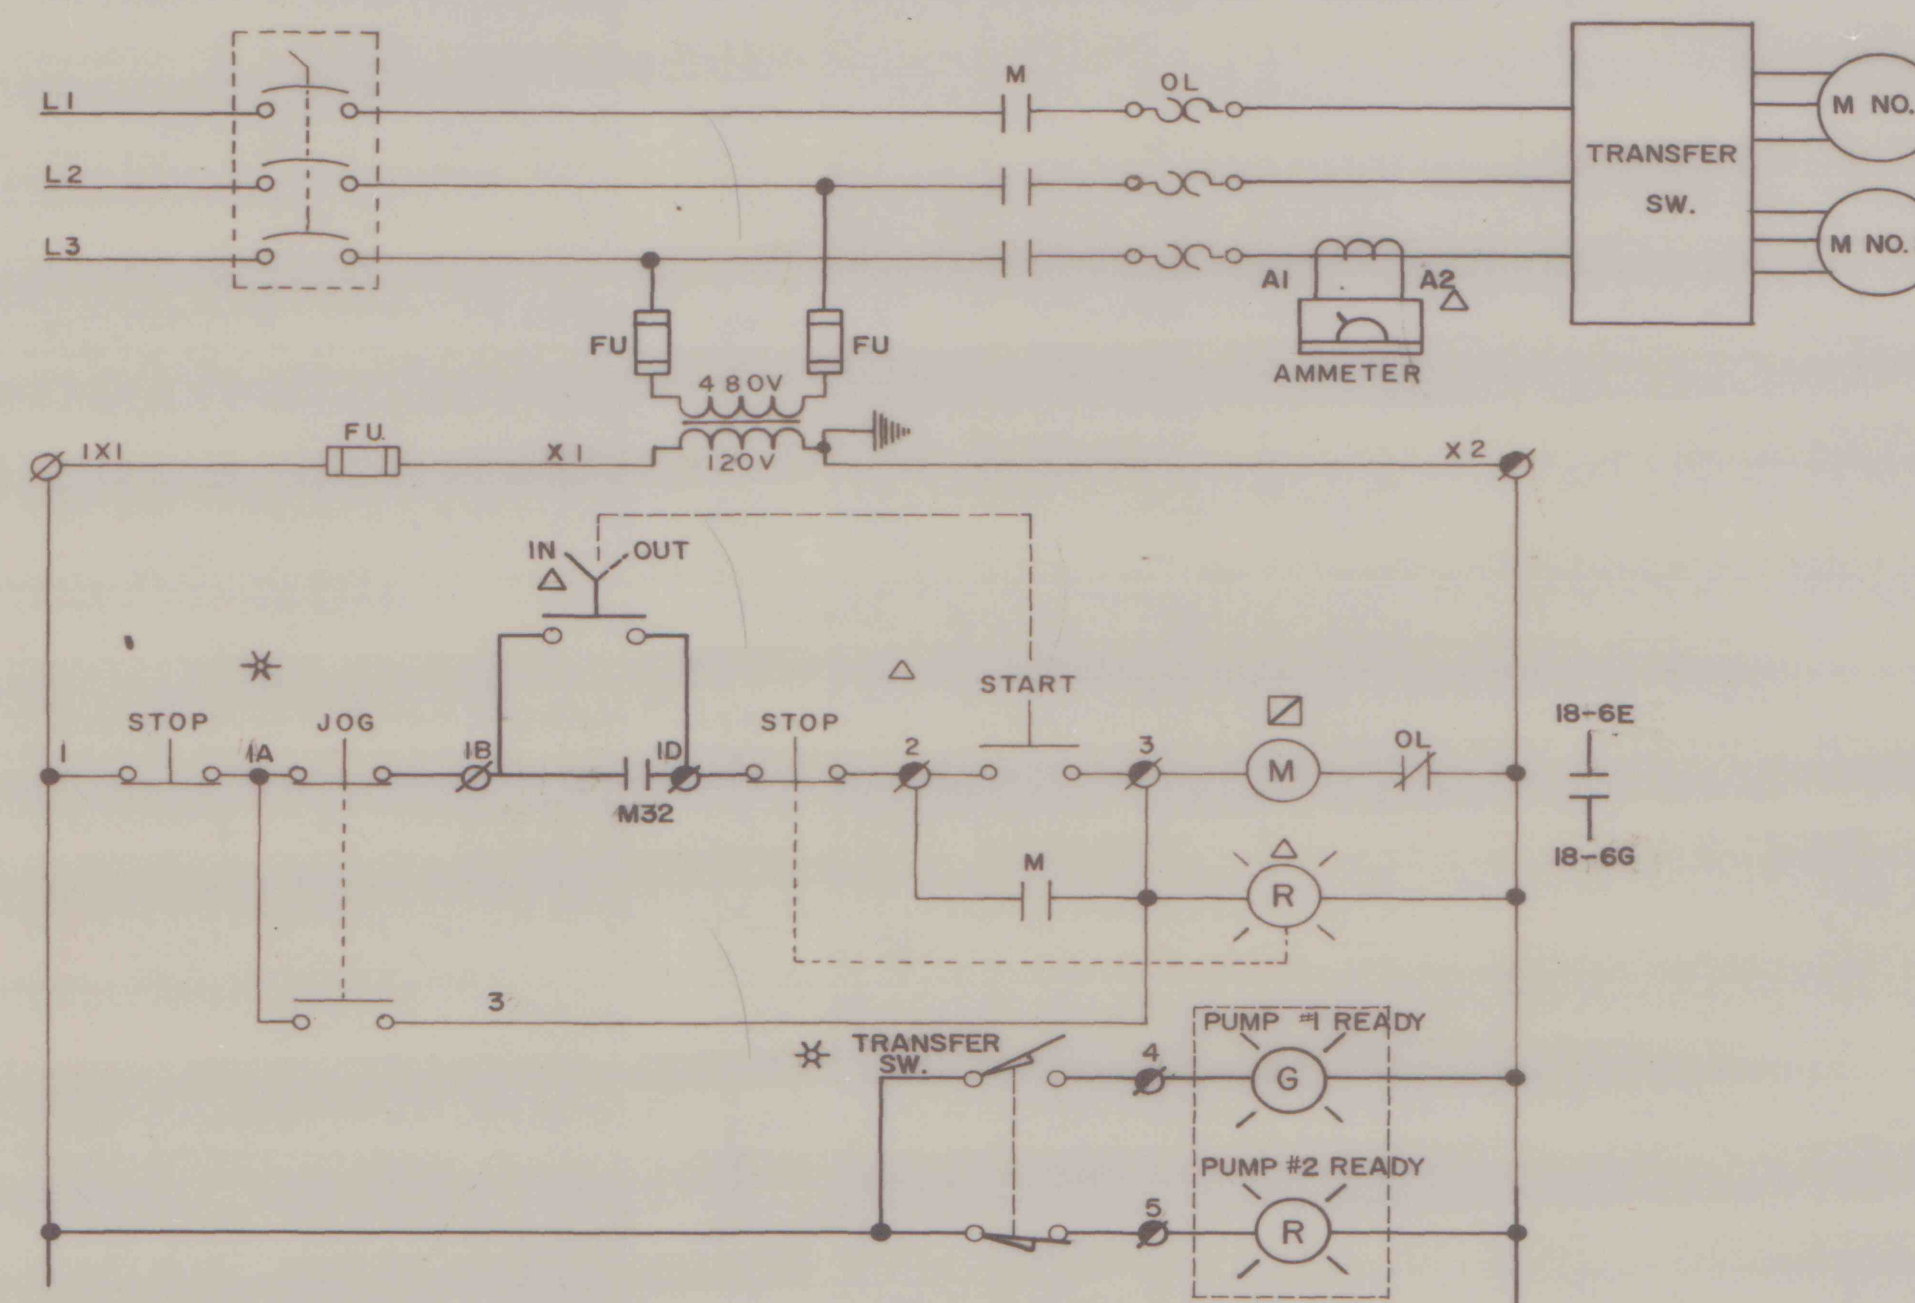


UNIT	DESCRIPTION	HP	MCC
24A	CYCLONE PUMPS	200	P3
24B	CYCLONE PUMPS	200	P3

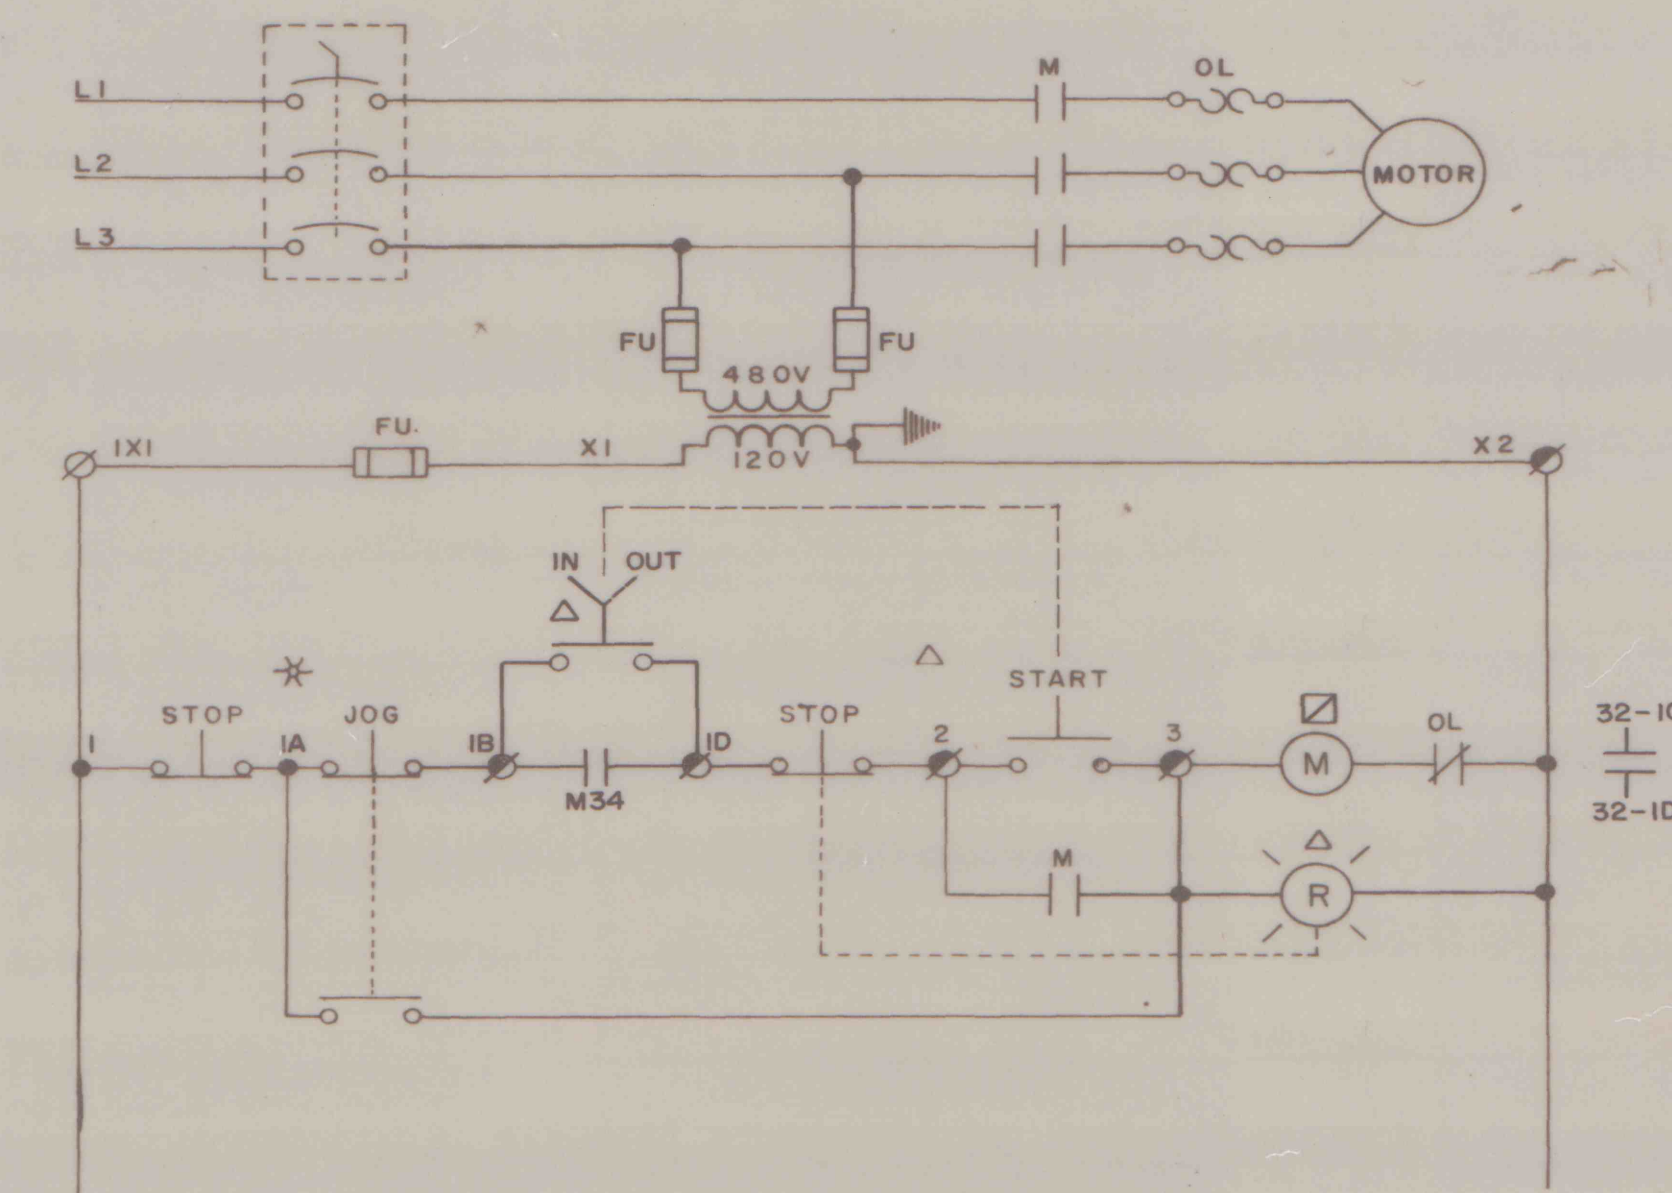

UNIT	DESCRIPTION	HP	MCC
26	FINES DEWATERING SCREEN	5	P3

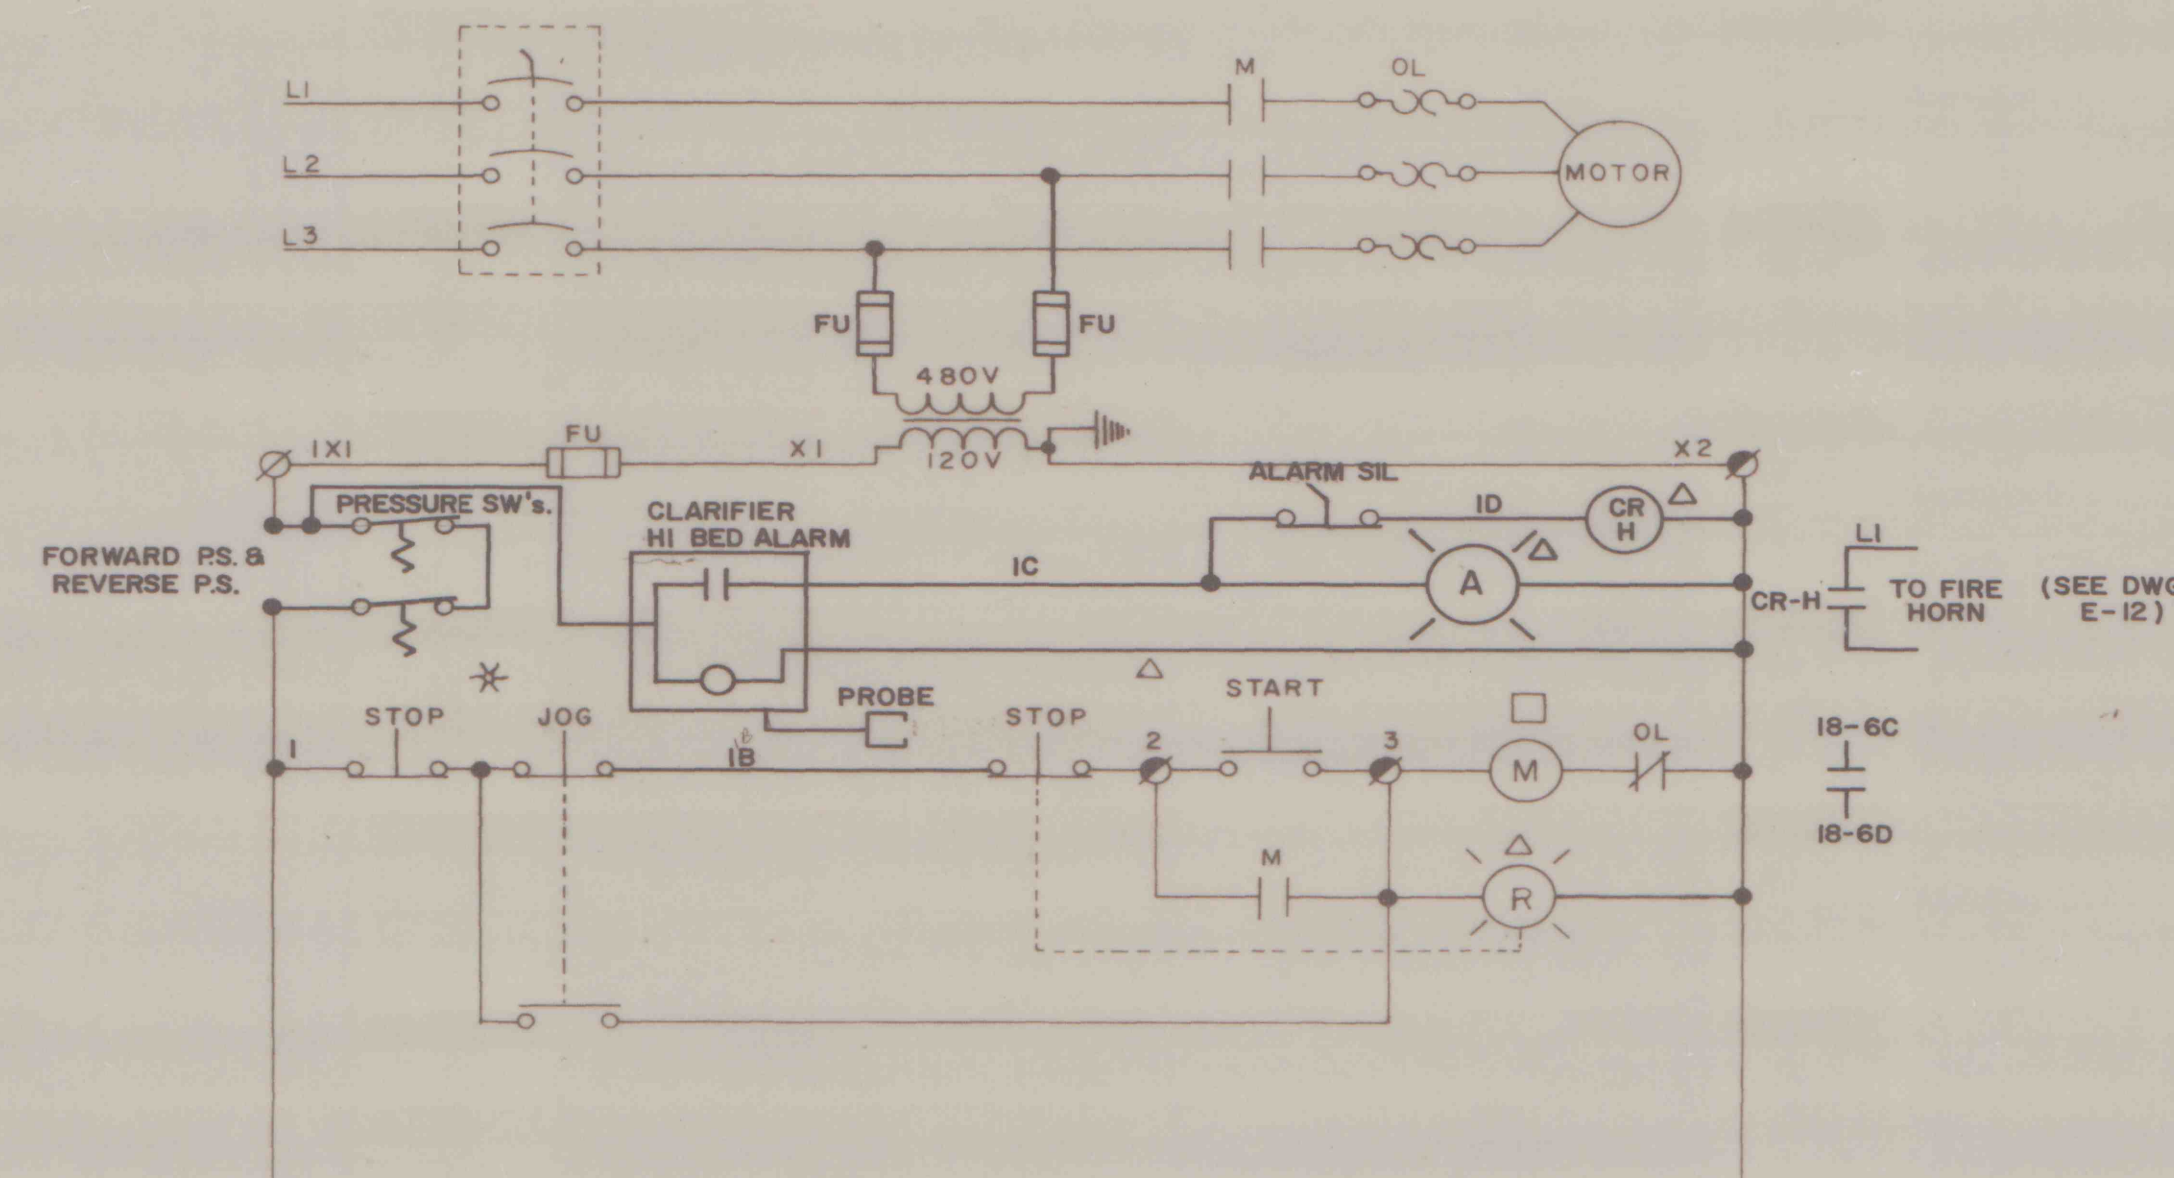

UNIT	DESCRIPTION	HP	MCC
28	CLARIFIER RAKE		

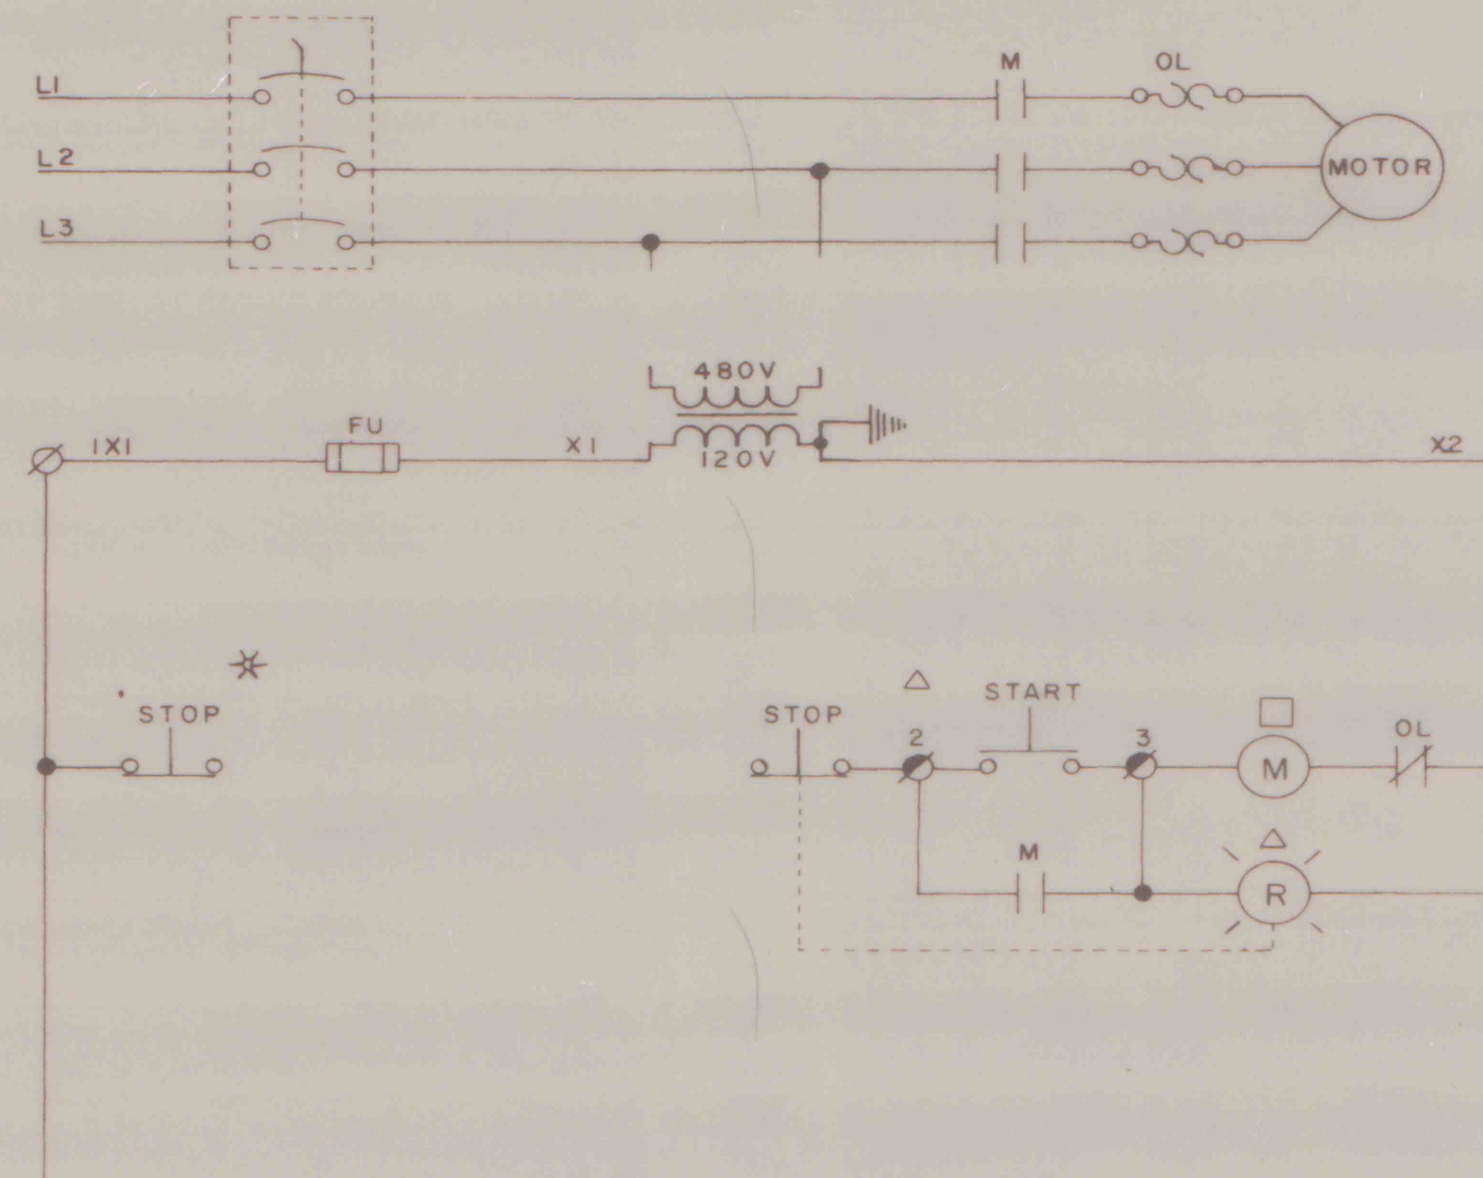

UNIT	DESCRIPTION	HP	MCC

REVISION	1	5/17/83	LDM
FOR APPROVAL	0	7-14-82	LDM
DWG. NO.	REFERENCE	NO.	DATE
BLAIR ELECTRIC SERVICE CO. BELLWOOD, PENNSYLVANIA R & P COAL CO. - KEYSTONE PLANT ELECTRICAL SCHEMATICS DRAWN: JK DATE: 7/14/82 ORDER NO.: W-7478 CHECKED: DATE: SCALE: APPROVED: DWG. NO. E-28 DATE:			